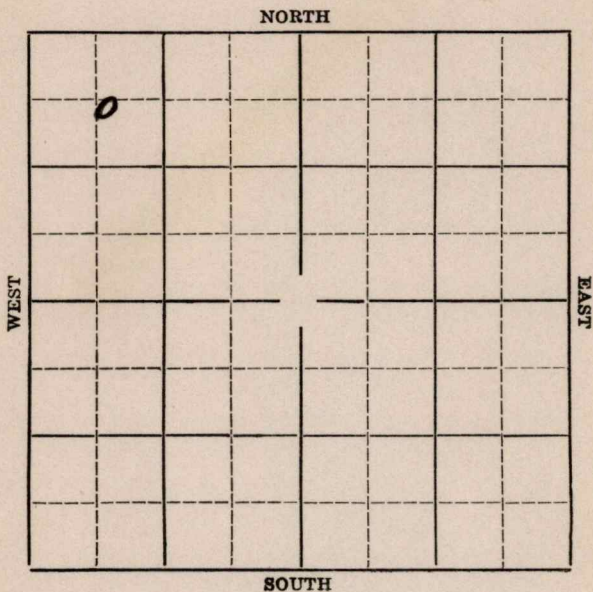


Section 16 Township 24 Range 12-EWell Number #6-JohnsonCompany Shull Dlg.

KANSAS

Map No. _____ Sec. 16 Twp. 24 R. 12E

Well No. 6. Johnson.

Shull H. H. Company

Contractor

SECTION PLAT

0			

740 Ft. from N. Line

_____ Ft. from S. Line

_____ Ft. from E. Line

740 Ft. from W. Line

CORRECTION

Location _____

Rig up _____

Drilling and Remarks:

Spud

First
Repairs

RECORD

Cased _____ in., _____ ft.

Sand _____

Gas _____

Oil _____

Total Depth _____

PRODUCTION

1st 24 hrs. Nat. _____

1st 24 hrs. after shot _____

Gas _____ Cu. Ft.

Dry Hole _____

Abandoned _____

Date

8/12/36 19

J. Lewis Scout

KANSAS

Map No. _____ Sec. 16 Twp. 24 R. 12E

Well No. 5 Johnson

Shull & Co. Company

Contractor

SECTION PLAT

0			

740 Ft. from N. Line

_____ Ft. from S. Line

_____ Ft. from E. Line

740 Ft. from W. Line

FIRST REPORT

Location _____

Rig up _____

Drilling and Remarks:

Spud
I send in correction
on this well on
aug 19th.

RECORD

Cased _____ in., _____ ft.

Sand _____

Gas _____

Oil _____

Total Depth _____

PRODUCTION

1st 24 hrs. Nat. _____

1st 24 hrs. after shot _____

Gas _____ Cu. Ft.

Dry Hole _____

Abandoned _____


Date

AUG 12 1936 19

S. J. LEWIS

Scout

Sam - Please have scout check
well # on this ticket as
our tracing shows that
there is already a #5
in SW NE NW sec 16-24-12E

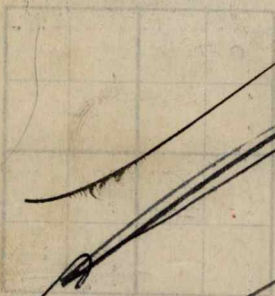

Returned Sh	Returned Sh
Cards Sh	Cards Sh
Tracing Sh	Tracing Sh
France Map Sh	France Map Sh
Scarborough Map Sh	Scarborough Map Sh
Moody Map Sh	Moody Map Sh
Scarborough Plat Book Sh	Scarborough Plat Book Sh
Moody Plat Book Sh	Moody Plat Book Sh

Brewerwood
 Map No. 16 Sec. 16 Twp. 24 R. 12 E

Well No. 6 Johnson

Shall It be Company

Contractor

SECTION PLAT

0			

740 Ft. from N. Line

_____ Ft. from S. Line

_____ Ft. from E. Line

740 Ft. from W. Line

FIRST REPORTS
CORRECTION

Location _____

Rig up _____

Drilling and Remarks:

*Reported
as No 5*

RECORD

Cased _____ in., _____ ft.

Sand _____

Gas _____

Oil _____

Total Depth _____

PRODUCTION

1st 24 hrs. Nat. _____

1st 24 hrs. after shot _____

Gas _____ Cu. Ft.

Dry Hole _____

Abandoned _____

Date

AUG 19 1936 19

S. J. LEWIS

Scout

KANSAS

Map No. 16ⁿ Sec. 16 Twp. 24 R. 12EWell No. 6 JohnsonCompany Shull H & Co

Contractor

SECTION PLAT

0			

740 Ft. from N. Line

_____ Ft. from S. Line

_____ Ft. from E. Line

740 Ft. from W. Line

ABANDONED

Location _____

Rig up _____

Drilling and Remarks:

Miss L. 1791XFWIXA

RECORD

Cased _____ in., _____ ft.

Sand _____

Gas _____

Oil _____

Total Depth 1820

PRODUCTION

1st 24 hrs. Nat. _____

1st 24 hrs. after shot _____

Gas _____ Cu. Ft.

Dry Hole _____

Abandoned _____

Date

SEP 2 1936

19

S. J. LEWIS Scout