

1002 K 11 Map No. _____ Sec. 2 Twp. 28 R. 4Well No. 11 Brant Farm _____Empire Company _____

NORTH

WEST

EAST

SOUTH

Location _____

Rig Up ✓ _____

Drilling and remarks _____

RECORD

Cased _____ in _____ Ft.

Sand _____

Gas _____

Oil _____

Total Depth _____

PRODUCTION

1st 24 hrs. Nat. _____

1st 24 hrs. after shot _____

Gas _____ Cu. Ft.

Dry Hole _____


Abandoned _____

Date

6/4, 1918 Cordery Scout

Map No. _____ Sec. 2 Twp. 38 R. 4Well No. 1113 GrantEssex CompanyMcIntosh Bros ContractorAugusta NORTH Ks

WEST

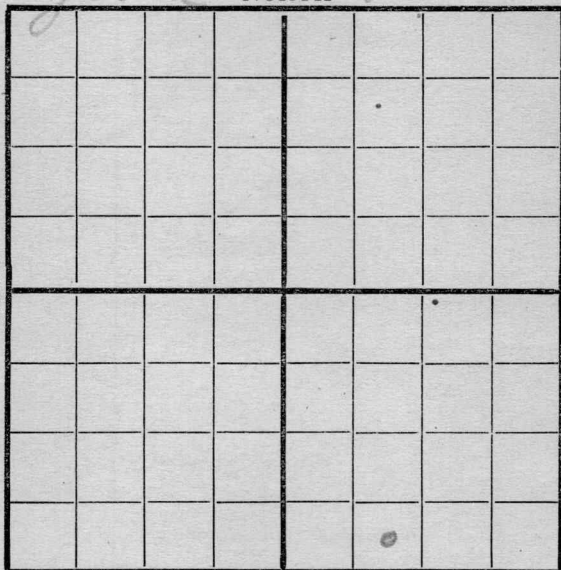

EAST

SOUTH

Location _____

Rig up _____

Drilling and Remarks:

Rigging up**RECORD**

Cased _____ in., _____ ft.

Sand _____

Gas _____

Oil _____

Total Depth _____

PRODUCTION

1st 24 hrs. Nat. _____

1st 24 hrs. after shot _____

Gas _____ Cu. Ft.

Dry Hole _____

Abandoned _____

Date

6/26 191 8 Corduff Scout


Map No. _____ Sec. 2 Twp. 28 R. 4Well No. 11 BrantCompany Amey

Contractor _____

NORTH

WEST

EAST

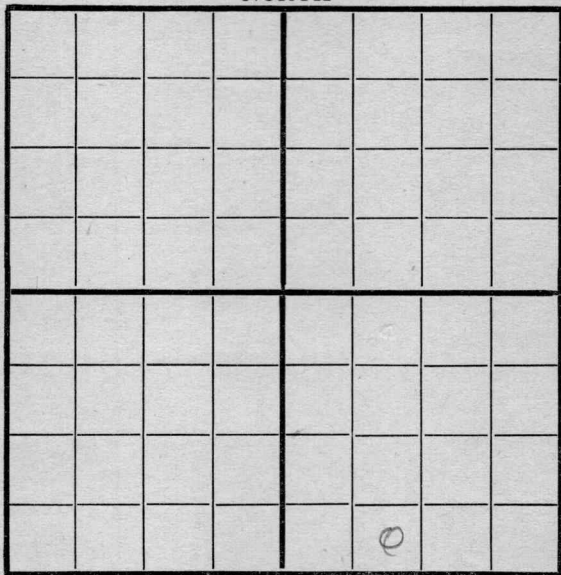

SOUTH

Location _____

Rig up _____

Drilling and Remarks:

175

RECORD

Cased _____ in., _____ ft.

Sand _____

Gas _____

Oil _____

Total Depth _____

PRODUCTION

1st 24 hrs. Nat. _____

1st 24 hrs. after shot _____

Gas _____ Cu. Ft.

Dry Hole _____

Abandoned _____

Date

7/3

191

Scout

Map No. _____ Sec. _____ Twp. _____ R. _____

Well No. 113

Company

Contractor

NORTH

WEST

EAST

SOUTH

RECORD

Location

Cased _____ in., _____ ft.

Rig up_____

Sand_____

Drilling and Remarks:

Gas

Oil _____

Total Depth.....

PRODUCTION

1st 24 hrs. Nat. _____

1st 24 hrs. after shot.....

Gas.....Cu. Ft.

Dry Hole.....

Abandoned.....

Date _____

7110 191 8 Pandy Scout

Map No. _____ Sec. 2 Twp. 28 R. 4Well No. 1113Engine Company

Contractor _____

NORTH

WEST

EAST

SOUTH

Location _____

Rig up _____

Drilling and Remarks:

820

RECORD

Cased _____ in., _____ ft.

Sand _____

Gas _____

Oil _____

Total Depth _____

PRODUCTION

1st 24 hrs. Nat. _____

1st 24 hrs. after shot _____

Gas _____ Cu. Ft.

Dry Hole _____

Abandoned _____

Date

7/10 191 8. Landry Scout

Map No. _____ Sec. 2 Twp. 28 R. 4Well No. 11 Brant


Company _____

Contractor _____

NORTH

WEST

EAST

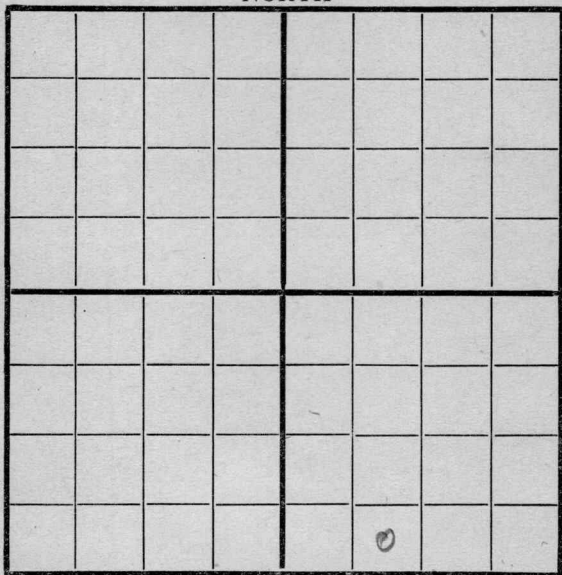

SOUTH

Location _____

Rig up _____

Drilling and Remarks:

1330

RECORD

Cased _____ in., _____ ft.

Sand _____

Gas _____

Oil _____

Total Depth _____

PRODUCTION

1st 24 hrs. Nat. _____

1st 24 hrs. after shot _____

Gas _____ Cu. Ft.

Dry Hole _____

Abandoned _____

Date


7/24 1918 J. C. Conley Scout

Map No. _____ Sec. 2 Twp. 28 R. 4Well No. 11 Braint
Engine _____ Company _____
Contractor _____

NORTH

WEST

EAST

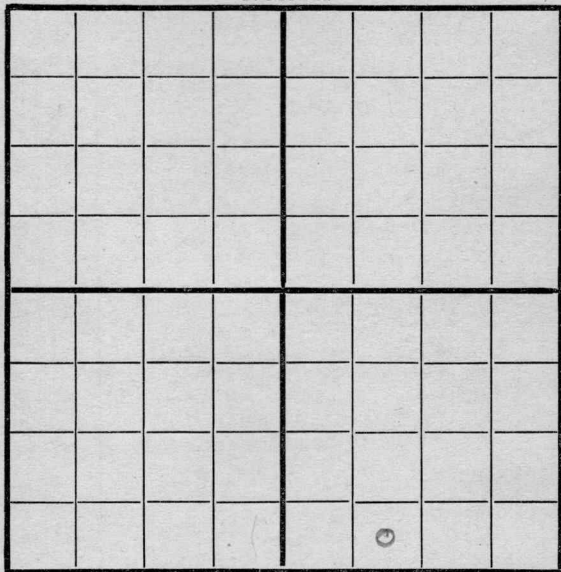

SOUTH

330 ~~82~~ x 990 ~~7.2~~ Line

RECORD

Location _____

Cased _____ in., _____ ft.

Rig up _____

Sand _____

Drilling and Remarks:

Gas _____

Oil _____

Total Depth _____

1815

PRODUCTION

1st 24 hrs. Nat. _____

1st 24 hrs. after shot _____

Gas _____ Cu. Ft.

Dry Hole _____

Abandoned _____

Date

7/31 1918 Candiff Scout

Map No. _____ Sec. 2 Twp. 28 R. 4Well No. 11 Brant


Company _____

Contractor _____

NORTH

WEST

EAST

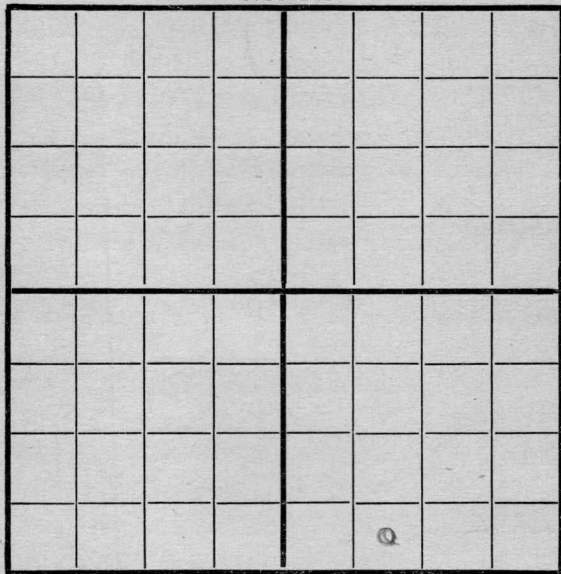

SOUTH

RECORD

Location 990 N

Cased _____ in., _____ ft.

Rig up _____

Sand _____

Drilling and Remarks:

Gas _____

Oil _____

Total Depth _____

PRODUCTION

1st 24 hrs. Nat. _____

1st 24 hrs. after shot _____

Gas _____ Cu. Ft.

Dry Hole _____

Abandoned _____

Date

8/7 1911 J. Condy Scout

Map No. _____ Sec. 2 Twp. 28 R. 4

Well No. 11 Brant


E. M. Jones Company

Contractor

NORTH

WEST

EAST

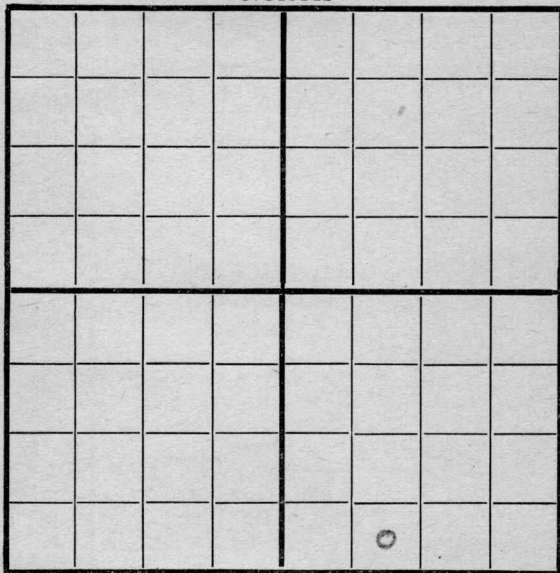

SOUTH

330 Location 9907

Rig up _____

Drilling and Remarks:

2195

RECORD

Cased _____ in., _____ ft.

Sand _____

Gas _____

Oil _____

Total Depth _____

PRODUCTION

1st 24 hrs. Nat. _____

1st 24 hrs. after shot _____

Gas _____ Cu. Ft.

Dry Hole _____

Abandoned _____

Date

8/14 of Canby


Map No. _____ Sec. 2 Twp. 28 R. 4Well No. 11 BrantEmpire Company

Contractor _____

NORTH

WEST

EAST

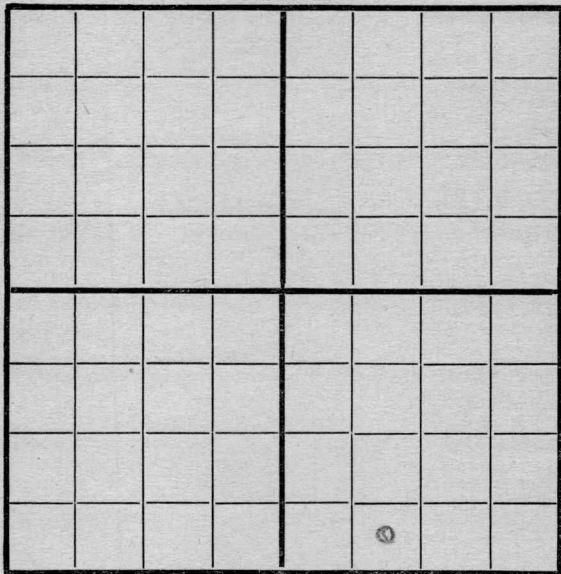

SOUTH

330' S - 990' W

Location _____

Rig up _____

Drilling and Remarks:

2440

RECORD

Cased _____ in., _____ ft.

Sand _____

Gas _____

Oil _____

Total Depth _____

PRODUCTION

1st 24 hrs. Nat. _____

1st 24 hrs. after shot _____

Gas _____ Cu. Ft.

Dry Hole _____

Abandoned _____

Date

8/21/18 Candy

191

Scout

1002
Map No. 1511 Sec. 2 Twp. 28 R. 4Well No. 11 BrantCompany Engine

Contractor _____

NORTH

WEST

EAST

COMPLETED

SOUTH

3305

9902W

Location _____

Rig up _____

Drilling and Remarks:

Est at
40 Bbls

RECORD

Cased _____ in., _____ ft.

Sand 2540-2573

Gas _____

Oil _____

Total Depth _____

PRODUCTION

1st 24 hrs. Nat. _____

1st 24 hrs. after shot _____

Gas _____ Cu. Ft.

Dry Hole _____

Abandoned _____

Date

9/6

191

Scout