


KANSAS

Greenwood county

Section 13 Township 24 Range 12-E

Well No. #1, Bonnett

Company Wilson and Barker

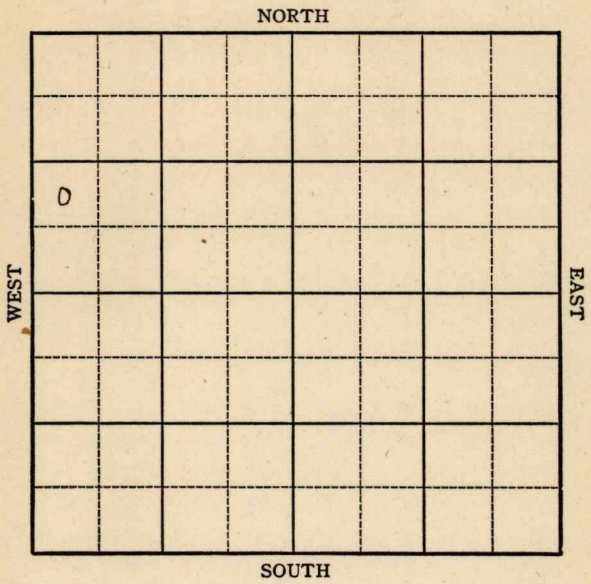

KANSAS

Greenwood county

Sec. 13 Twp. 24 R. 12-E

Well No. #1, Bonnett Farm

Wilson and Barker Company

Virgil


 Ft. from N. Line

990' Ft. from S. Line

 Ft. from E. Line

220' Ft. from W. Line

NW SW NW

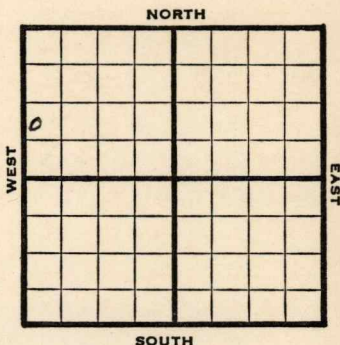

1946

REPORT

10/2	Drlg. 579'.
10/8	10" @ 619'
	Drlg 1350'
10/15	Miss 1705'
	TD 1723 SO
	7" @ 1696'
	Reaming 7"
10/22	7" @ 1712
	Est 5 oil a day
10/29	500 acid
11/6	Miss 1705'
	7" @ 1712'
	TD 1723'
	1500 Acid
	Pump 100 Oil Plus 35 W POT
	Grav. 38

COMPLETED

KANSAS

Kansas Pool Name VirgilMap No. 16 Sec. 13 Twp. 24 R. 12EWell No. 1 BonnettWilson & Barker

Company

FIRST REPORT

Contractor

NW SW NW

SECTION PLAT

0			

 Ft. from N. Line990 Ft. from S. Line Ft. from E. Line200 Ft. from W. Line*off sec*
Greenwood CountyLocation Rig up

Drilling and Remarks:

drlg. 579

RECORD

Cased in., ft.Sand Gas Oil Total Depth

PRODUCTION

1st 24 hrs. Nat. 1st 24 hrs. after shot Gas Cu. Ft.Dry Hole Abandoned

Date

OCT 2 1946 19S. J. LEWIS Scout

