


Section 13 Township 24 Range 12-E

Well No. #3, Bonnett

Company Wilson and Barker

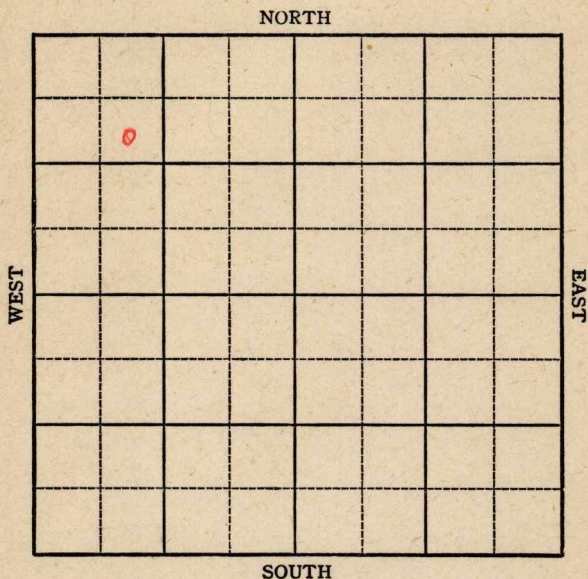

KANSAS

Sec. 13 Twp. 24 R. 12-E


Well No. #3, Bonnett Farm
Wilson and Barker Company
Virgil Pool

990' Ft. from N. Line

 Ft. from S. Line

 Ft. from E. Line

990' Ft. from W. Line

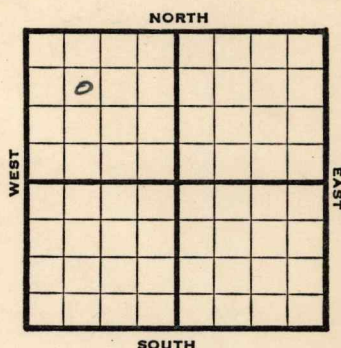

SE NW NW

1946 **Elev.**

REPORT

12/18 10" @ 715'
Drlg. 880'

1947

1/4 **Miss 1702**
TD 1740'
6" @ 1725 WOC

1/8 1740 fsg

1/15 "

1/21 **Miss 1710**
FSfsg 1740

1/30 " " "

2/5 PB 1385'

2/12 " "

2/19 " "

2/26 " "

3/12 **Miss 1710**
6" @ 1725
1000 Acid
Pump 4 Pot
Grav. 38
TD 1740

COMPLETED

Map No. _____ Sec. 13 Twp. 24 R. 12EWell No. 3 BonnettWilson & Barker

Company

FIRST REPORT

Contractor

SE NW NW

SECTION PLAT

990 Ft. from N. Line Ft. from S. Line Ft. from E. Line990 Ft. from W. Line

Greenwood County

Location _____

Rig up _____

Drilling and Remarks:

10" @ 715drlg! 880

RECORD

Cased _____ in., _____ ft.

Sand _____

Gas _____

Oil _____

Total Depth _____

PRODUCTION

1st 24 hrs. Nat. _____

1st 24 hrs. after shot _____

Gas _____ Cu. Ft.

Dry Hole _____

Abandoned _____

Date

DEC 1 8 1946 19S. J. LEWIS

Scout

KANSAS

Virgil Pool

Map No. 16 Sec. 13 Twp. 24 R. 12EWell No. 3 BonnettWilson & Barker


Company

COMPLETE

Contractor

SE NW NW

SECTION PLAT

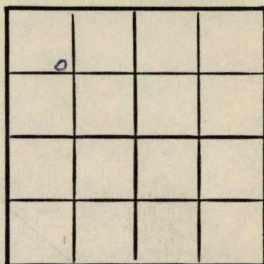990 Ft. from N. Line Ft. from S. Line Ft. from E. Line990 Ft. from W. Line

Greenwood County

RECORD

Location Rig up

Drilling and Remarks:

Cased in., ft.Sand Gas Oil Total Depth 1740

PRODUCTION

1st 24 hrs. Nat. 1st 24 hrs. after shot Gas Cu. Ft.Dry Hole Abandoned

Date

MAR 12 1947

19

S. J. LEWIS

Scout

Miss 1710
6" @ 1725
1000 acid
Pump 4 B.D.

38° Se