

KANSAS

Form 51—5M—7-40—Palace

Butler

Section 2 Township 28 Range 4-E

Well No. 15 Miller

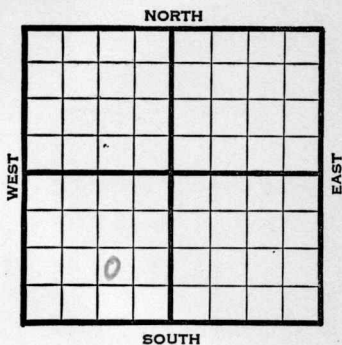
Company Cities Service Oil

		NORTH				Eldorado Pool	
WEST							
		SOUTH					

0

Sec. 2 Twp. 28 R. 4-EWell No. #15 Miller FarmCities Service Oil Company

(Eldorado)

 Ft. from N. Line990 Ft. from S. Line990 Ft. from E. Line Ft. from W. Line

1941

REPORT

1/8 Drlg. 675'

1/16 Fsg. 1597'

1/23 K.C. 2056' T.D. 2064'

Run pipe.

1/30 7" - 2056' T.D. 2095'

2000 acid.

2/6 " "

2/13 " "

2/20 " "

2/26 K.C. 2056'

7" - 2056'

T.D. 2095'

2000 acid.

Pump 17 oil & 8 water.

33. Gravity

COMPLETED

Map No. 11 Sec. 2 Twp. 28 R. 4EWell No. 15 MillerCities Service Oil Company

Contractor

FIRST REPORT

NW SE SW

SECTION PLAT

	o		

 Ft. from N. Line990 Ft. from S. Line990 Ft. from E. Line Ft. from W. Line

ELDORADO POOL

Location Rig up

Drilling and Remarks:

Drlg. 675

RECORD

Cased in., ft.Sand Gas Oil Total Depth

PRODUCTION

1st 24 hrs. Nat. 1st 24 hrs. after shot Gas Cu. Ft.Dry Hole Abandoned

Date

JAN 8 1941 19S. J. LEWIS Scout

Map No. 11 Sec. 2 Twp. 28 R. 4EWell No. 15 MillerCities Service Oil Company**COMPLETED**

Contractor

NW SE SW

_____ Ft. from N. Line

990 Ft. from S. Line990 Ft. from E. Line

_____ Ft. from W. Line

ELDORADO POOL

SECTION PLAT

	0		

Location _____

Rig up _____

Drilling and Remarks:

*KC 2056**7" @ 2056**2000 acid**Pump 17 oil & water**33rd Gr***RECORD**

Cased _____ in., _____ ft.

Sand _____

Gas _____

Oil _____

Total Depth 2095**PRODUCTION**

1st 24 hrs. Nat. _____

1st 24 hrs. after shot _____

Gas _____ Cu. Ft.

Dry Hole _____

Abandoned _____

Date

FEB 26 1941 19S. J. LEWIS Scout