


Map No. **KANSAS** Sec. 13 Twp. 24 R. 12
Well No. 7 Bonnett Farm
Crosier Oil Company

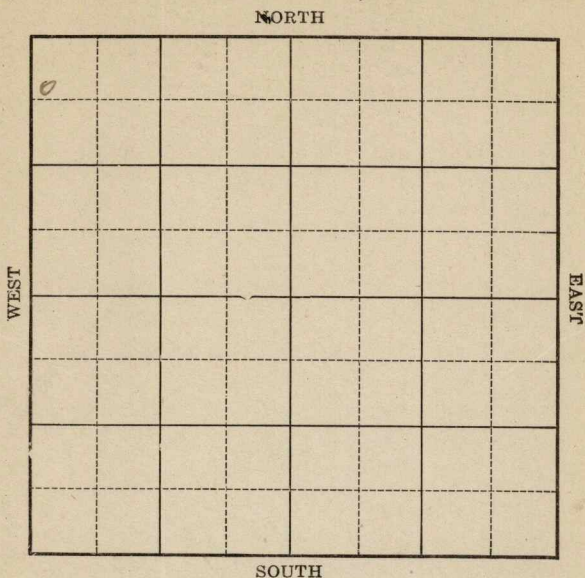

Location _____
Drilling Remarks _____

Rig Up _____
Drilling Remarks _____

RECORD


Cased _____ in. _____ ft.
Sand _____
Gas _____
Oil _____
Total Depth _____

PRODUCTION

1st 24 hrs. Nat. _____
1st 24 hrs. after shot _____
Gas _____ cu. ft.
Dry Hole _____
Abandoned _____

Map No. Kansas Sec. 13 Twp. 24 R. 12Well No. 7 Bonnett FarmCrosian Oil Company

NORTH

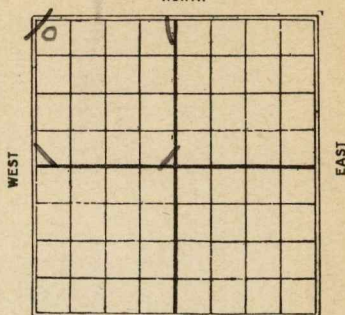

SOUTH

610 Ft. from N. Line

Ft. from S. Line

Ft. from E. Line

200 Ft. from W. Line

OFFSET

Date

REPORT

1926

{Ticket Coming in}

1/14

Top Line 1713

1st oil 1730 T.D. 1750

60 gts pumped 10 Bbls

Pulled 8" & 10" Water

broke in Well Plug

1/18~~Top Line~~ (2el)1/273/4

—— (offset)

2/10

Top Line 1713 1st oil

1730 T.D. 1750

60 gts Pumping 10 Bbls

Shenwood Co
 16 KANSAS 13 24 R. 12
 Map No. Sec. Twp. R.
 Well No. 7 *Dorsett*
Crosier Oil Co Company

Contractor

FIRST REPORTS

SECTION PLAT

610 Ft. from N. Line
 _____ Ft. from S. Line
 _____ Ft. from E. Line
 200 Ft. from W. Line

0			

"OFFSET"

Missed Drill Sand.

Location _____

Rig up _____

Drilling and Remarks:

Tap line 1713'
1st oil 1730' TD 1750'
Pulled up 200 natural
gas pumped 10 bls day
for 3 days. Pulled 8"
and 10" - Water Break in.
Well Plug.

Date

RECORD

Cased _____ in., _____ ft.
 Sand _____
 Gas _____
 Oil _____
 Total Depth 1750

PRODUCTION

1st 24 hrs. Nat. _____
 1st 24 hrs. after shot _____
 Gas _____ Cu. Ft.
 Dry Hole _____
 Abandoned _____

JAN 14 1926

192

CHAS. L. SHERWOOD

Scout

16 KANSAS Sec. 12 Twp. 24 R. 12

Well No. 7 Bonnett

EROSIAR OIL Co Company

Contractor

CORRECTION


_____ Ft. from N. Line

_____ Ft. from S. Line

_____ Ft. from E. Line

_____ Ft. from W. Line

SECTION PLAT

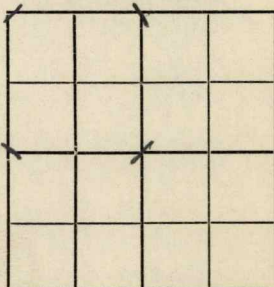

Location _____

Rig up _____

Drilling and Remarks:

Chg Ownership
to shoot.

Formerly owned
by Marshall Bros

RECORD

Cased _____ in., _____ ft.

Sand _____

Gas _____

Oil _____

Total Depth _____

PRODUCTION

1st 24 hrs. Nat. _____

1st 24 hrs. after shot _____

Gas _____ Cu. Ft.

Dry Hole _____

Abandoned _____

Date

JAN 14 1926

192 CHAS. L. SHERWOOD

Scout

Sherwood Co

K16 KANSAS 13
 Map No. _____ Sec. _____ Twp. 24 R. 12

Well No. 7 Donno
 Orodian Oil Co
 _____ Company

 Contractor

COMPLETED

SECTION PLAT

610
 _____ Ft. from N. Line

_____ Ft. from S. Line

_____ Ft. from E. Line

200
 _____ Ft. from W. Line

6			

Location _____

Rig up _____

Drilling and Remarks:

Tap line 1713'
 1st oil 1730' 20
 1750'

bag dumping 10 bbls

RECORD

Cased _____ in., _____ ft.

Sand _____

Gas _____

Oil _____

Total Depth 1750'

PRODUCTION

1st 24 hrs. Nat. _____

1st 24 hrs. after shot _____

Gas _____ Cu. Ft.

Dry Hole _____

Abandoned _____

Date

FEB 10 1926

192

CHAS. L. SHERWOOD

Scout