

Well No. 1 Ellis Farm

Well No. 1 Ellis Farm
P. J. Gillespie **CENTRAL STATES OIL**
Company

WEST

EAST

SOUTH

Location -----

Drilling Remarks:

Rig Up-----

Drilling Remarks:

RECORD

Cased _____ in. _____ ft.

Sand _____

Gas _____

Oil _____

Total Depth -----

PRODUCTION

1st 24 hrs. Nat. -----

1st 24 hrs. after shot_ _ _ _ _

Gas ----- cu. ft.

Dry Hole_____

Abandoned_ _ _ _ _


Map No. **O.W.W.O.** Sec. 13 Twp. 24 R. 12Well No. #1 Ellis Farm
CENTRAL STATES OIL Py Gillespie Company330 Ft. from N. Line

Ft. from S. Line

Ft. from E. Line

330 Ft. from W. Line

NW NW SE

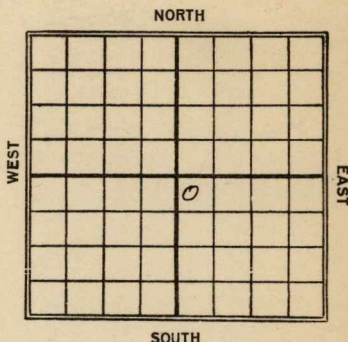

Date

Elev. -

REPORT

7/22

Rig Bldg

8/26 T.S. 1770-1809 - 75 Bbls. (Tel).

8/30 Sand 1694 to 1709. Shot
60 gts. Started off 80 Bbls.
Now Making 25 Bbls on
pump (Tel).9/16 Sand 1694-1709- Shot 60
gts. Pumping 20 Bbls.

1953

3/18

Miss 1695

OTD 1713'

4/22

D&A

TD 1714

Miss 1695,

OTD 1713

Weisner sd 1197

DD 1714 HFW & VSSO

PB 1205

D&A

O.W.W.O.

ABANDONED

O.W.W.O.


County Greenwood State Kansas

Sec. 13 (Blk. Twp.) 24 (Sur. Rge.) 12E Map No.

Operator Central States Oil

Well No. 1 Farm Ellis

Elev. Location NW NW SE

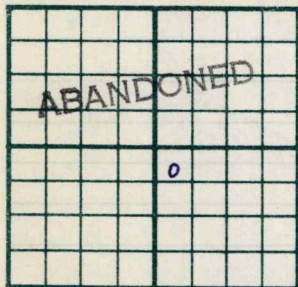

330 Ft. From N Line SE

330 Ft. From W Line Quarter

1st. Report

Completion APR 22 1953

Remarks OWWO

Spudding Date

Drig. Data D & A TD 1714

Miss. 1695 OTD 1713 Weisner sd. 1197

DD 1714 HFW & VSSO PB 1205

D & A

J. G. McGEHEE