

Kansas

Map No. _____ Sec. 13 Twp. 24 R. 12

Well No. 2 Ellis Farm

R. J. Gillespie

Company

NORTH

WEST

EAST

X

FILE

SOUTH

FIRST REPORT
COMPLETED

Location _____

Drilling Remarks:

Rig Up

Drilling Remarks:

RECORD

Cased _____ in. _____ ft.

Sand _____

Gas _____

Oil_____

Total Depth _____

PRODUCTION

1st 24 hrs. Nat._____

1st 24 hrs. after shot_____

Gas_____cu. ft.

Dry Hole _____

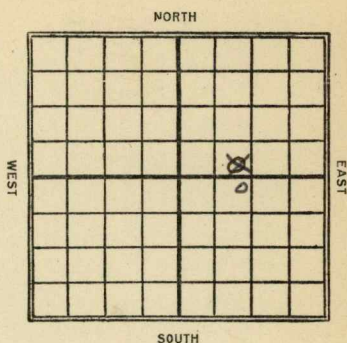
Abandoned _____

Map No. _____ Sec. 13 Twp. 24 R. 12Well No. 2 Ellis Farm
R. Y. Gillespie Company

_____ Ft. from N. Line

200 Ft. from S. Line

_____ Ft. from E. Line

1120 Ft. from W. Line

Date

REPORT

192210/26Dlg. 1020'11/24Sand 1721-35 - Shot 60
gto. 25 Bbls.

Map No. **KANSAS** ¹⁶ Sec. ¹³ Twp. ²⁴ R. ¹²Well No. ² *E. Ellis**R. J. Gillespie* Company

Contractor

FIRST REPORT

²⁰⁰ Ft. from N. Line²⁰⁰ Ft. from S. Line

Ft. from E. Line

¹¹²⁰ Ft. from W. Line

SECTION PLAT

		0	

Location

Rig up

Drilling and Remarks:

¹⁰²⁰

RECORD

Cased _____ in., _____ ft.

Sand _____

Gas _____

Oil _____

Total Depth _____

PRODUCTION

1st 24 hrs. Nat. _____

1st 24 hrs. after shot _____

Gas _____ Cu. Ft.

Dry Hole _____

Abandoned _____

Date

OCT 26 1922 ¹⁹¹ M. A. BENEAR Scout

Map No. **KANSAS** Sec. **13** Twp. **24** R. **12**

Well No. **2 E. 13**

R. Y. Gillespie Company

Contractor

COMPLETED

SECTION PLAT

-----Ft. from N. Line

200

-----Ft. from S. Line

-----Ft. from E. Line

940

-----Ft. from W. Line

		0	

Location -----

Rig up -----

Drilling and Remarks:

Top line 1715

shot 60 ft

RECORD

Cased ----- in., ----- ft.

Sand -----

Gas -----

Oil **1721-35**

Total Depth **1735**

PRODUCTION

1st 24 hrs. Nat. -----

1st 24 hrs. after shot **25**

Gas ----- Cu. Ft.

Dry Hole -----

Abandoned -----

Date

NOV 24 1922

M. A. BENEAR

Scout