

Map No. _____ Sec. 10 Twp. 27 R. 4

Well No. 9 Bates Farm _____
Cosden O & G Company

NORTH



SOUTH

Location _____ Rig Up _____

Drilling Remarks:

300 Bues (and 2460-2488)

6/1

Drilling Remarks:

RECORD

Cased _____ in. _____ ft.

Sand _____

Gas _____

Oil _____

Total Depth _____

PRODUCTION

1st 24 hrs. Nat. _____

1st 24 hrs. after shot _____

Gas _____ cu. ft.

Dry Hole _____

Abandoned _____

1001 *K11* Map No. *10* Sec. *275* Twp. *4E* R.
 Well No. *9* *H.C. Bates* Farm
Cosden Oil & Gas Company

NORTH

WEST



EAST

SOUTH

Location -----

Rig Up -----

Drilling and remarks

*200 ft north
 of south line
 400 ft. east of
 #4.*

P.B. 1/23/15

RECORD

Cased ----- in. ----- Ft.

Sand -----

Gas -----

Oil -----

Total Depth -----

PRODUCTION

1st 24 hrs. Nat. -----

1st 24 hrs. after shot -----

Gas ----- Cu. Ft.

Dry Hole -----

Abandoned -----

Date

-----, 191-----


Eugene Dept. Scout
per M. J.

Map No. ¹⁰⁰¹ K11 Sec. 10 Twp. 27 R. 4

Well No. 9 Bates Farm
Cosden Company

NORTH

WEST

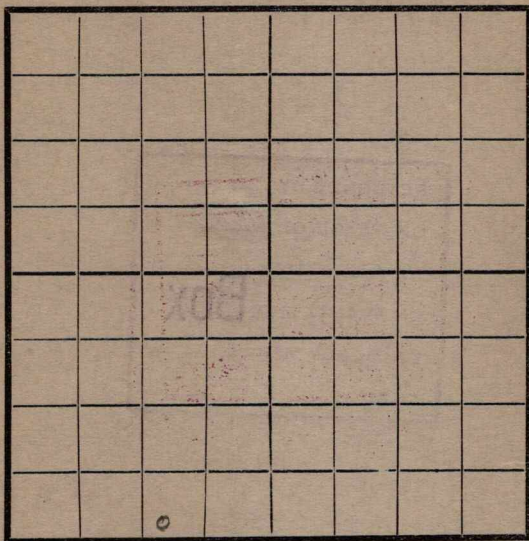

EAST

SOUTH

Location -----

Rig Up -----

Drilling and remarks

RECORD

Cased ----- in. ----- Ft.

Sand -----

Gas -----

Oil -----

Total Depth -----

PRODUCTION

1st 24 hrs. Nat. -----

1st 24 hrs. after shot -----

Gas ----- Cu. Ft.

Dry Hole -----

Abandoned -----

FIRST REPORT

Date

3/21, 1918 Cosden Scout


Map No. _____ Sec. 10 Twp. 27 R. 4

Well No. 913 Farm _____

Cosden Company _____

NORTH

WEST

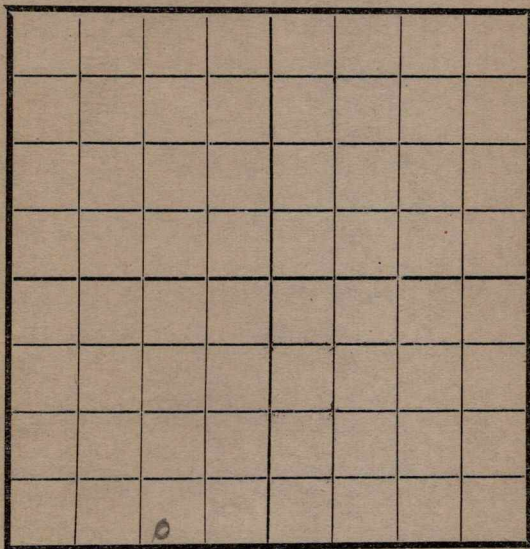

EAST

SOUTH

Location _____

Rig Up _____

Drilling and remarks

*Rigging up
Sidwell Bros
(August 1910)*

RECORD

Cased _____ in. _____ Ft.

Sand _____

Gas _____

Oil _____

Total Depth _____

PRODUCTION

1st 24 hrs. Nat. _____

1st 24 hrs. after shot _____

Gas _____ Cu. Ft.

Dry Hole _____

Abandoned _____

Date

4/10, 1910 S. Cosden Scout


Map No. _____ Sec. 10 Twp. 27 R. 4

Well No. 9 Bates Farm _____

Cassidy Company _____

NORTH

WEST

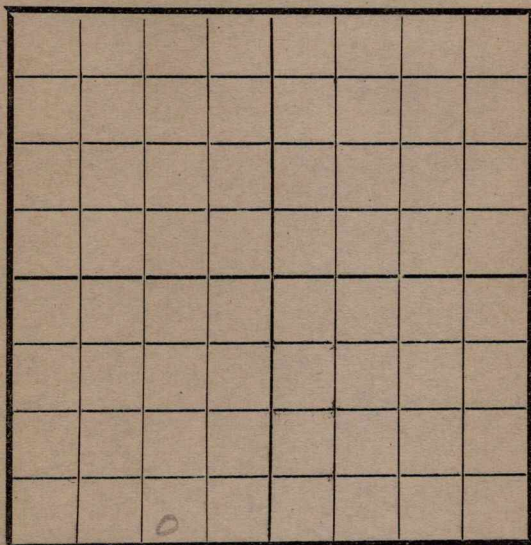

EAST

SOUTH

Location _____

Rig Up _____

Drilling and remarks

250

RECORD

Cased _____ in. _____ Ft.

Sand _____

Gas _____

Oil _____

Total Depth _____

PRODUCTION

1st 24 hrs. Nat. _____

1st 24 hrs. after shot _____

Gas _____ Cu. Ft.

Dry Hole _____

Abandoned _____

Date

4/17, 1918 S. Cassidy Scout


Map No. K11 Sec. 10 Twp. 22 R. 4

Well No. 91301 Farm

Company

NORTH

WEST

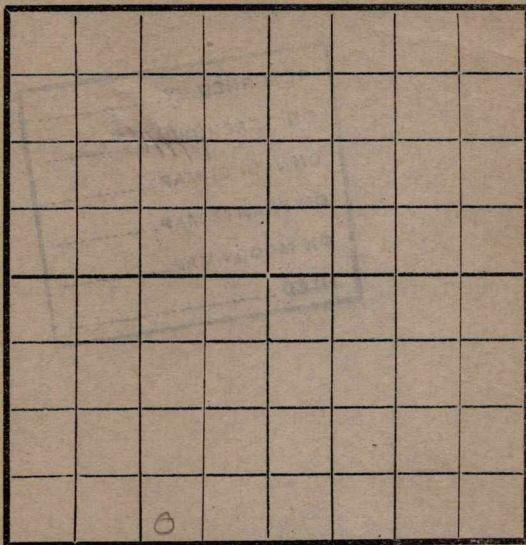

EAST

SOUTH

Location -----

Rig Up -----

Drilling and remarks

RECORD

Cased ----- in. ----- Ft.

Sand -----

Gas -----

Oil -----

Total Depth -----

PRODUCTION

1st 24 hrs. Nat. -----

1st 24 hrs. after shot -----

Gas ----- Cu. Ft.

Dry Hole -----

Abandoned -----


Date

4/24, 1918 Conley Scout

Map No. _____ Sec. 10 Twp. 27 R. 4
 Well No. 9 Bates Farm _____
Crescent Company

NORTH

WEST

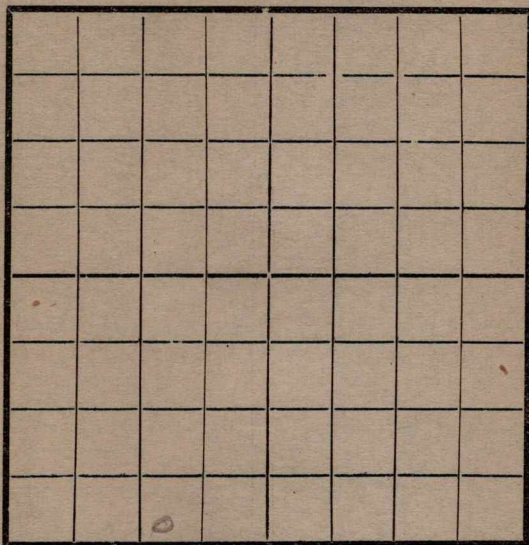

EAST

SOUTH

Location _____
 Rig Up _____
 Drilling and remarks

RECORD

Cased _____ in. _____ Ft.
 Sand _____
 Gas _____
 Oil _____
 Total Depth _____

PRODUCTION

1st 24 hrs. Nat. _____
 1st 24 hrs. after shot _____
 Gas _____ Cu. Ft.
 Dry Hole _____
 Abandoned _____


Date

5/1, 1918 Crescent Scout

Map No. _____ Sec. 10 Twp. 27 R. 4Well No. 9 Bate Farm _____
Cusden Company _____

NORTH

WEST

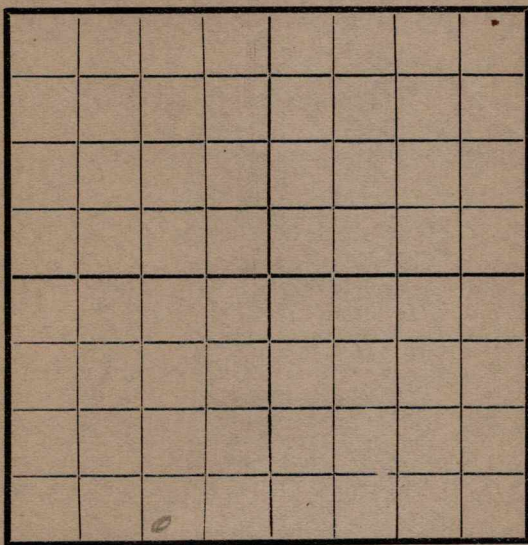

EAST

SOUTH

Location _____

Rig Up _____

Drilling and remarks

1475

RECORD

Cased _____ in. _____ Ft.

Sand _____

Gas _____

Oil _____

Total Depth _____

PRODUCTION

1st 24 hrs. Nat. _____

1st 24 hrs. after shot _____

Gas _____ Cu. Ft.

Dry Hole _____

Abandoned _____

Date


5/8, 1911 S. Cusden Scout

Map No. _____ Sec. 10 Twp. 27 R. 4

Well No. 9 B. 10 Farm _____
C. S. D. Co. Company

NORTH

WEST

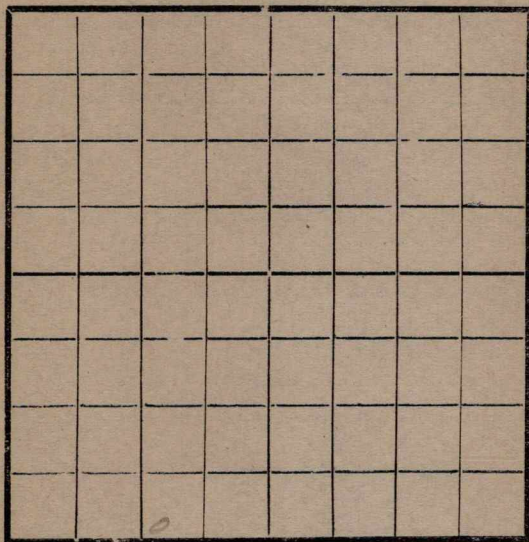

EAST

SOUTH

Location _____

Rig Up _____

Drilling and remarks

1475

RECORD

Cased _____ in. _____ Ft.

Sand _____

Gas _____

Oil _____

Total Depth _____

PRODUCTION

1st 24 hrs. Nat. _____

1st 24 hrs. after shot _____

Gas _____ Cu. Ft.

Dry Hole _____

Abandoned _____


Date

5/15, 1911 J. C. D. Co. Scout

Map No. _____ Sec. 10 Twp 27 R. 4
 Well No. 9 Bates Farm _____
Cosden Company

NORTH

WEST

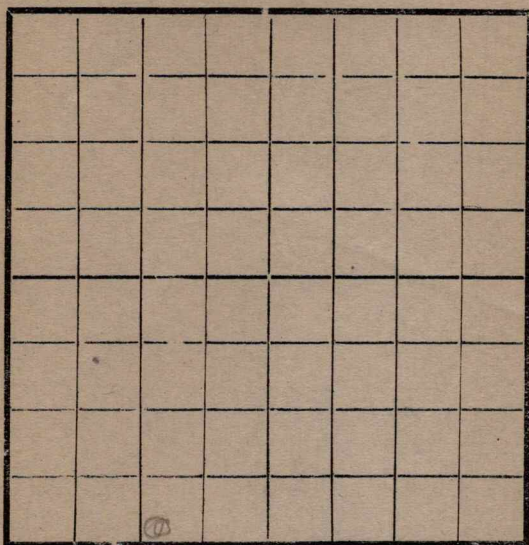

EAST

SOUTH

Location _____
 Rig Up _____
 Drilling and remarks

2140

RECORD

Cased _____ in. _____ Ft.
 Sand _____
 Gas _____
 Oil _____
 Total Depth _____

PRODUCTION

1st 24 hrs. Nat. _____
 1st 24 hrs. after shot _____
 Gas _____ Cu. Ft.
 Dry Hole _____
 Abandoned _____

Date


5/22, 1918 Cosden Scout

Map No. _____ Sec. 10 Twp. 27 R. 4

Well No. 930 Farm _____
Co. 100 Company _____

NORTH

WEST

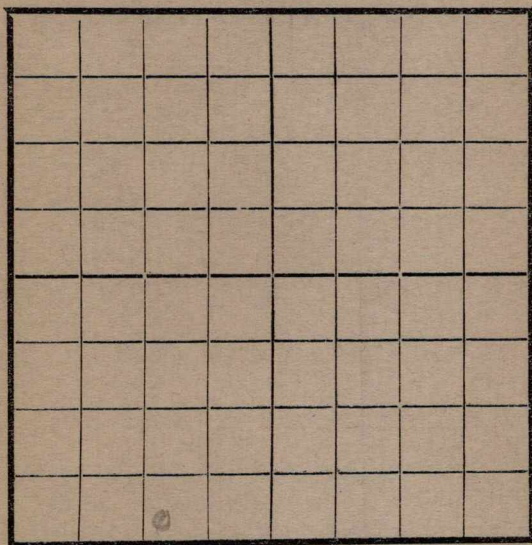

EAST

SOUTH

Location _____

Rig Up _____

Drilling and remarks

Top sand
2444

RECORD

Cased _____ in _____ Ft.

Sand _____

Gas _____

Oil _____

Total Depth _____

PRODUCTION

1st 24 hrs. Nat. _____

1st 24 hrs. after shot _____

Gas _____ Cu. Ft.

Dry Hole _____

Abandoned _____

Date

5/29, 1918 S. C. C. C. Scout

Well No. 213 all

Sidwell Bros - Contractor

WEST

EAST

SOUTH

Rig up

25 of
30 Bbl

Cased _____ in., _____ ft.

Sand 24460-2488

Gas _____

Oil

Total Depth.....

PRODUCTION

1st 24 hrs. Nat. -----

1st 24 hrs. after shot-----

Gas.....Cu. Ft.

Dry Hole

Abandoned.....

Date _____

191

Scout

Well No. 9734

_____ Company

Amel Bros Contractor



Location

Rig up-----

Drilling and Remarks:

Sept

30 Bhs

Cased-----in., -----ft.

Sand 2460-2488

Gas -----

Oil _____

Total Depth.....

PRODUCTION

1st 24 hrs. Nat. -----

1st 24 hrs. after shot_____

Gas_____Cu. Ft.

Dry Hole.....

Abandoned.....

Date _____

6/3 1918 Campbell Scout

Tulsa, Oklahoma,
June 5th, 1918.

On Im. County maps

ACCOUNTING DEPARTMENT

SCOUTING "
ENGINEERING "
RENTAL "
LEGAL "

Building.

Gentlemen:

This is to advise you that Well No. 9 located in _____
_____ of Bates, H. C. _____
Lease, described as S $\frac{1}{2}$ of the SW $\frac{1}{4}$ of _____
_____ Section 10, Township 27S, Range 4E _____
was completed on May 31st, _____ 1918, at a total depth of
_____ 2488 feet, and is good for a Oil well, with
estimated production of _____ 30 barrels per day.

We have already completed arrangements with _____
_____ Pipe Line Company to take care of the oil.

Remarks: _____
_____ Drilling completed on May 31st, 1918. _____

Yours very truly,

Conroy

*See location Report
177.*