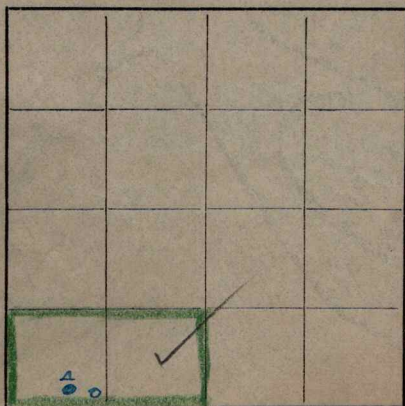


LOCATION NOTICE

Tulsa, Okla., March 16, 191 191 8 No. 177To Leonard LoopAddress Augusta, KansasCOSDEN OIL & GAS CO. will drill a well

as described below, and this notice will be your authority for commencement of work.

The location will be on H. C. Bates Farmin 3/2 of SW/4 of Section 10 Township 27 S Range 4 EButtler County, State of KansasWell No. 9

_____ feet from North line

_____ feet from East line

200 feet from South line

_____ feet from West line

Remarks: 400 Feet East ofNo. 4,

Copies to

Accounting Dept.
 Engineering Dept.
 Legal Dept.
 Rental Dept.
 Scouting Dept.

(Signed)

Gomory