


Map No. _____ Sec. 2 Twp. 28 R. 4
 Well No. 4 Martin Farm _____
Empire Company _____

NORTH

WEST

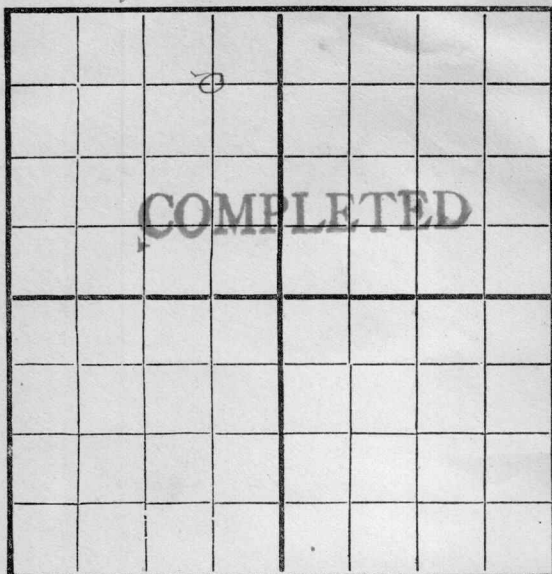

EAST

SOUTH

Location 1916Rig Up 11-27-16

Drilling Remarks:

Drilling Remarks:

R. 21 = 12/4 = 12/11 = 12/18375' 12/281440 = 1/8/171625 = 1/15

RECORD

Cased _____ in _____ Ft.

S and _____

Gas _____

Oil _____

Total Depth _____

PRODUCTION

1st 24 hrs. Nat. _____

1st 24 hrs. after shot _____

Gas _____ Cu. Ft.

Dry Hole _____

Abandoned _____

Map No. _____ Sec. 2 Twp. 28 R. 4Well No. 4 Martin FarmEmpire Company

NORTH

WEST

EAST

SOUTH

Location _____

Rig Up _____

Drilling and remarks _____

RECORD

Cased _____ in. _____ Ft.

Sand _____

Gas _____

Oil _____

Total Depth _____

PRODUCTION

1st 24 hrs. Nat. _____

1st 24 hrs. after shot _____

Gas _____ Cu. Ft.

Dry Hole _____

Abandoned _____

Date


11/27, 1916 C. Condy Scout

Map No. _____ Sec. 2 Twp. 28 R. 4Well No. 5 Martin Farm __________ E. McKee Company _____

NORTH

WEST

EAST

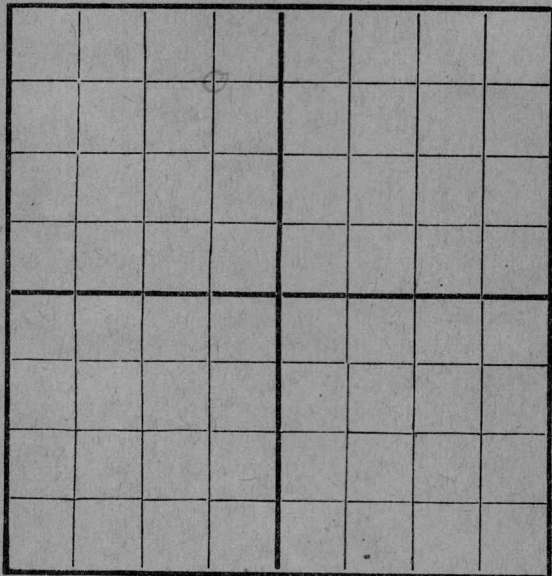

SOUTH

RECORD

Location _____

Cased _____ in. _____ Ft.

Rig Up ☒ _____

Sand _____

Drilling and remarks _____

Gas _____

Oil _____

Total Depth _____

PRODUCTION

1st 24 hrs. Nat. _____

1st 24 hrs. after shot _____

Gas _____ Cu. Ft.

Dry Hole _____

Abandoned _____

Date

12/4, 1916 Cordell Scout

Map No. _____ Sec. 2 Twp. 28 R. 4Well No. 4 montie Farm _____Engine Company _____

NORTH

WEST

EAST

SOUTH

RECORD

Location _____

Cased _____ in. _____ Ft.

Rig Up _____

Sand _____

Drilling and remarks

Gas _____

Oil _____

Total Depth _____

PRODUCTION

1st 24 hrs. Nat. _____

1st 24 hrs. after shot _____

Gas _____ Cu. Ft.

Dry Hole _____

Abandoned _____

Date

12/11, 1916, Carroll Scout


Map No. _____ Sec. 2 Twp. 28 R. 4

Well No. 5 Union Farm _____

Company Company _____

NORTH

WEST

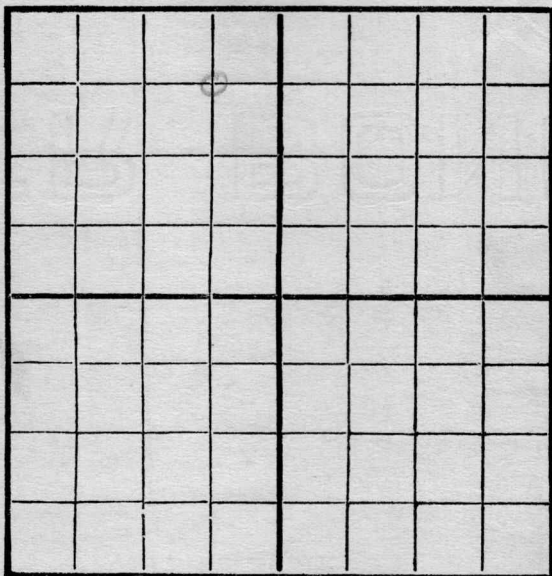

EAST

SOUTH

Location _____

Rig Up _____

Drilling and remarks

Rigged up

RECORD

Cased _____ in. _____ Ft.

Sand _____

Gas _____

Oil _____

Total Depth _____

PRODUCTION

1st 24 hrs. Nat. _____

1st 24 hrs. after shot _____

Gas _____ Cu. Ft.

Dry Hole _____

Abandoned _____

Date

12/18, 1916 Conley Scout

Map No. _____ Sec. 2 Twp. 28 R. 4
 Well No. 5 Martin Farm _____
Empire Company _____

NORTH

WEST



EAST

SOUTH

RECORD

Location _____
 Rig Up _____
 Drilling and remarks _____

Cased _____ in. _____ Ft.
 Sand _____
 Gas _____
 Oil _____
 Total Depth _____

PRODUCTION

1st 24 hrs. Nat. _____
 1st 24 hrs. after shot _____
 Gas _____ Cu. Ft.
 Dry Hole _____
 Abandoned _____


Date _____

_____, 191____, _____ Scout

Map No. _____ Sec. 2 Twp. 28 R. 4
 Well No. 45 Martin Farm _____
Engine Company _____

NORTH

WEST

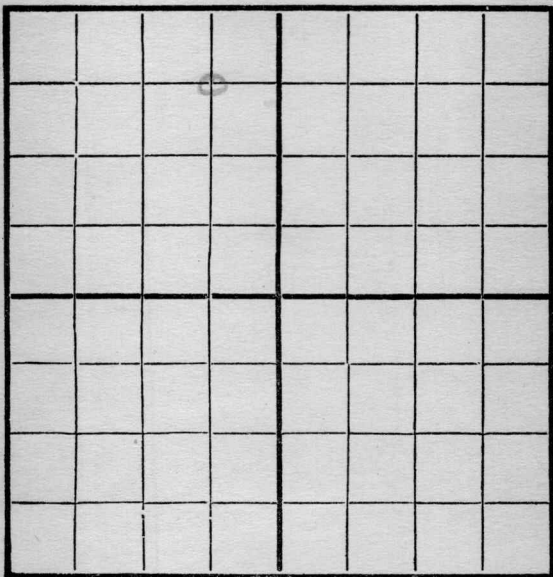

EAST

SOUTH

Location _____
 Rig Up _____
 Drilling and remarks _____

375

RECORD

Cased _____ in. _____ Ft.
 Sand _____
 Gas _____
 Oil _____
 Total Depth _____

PRODUCTION

1st 24 hrs. Nat. _____
 First 24 hrs. after shot _____
 Gas _____ Cu. Ft.
 Dry Hole _____
 Abandoned _____


Date

12/28, 1916 Cooley Scout

Map No. _____ Sec. 2 Twp. 28 R. 4
 Well No. 4 North Farm _____
Engine Company _____

NORTH

WEST

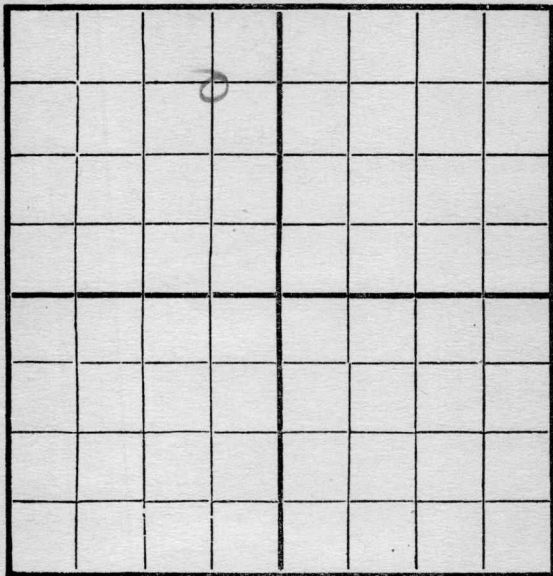

EAST

SOUTH

Location _____
 Rig Up _____
 Drilling and remarks

775

RECORD

Cased _____ in. _____ Ft.
 Sand _____
 Gas _____
 Oil _____
 Total Depth _____

PRODUCTION

1st 24 hrs. Nat. _____
 First 24 hrs. after shot _____
 Gas _____ Cu. Ft.
 Dry Hole _____
 Abandoned _____


Date

1/1, 1912 Early Scout

Map No. _____ Sec. 2 Twp. 28 R. 4
 Well No. 4 North Farm _____
Empire Company _____

NORTH

WEST

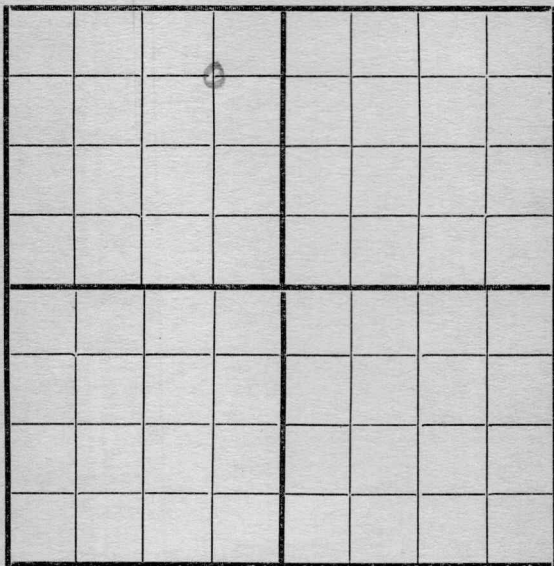

EAST

SOUTH

Location _____
 Rig Up _____
 Drilling and remarks

1440

RECORD

Cased _____ in. _____ Ft.
 Sand _____
 Gas _____
 Oil _____
 Total Depth _____

PRODUCTION

1st 24 hrs. Nat. _____
 1st 24 hrs. after shot _____
 Gas _____ Cu. Ft.
 Dry Hole _____
 Abandoned _____

Date

1/8, 1912 Early Scout

Map No. _____ Sec. 2 Twp. 28 R. 4


Well No. 4 Union Farm

Company Company

NORTH

WEST

EAST

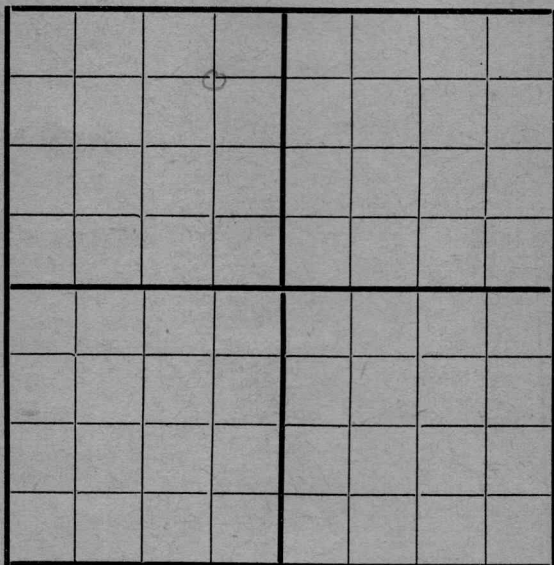

SOUTH

Location _____

Rig Up _____

Drilling and remarks

1625

RECORD

Cased _____ in. _____ Ft.

Sand _____

Gas _____

Oil _____

Total Depth _____

PRODUCTION

1st 24 hrs. Nat. _____

1st 24 hrs. after shot _____

Gas _____ Cu. Ft.

Dry Hole _____


Abandoned _____

Date

1/15, 1917 Cord Scout

Map No. _____ Sec. 2 Twp. 28 R. 4
 Well No. 40 Martin Farm _____
Empire Company

NORTH

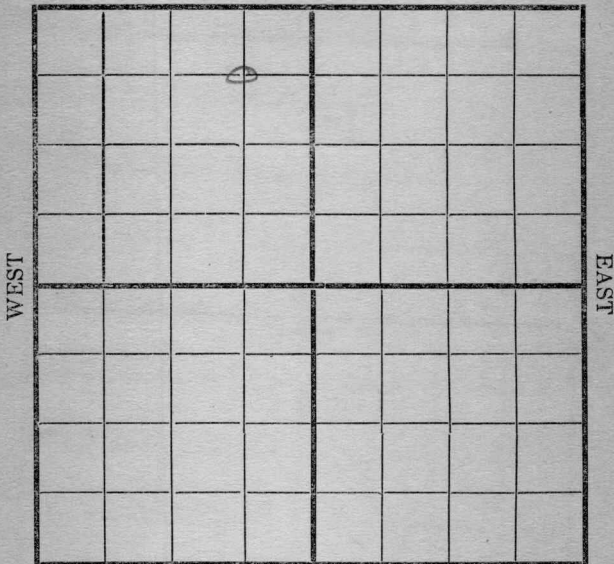

SOUTH

Location _____
 Rig Up _____
 Drilling and remarks

1885

RECORD

Cased _____ in. _____ Ft.
 Sand _____
 Gas _____
 Oil _____
 Total Depth _____


PRODUCTION

1st 24 hrs. Nat. _____
 1st 24 hrs. after shot _____
 Gas _____ Cu. Ft.
 Dry Hole _____
 Abandoned _____

Date

1/22, 1917 Carley Scout

Map No. _____ Sec. 2 Twp. 28 R. 4
 Well No. 4 Martin Farm
Empire Company
 NORTH

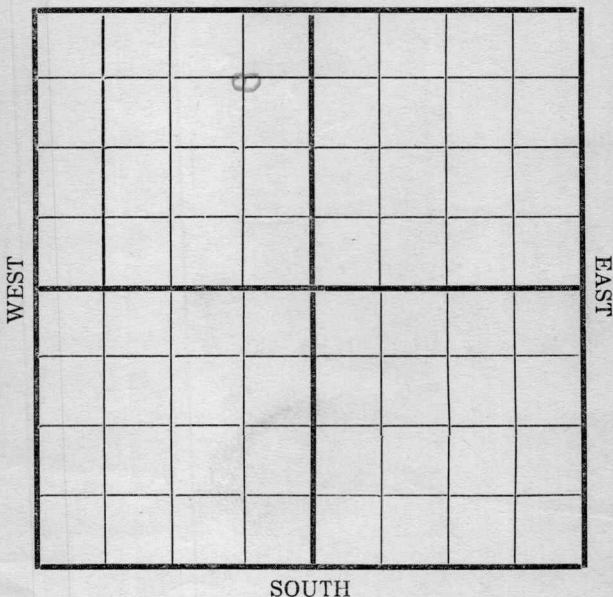


Location _____	RECORD Cased _____ in. _____ Ft. Sand _____ Gas _____ Oil _____ Total Depth _____	
Rig Up _____		
Drilling and remarks <u>2150</u>		
		PRODUCTION 1st 24 hrs. Nat. _____ 1st 24 hrs. after shot _____
		Gas _____ Cu. Ft. Dry Hole _____ Abandoned _____

Date 1/29 1917 Conde Scout

Map No. _____ Sec. 2 Twp. 28 R. 4
 Well No. 4 Martin Farm _____
Cummins Company _____

NORTH

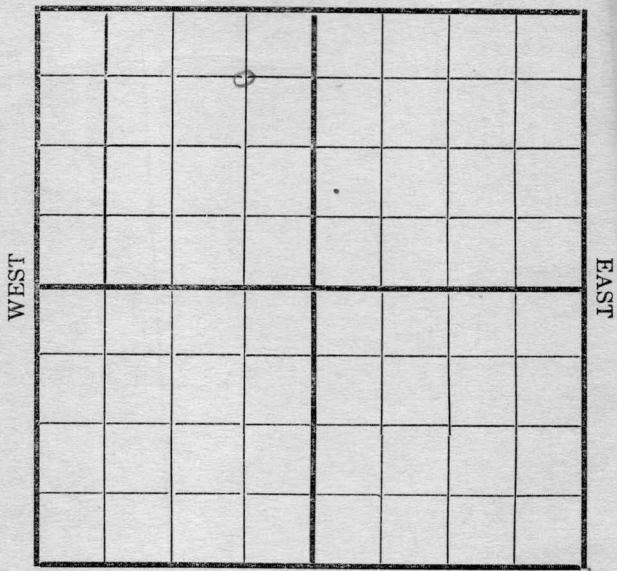


SOUTH

Location _____ Rig Up _____ Drilling and remarks _____ <u>2295</u>	RECORD Cased _____ in. _____ Ft. Sand _____ Gas _____ Oil _____ Total Depth _____ PRODUCTION 1st 24 hrs. Nat. _____ 1st 24 hrs. after shot _____ Gas _____ Cu. Ft. Dry Hole _____ Abandoned _____
---	--

Date 2-5-1917 C. Condit Scout

Map No. _____ Sec. 2 Twp. 28 R. 4
Well No. 4 Northern Farm _____
Empire Company _____
NORTH

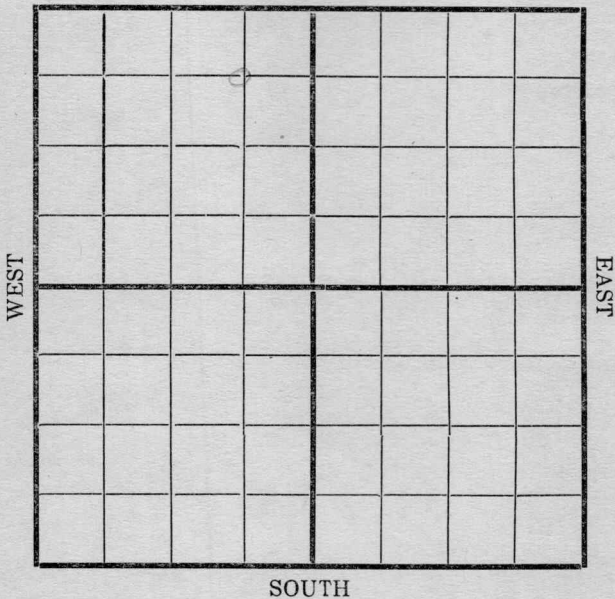

Location _____
Rig Up _____
Drilling and remarks _____

2310'

RECORD

Cased _____ in. _____ Ft.
Sand _____
Gas _____
Oil _____
Total Depth _____

PRODUCTION

1st 24 hrs. Nat. _____
1st 24 hrs. after shot _____
Gas _____ Cu. Ft.
Dry Hole _____
Abandoned _____

Date 2/12, 1917 Combs Scout

Map No. _____ Sec. 2 Twp. 28 R. 4
 Well No. 4 Martin Farm _____
Empire Company _____

NORTH

WEST

EAST

SOUTH

Location _____

Rig Up _____

Drilling and remarks

Topsound
2578

Pulling pipe

RECORD

Cased _____ in. _____ Ft.

Sand _____

Gas _____

Oil _____

Total Depth _____

PRODUCTION

1st 24 hrs. Nat. _____

First 24 hrs. after shot _____

Gas _____ Cu. Ft.

Dry Hole _____

Abandoned _____

Date


2/19 191 *2* _____ Scout

Map No. _____ Sec. 2 Twp. 28 R. 4
 Well No. 4 Martin Farm _____
Empire Company _____

NORTH

WEST

EAST

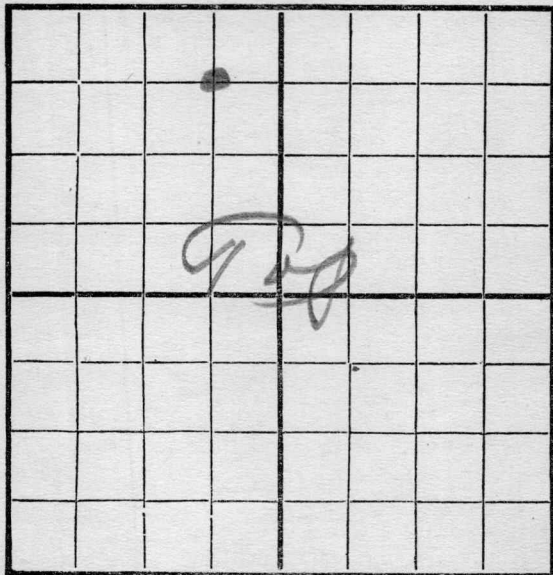

SOUTH

Location _____

Rig Up _____

Drilling and remarks

Top sand
2578
Pulling pipe

RECORD

Cased _____ in. _____ Ft.

Sand _____

Gas _____

Oil _____

Total Depth _____

PRODUCTION

1st 24 hrs. Nat. _____

First 24 hrs. after shot _____

Gas _____ Cu. Ft.


Dry Hole _____

Abandoned _____

Date

2/19 191 *2* *Carley* Scout

Map No. _____ Sec. 2 Twp. 28 R. 4
 Well No. 4 Martin Farm
Empire Company
 NORTH

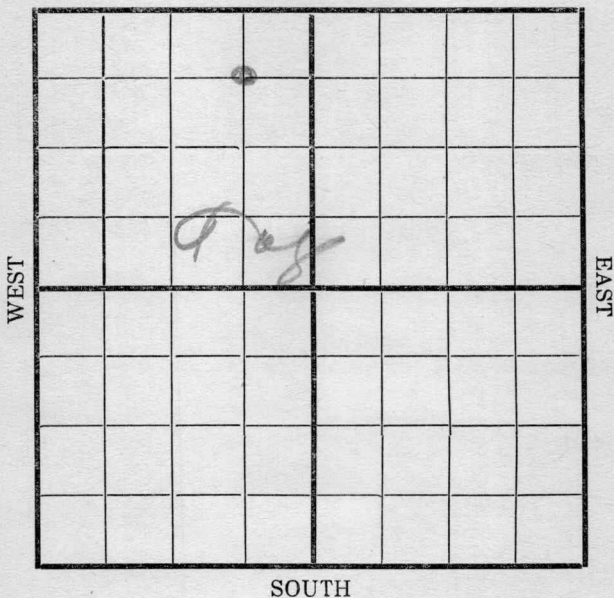

Location _____

Rig Up _____

Drilling and remarks

*Pulling
big pipe*

RECORD

Cased _____ in. _____ Ft.

Sand 2578

Gas _____

Oil _____

Total Depth _____

PRODUCTION

1st 24 hrs. Nat. _____

1st 24 hrs. after shot _____

Gas _____ Cu. Ft.

Dry Hole _____

Abandoned _____

Date

2/30, 1912 Condy Scout

Map No. _____ Sec. 2 Twp. 28 R. 4Well No. 47 miles Farm _____Empire Company _____

NORTH

WEST

EAST

SOUTH

REMARKS:

Tap sand 2578
 Having trouble pulling
 Big Pipe

Date


2/5

, 191

7Cond

Scout

Map No. _____ Sec. 2 Twp. 28 R. 4
Well No. 4 _____ Farm _____
Angine _____ Company _____
NORTH

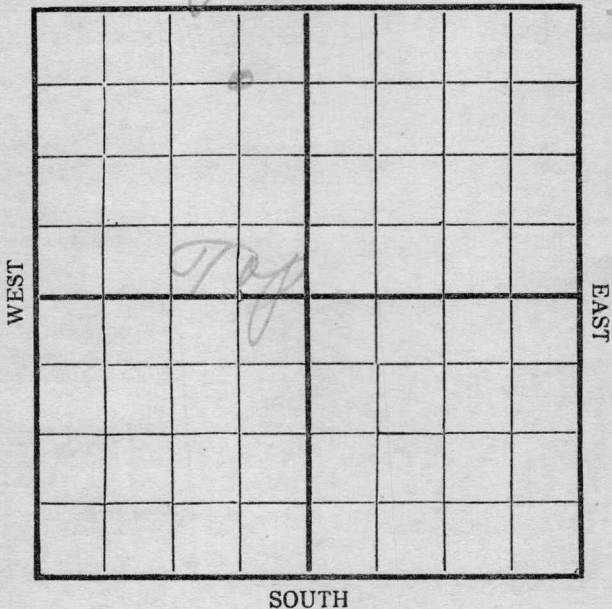


	RECORD
Location _____	Cased _____ in. _____ Ft.
Rig Up _____	Sand _____
Drilling and remarks	Gas _____
<u>Top sand</u>	Oil _____
<u>feeling coming</u>	Total Depth _____
	PRODUCTION
	1st 24 hrs. Nat. _____
	1st 24 hrs. after shot _____
	Gas _____ Cu. Ft.
	Dry Hole _____
	Abandoned _____

Date 3/12, 1917 C. A. J. Scout

Map No. _____ Sec. 2 Twp. 28 R. 4Well No. 4 Martin Farm
Empire Company

NORTH

WEST

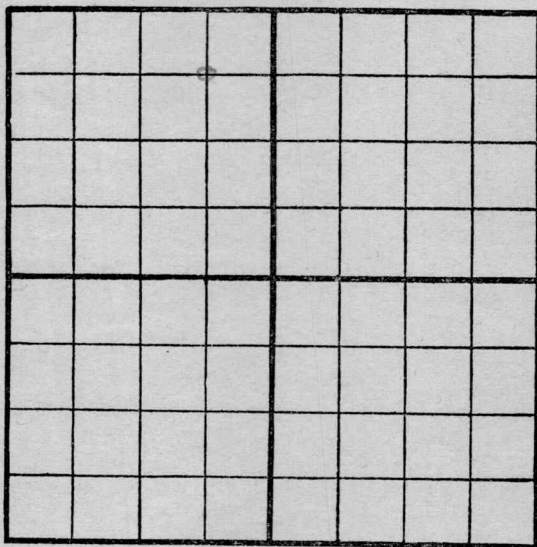

EAST

SOUTH

Location _____

Rig Up _____

Drilling and remarks

Top sand
2578'
Shut down

RECORD

Cased _____ in. _____ Ft.

Sand 2578

Gas _____

Oil _____

Total Depth _____

PRODUCTION

1st 24 hrs. Nat. _____

1st 24 hrs. after shot _____

Gas _____ Cu. Ft.

Dry Hole _____

Abandoned _____

Date

3/19, 1917 *Carroll* Scout

Map No. _____ Sec. 3 Twp. 28 R. 4
 Well No. 4 Martin Farm _____
Cummins Company _____

NORTH

WEST

EAST

SOUTH

Location _____
 Rig Up _____
 Drilling and remarks _____

Tap sand
2578'
Have had fishing
job collapsed
casing

RECORD

Cased _____ in. _____ Ft.
 Sand _____
 Gas _____
 Oil _____
 Total Depth _____

PRODUCTION

1st 24 hrs. Nat. _____
 1st 24 hrs. after shot _____
 Gas _____ Cu. Ft.
 Dry Hole _____
 Abandoned _____

Date

3/26, 1917 Candiff Scout

Map No. _____ Sec. 2 Twp. 28 R. 4


Well No. 4 Martin Farm _____

Empire Company _____

NORTH

WEST

EAST

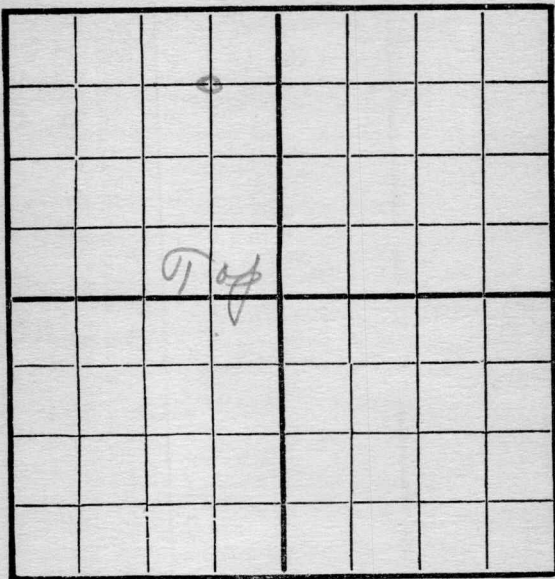

SOUTH

Location _____

Rig Up _____

Drilling and remarks

Fishing casing
2578

RECORD

Cased _____ in. _____ Ft.

Sand _____

Gas _____

Oil _____

Total Depth _____

PRODUCTION

1st 24 hrs. Nat. _____

First 24 hrs. after shot _____

Gas _____ Cu. Ft.

Dry Hole _____

Abandoned _____


Date

4/4, 1917 Cordiff Scout

Map No. _____ Sec. 2 Twp. 28 R. 4
Well No. 4 Martin Farm _____

Company _____

NORTH

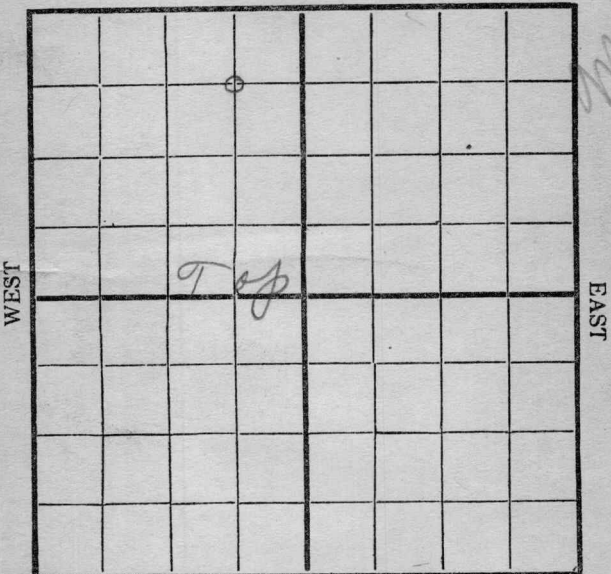

SOUTH

Location _____
Rig Up _____
Drilling and remarks
Fishing job.
Tapped
2578'

RECORD

Cased _____ in. _____ Ft.
Sand _____
Gas _____
Oil _____
Total Depth _____

PRODUCTION

1st 24 hrs. Nat. _____
1st 24 hrs. after shot _____
Gas _____ Cu. Ft.
Dry Hole _____
Abandoned _____


Date 4/10, 191 7. Conley Scout

Map No. _____ Sec. 2 Twp. 28 R. 4

Well No. 4 Northern Farm _____

Empire Company _____

NORTH

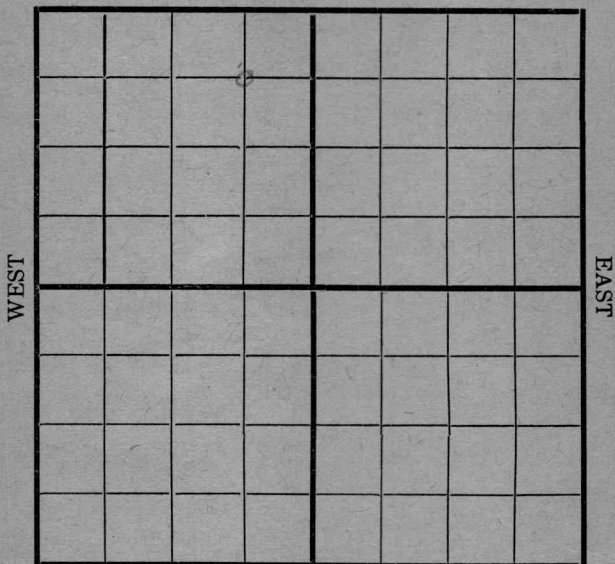

SOUTH

Location _____

Rig Up _____

Drilling and remarks

Tapped

2578

Shut Down

RECORD

Cased _____ in. _____ Ft.

Sand _____

Gas _____

Oil _____

Total Depth _____

PRODUCTION

1st 24 hrs. Nat. _____

1st 24 hrs. after shot _____

Gas _____ Cu. Ft.

Dry Hole _____


Abandoned _____

Date

4/17, 1917 Land Scout

Map No. _____ Sec. 2 Twp. 38 R. 4
 Well No. 4 Norton Farm _____
Engine Company _____

NORTH

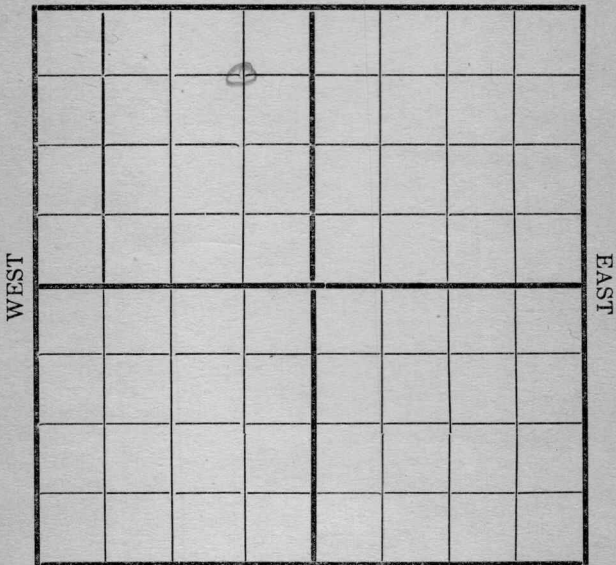

SOUTH

Location _____
 Rig Up _____
 Drilling and remarks _____

*Fishing
 for Coaling
 5578*

RECORD

Cased _____ in. _____ Ft.
 Sand _____
 Gas _____
 Oil _____
 Total Depth _____

PRODUCTION


1st 24 hrs. Nat. _____
 1st 24 hrs. after shot _____
 Gas _____ Cu. Ft.
 Dry Hole _____
 Abandoned _____

Date

4/24, 1917 Carley Scout

Map No. _____ Sec. 2 Twp. 28 R. 4
 Well No. 4 Martin Farm _____
Engine Company _____

NORTH

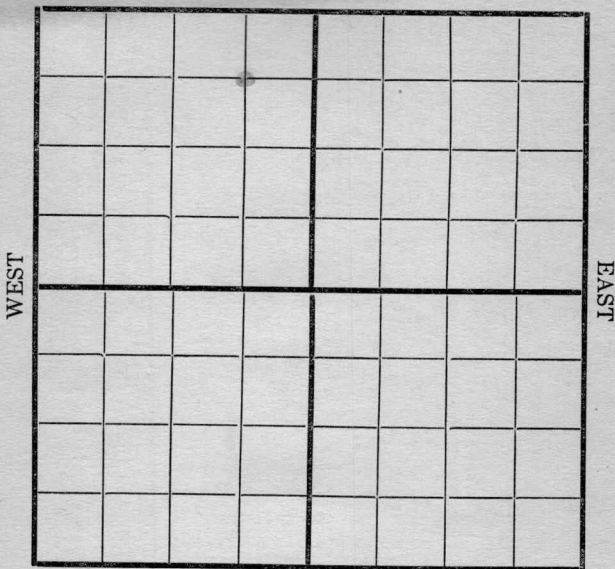

SOUTH

Location _____
 Rig Up _____
 Drilling and remarks _____

*Shut Down
 Trip and
 2578*

RECORD

Cased _____ in. _____ Ft.
 Sand _____
 Gas _____
 Oil _____
 Total Depth _____

PRODUCTION


1st 24 hrs. Nat. _____
 1st 24 hrs. after shot _____
 Gas _____ Cu. Ft.
 Dry Hole _____
 Abandoned _____

Date _____

5/2, 191 7 Carly Scout

Map No. _____ Sec. 2 Twp. 28 R. 4
 Well No. 4 North Farm _____
Engine Company _____

NORTH

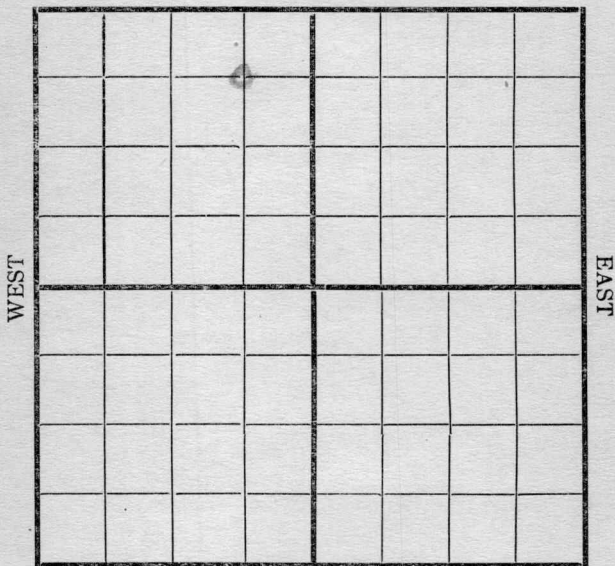

SOUTH

Location _____
 Rig Up _____
 Drilling and remarks _____

*Fishing
 top sound
 2578*

RECORD

Cased _____ in. _____ Ft.
 Sand _____
 Gas _____
 Oil _____
 Total Depth _____

PRODUCTION

1st 24 hrs. Nat. _____
 1st 24 hrs. after shot _____
 Gas _____ Cu. Ft.
 Dry Hole _____
 Abandoned _____

Date 3/8, 191 7 Early Scout

Map No. _____ Sec. 2 Twp. 28 R. 4

Well No. 4 Martin Farm _____

Cumprine Company _____

NORTH

WEST

EAST

SOUTH

Location _____

Rig Up _____

Drilling and remarks

finishing
25781

RECORD

Cased _____ in. _____ Ft.

Sand _____

Gas _____

Oil _____

Total Depth _____

PRODUCTION

1st 24 hrs. Nat. _____

1st 24 hrs. after shot _____

Gas _____ Cu. Ft.


Dry Hole _____

Abandoned _____

Date

5/25, 191 *2*. *Candys* Scout

Map No. _____ Sec. 2 Twp. 28 R. 4
 Well No. 4 Martin Farm _____
Engine Company _____
 NORTH

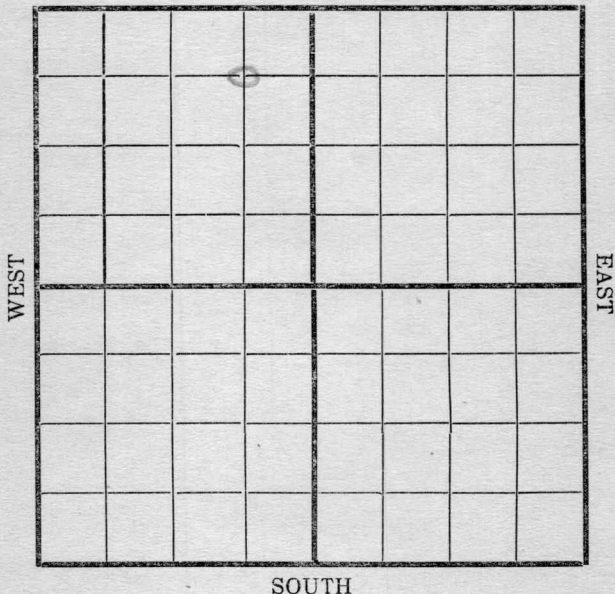

Location _____ Rig Up _____ Drilling and remarks <u>Top sand</u> <u>2578</u> <u>Casing trouble</u>	RECORD Cased _____ in. _____ Ft. Sand _____ Gas _____ Oil _____ Total Depth _____ PRODUCTION 1st 24 hrs. Nat. _____ 1st 24 hrs. after shot _____ Gas _____ Cu. Ft. Dry Hole _____ Abandoned _____
---	--


Date 5/29 1917 Carley Scout

Map No. _____ Sec. _____ Twp. _____ R. _____

Well No. _____ Farm _____

_____ Company _____

NORTH

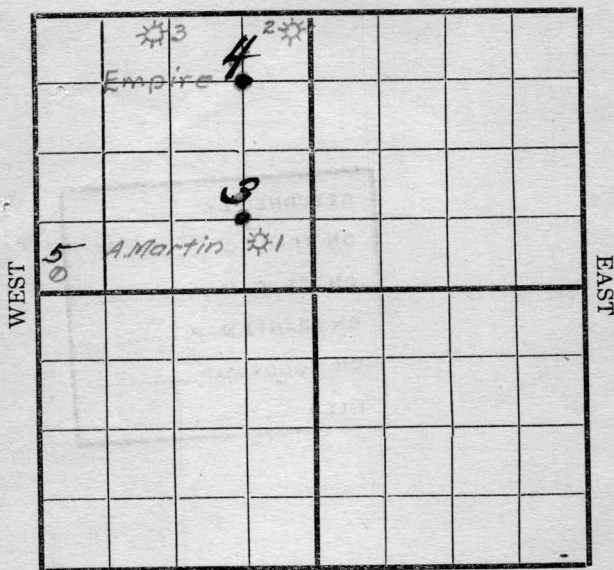

SOUTH

Location _____

Rig Up _____

Drilling and remarks

The Empire
 Dr. F. Co's numbers
 for their oil wells
 are as above
 regardless of
 gas well
 numbers
 L.C.C.

RECORD

Cased _____ in. _____ Ft.

Sand _____

Gas _____

Oil _____

Total Depth _____

PRODUCTION

1st 24 hrs. Nat. _____

1st 24 hrs. after shot _____

Gas _____ Cu. Ft.

Dry Hole _____

Abandoned _____

Date _____

_____, 191____. _____ Scout _____

Our map shows wells
numbered as on attached
Ticket. Please check
these up

RETURNED BY	_____
ON TRACING	<i>R.M.V.</i>
ON J. S. C. MAP	_____
ON FRANTZ MAP	_____
ON MOODY MAP	_____
FILED	_____

RECORD

Gas

Sand

Gas

Oil

Total Depth

PRODUCTION

1st 24 hrs. Net

1st 24 hrs. after shut

Gas

Oil

Abandoned

Location

Pin

Trilling and remarks

Remarks

Remarks

Map No. _____ Sec. 2 Twp. 28 R. 4
 Well No. H. Martin Farm _____
Enterprise Company _____
 NORTH

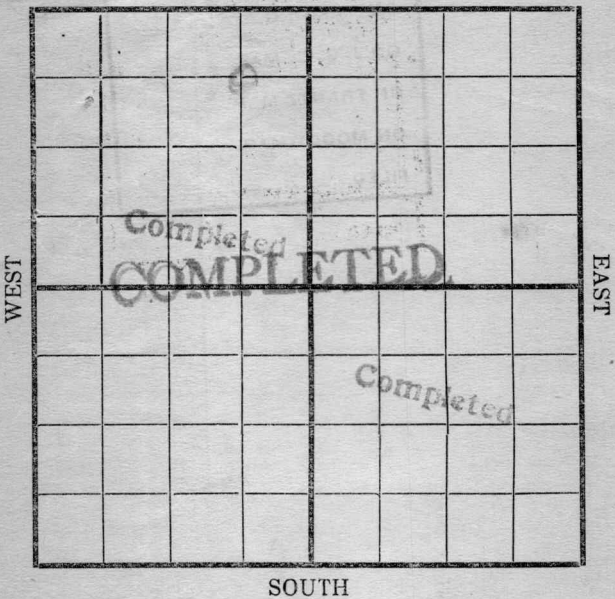

Location _____
 Rig Up _____
 Drilling and remarks
Est at
125 Bbls
Number in
O.H. - 6

RECORD
 Cased _____ in. _____ Ft.
 Sand 2578 - 2610
 Gas _____
 Oil _____
 Total Depth _____

PRODUCTION
 1st 24 hrs. Nat. _____
 1st 24 hrs. after shot _____
 Gas _____ Cu. Ft.
 Dry Hole _____
 Abandoned _____

Date 6/9, 1917 Enterprise Scout