


Map No. K Sec. 14 Twp. 24 R. 12
Well No. 7 Sullivan Farm
Honston Company

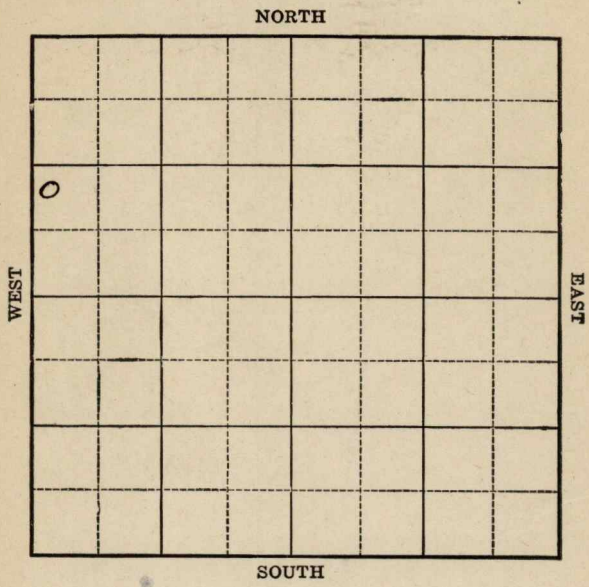

Location _____

Rig Up _____

Drilling Remarks:

Drilling Remarks:

RECORD

PRODUCTION

Cased _____ in. _____ ft.
Sand _____
Gas _____
Oil _____
Total Depth _____

1st 24 hrs. Nat. _____
1st 24 hrs. after shot _____
Gas _____ cu. ft.
Dry Hole _____
Abandoned _____

Map No. **KANSAS** 16 14 Sec. 14 Twp. 24 R. 12

Well No. 7 Sullivan

Houston Company

Contractor

FIRST REICHT

SECTION PLAT

_____ Ft. from N. Line

1120 Ft. from S. Line

_____ Ft. from E. Line

200 Ft. from W. Line

0			

Location _____

Rig up _____

Drilling and Remarks:

1000'

Top. 1725-39

150' oil

RECORD

Cased _____ in., _____ ft.

Sand _____

Gas _____

Oil _____

Total Depth _____

PRODUCTION

1st 24 hrs. Nat. _____

1st 24 hrs. after shot _____

Gas _____ Cu. Ft.

Dry Hole _____

Abandoned _____

Date

AUG 6 1924

M. A. BENEAR

192

Scout

Map No. **KANSAS** Sec. *14* Twp. *24* R. *12*

Well No. *7 Sullivan*

Houston Okla Company

Contractor

COMPLETED

SECTION PLAT

_____ Ft. from N. Line

1120 _____ Ft. from S. Line

_____ Ft. from E. Line

208 _____ Ft. from W. Line

<i>0</i>			

Location _____

Rig up _____

Drilling and Remarks:

Tap 2, 1712

Pay 1725-59

100/50 Hb

RECORD

Cased _____ in., _____ ft.

Sand _____

Gas _____

Oil _____

Total Depth _____

PRODUCTION

1st 24 hrs. Nat. _____

1st 24 hrs. after shot _____

Gas _____ Cu. Ft.

Dry Hole _____

Abandoned _____

Date

AUG 26 1924

192

M. A. BENEAR

Scout