


Map No. _____ Sec. 2 Twp. 28 R. 4
Well No. 10 Martin Farm _____
Empire Company _____

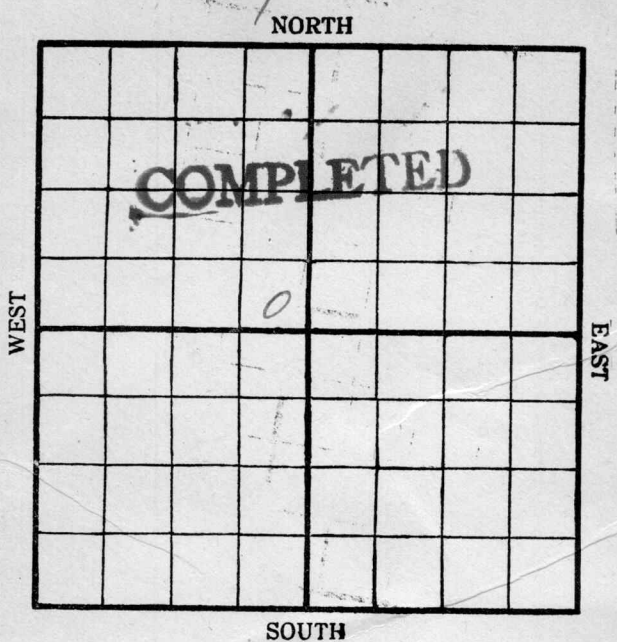

Location _____

Drilling Remarks:

RECORD

Cased _____ in. _____ ft.

Sand _____

Gas _____

Oil _____

Total Depth _____

Rig Up _____

Drilling Remarks:

PRODUCTION

1st 24 hrs. Nat. _____

1st 24 h.s. after shot _____


Gas _____ cu. ft

Dry Hole _____

Abandoned _____

1002
Map No. K11 Sec. 2 Twp. 28 R. 4
Well No. 10 meter Farm
Empire Company

NORTH

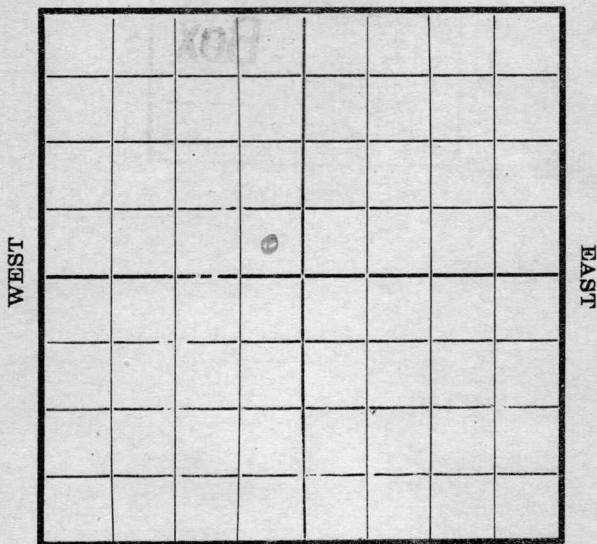

SOUTH

Location _____
Rig Up ☒ _____
Drilling and remarks _____

RECORD

Cased _____ in. _____ Ft.
Sand _____
Gas _____
Oil _____
Total Depth _____

FIRST REPORT

PRODUCTION

1st 24 hrs. Nat. _____
1st 24 hrs. after shot _____
Gas _____ Cu. Ft.
Dry Hole _____
Abandoned _____


Date

10/5, 1917 C. Condy Scout

Map No. _____ Sec. 2 Twp. 28 R. 4Well No. 10 Martin Farm _____
Engine Company _____

NORTH

WEST

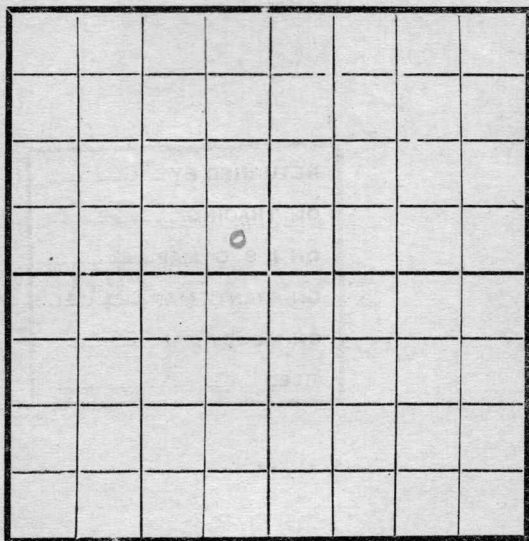

EAST

SOUTH

Location _____

Rig Up ✓ _____

Drilling and remarks

First Report

RECORD

Cased _____ in. _____ Ft.

Sand _____

Gas _____

Oil _____

Total Depth _____

PRODUCTION

1st 24 hrs. Nat. _____

1st 24 hrs. after shot _____

Gas _____ Cu. Ft.

Dry Hole _____

Abandoned _____


Date

12/28, 1917 Candys Scout

Map No. _____ Sec. 2 Twp. 28 R. 4Well No. 10 Martin Farm _____
Engine Company _____

NORTH

WEST

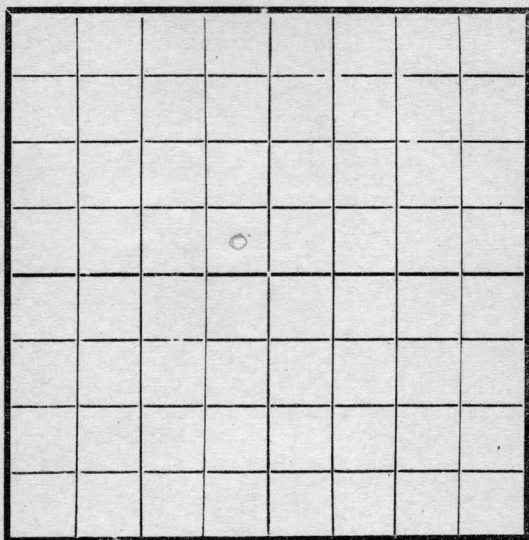

EAST

SOUTH

Location _____

Rig Up _____

Drilling and remarks

Rigging up

RECORD

Cased _____ in. _____ Ft.

Sand _____

Gas _____

Oil _____

Total Depth _____

PRODUCTION

1st 24 hrs. Nat. _____

1st 24 hrs. after shot _____

Gas _____ Cu. Ft.

Dry Hole _____

Abandoned _____


Date

1/2, 1918 Candell Scout

Map No. _____ Sec. 2 Twp. 28 R. 4Well No. 10 Martin Farm
Empire Company

NORTH

WEST

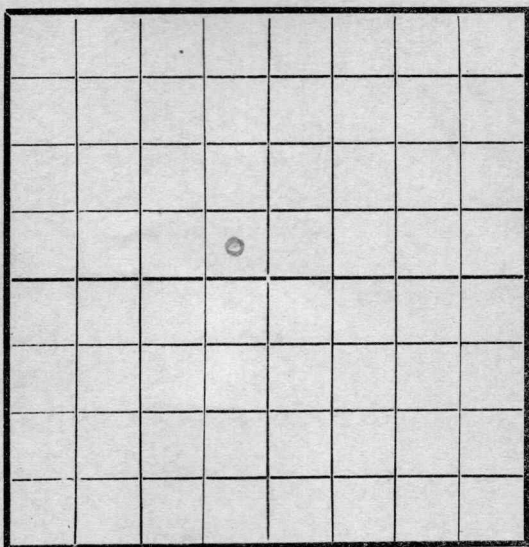

EAST

SOUTH

Location _____

Rig Up _____

Drilling and remarks

*Rigging
up*

RECORD

Cased _____ in. _____ Ft.

Sand _____

Gas _____

Oil _____

Total Depth _____

PRODUCTION

1st 24 hrs. Nat. _____

1st 24 hrs. after shot _____

Gas _____ Cu. Ft.

Dry Hole _____

Abandoned _____


Date

1/9, 1918 C. C. C. C. Scout

Map No. _____ Sec. 2 Twp. 28 R. 4Well No. 10 Martin FarmEmpire Company

NORTH

WEST

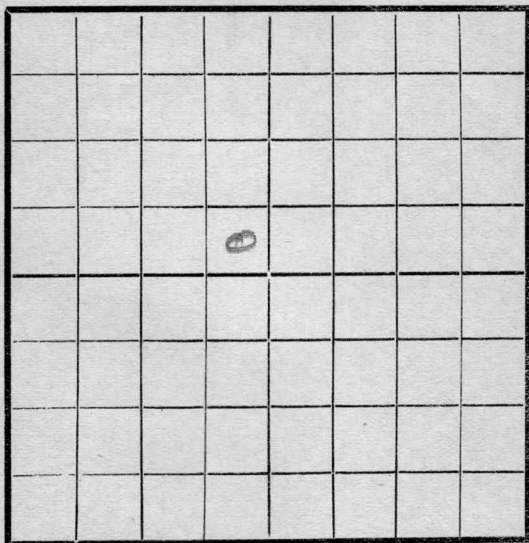

EAST

SOUTH

Location _____

Rig Up _____

Drilling and remarks

*Rigging
up*

RECORD

Cased _____ in. _____ Ft.

Sand _____

Gas _____

Oil _____

Total Depth _____

PRODUCTION

1st 24 hrs. Nat. _____

1st 24 hrs. after shot _____

Gas _____ Cu. Ft.

Dry Hole _____

Abandoned _____


Date

1/16, 1918 Candy Scout

Map No. _____ Sec. 2 Twp. 28 R. 4Well No. 10 Martin Farm
Empire Company

NORTH

WEST

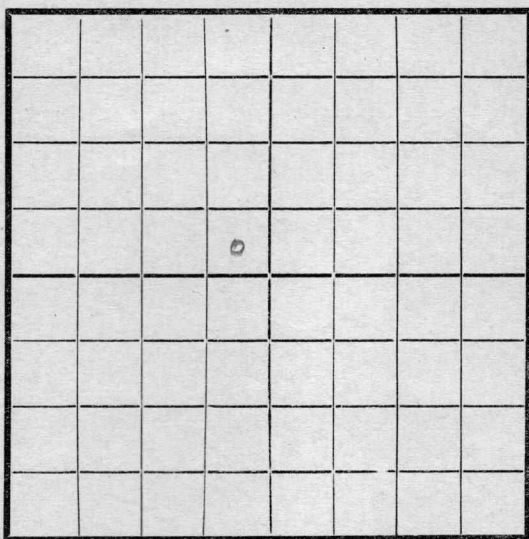

EAST

SOUTH

Location _____

Rig Up _____

Drilling and remarks

RECORD

Cased _____ in. _____ Ft.

Sand _____

Gas _____

Oil _____

Total Depth _____

PRODUCTION

1st 24 hrs. Nat. _____

1st 24 hrs. after shot _____

Gas _____ Cu. Ft.

Dry Hole _____

Abandoned _____


Date

2/3, 1918 Candry Scout

Map No. _____ Sec. 2 Twp. 28 R. 4Well No. 10 _____ Farm
Engine Company

NORTH

WEST

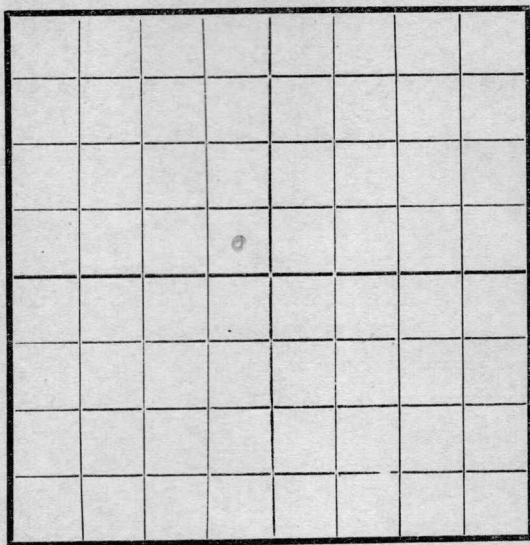

EAST

SOUTH

Location _____

Rig Up _____

Drilling and remarks

740

RECORD

Cased _____ in. _____ Ft.

Sand _____

Gas _____

Oil _____

Total Depth _____

PRODUCTION

1st 24 hrs. Nat. _____

1st 24 hrs. after shot _____

Gas _____ Cu. Ft.

Dry Hole _____


Abandoned _____

Date

730, 1918 Conley Scout

Map No. _____ Sec. 2 Twp. 28 R. 4
 Well No. 10 Martin Farm _____
 _____ Company

NORTH

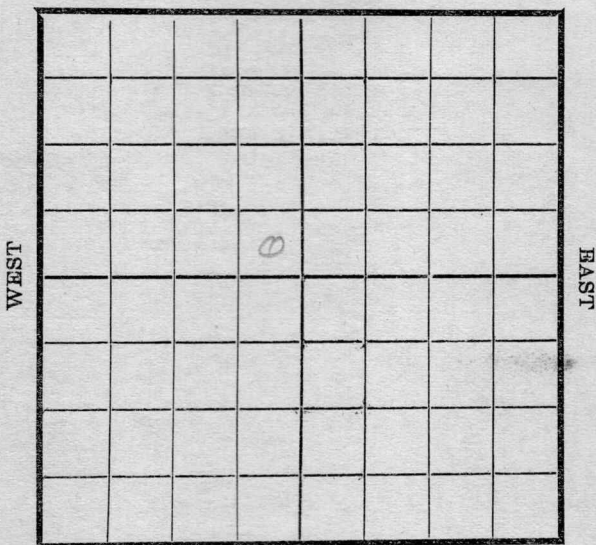

SOUTH


Location _____ Rig Up _____ Drilling and remarks <u>1315</u>	RECORD
	Cased _____ in. _____ Ft.
	Sand _____
	Gas _____
	Oil _____
	Total Depth _____
	PRODUCTION
	1st 24 hrs. Nat. _____
	1st 24 hrs. after shot _____
	Gas _____ Cu. Ft.
	Dry Hole _____
	Abandoned _____

Date 7/27, 1918 S. Condy Scout

Map No. _____ Sec. 2 Twp. 28 R. 4
 Well No. 10 Martin Farm _____
Empire Company

NORTH

WEST

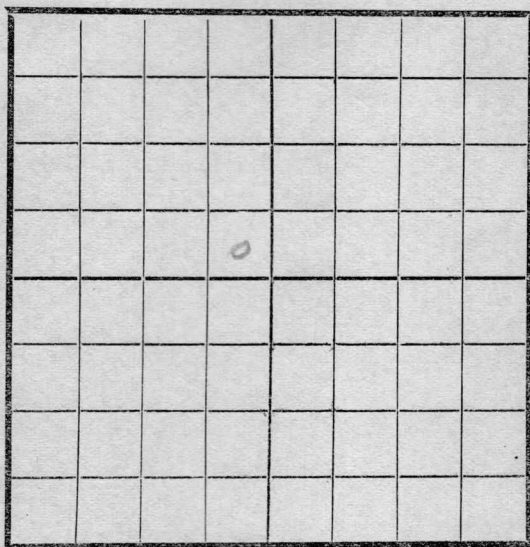

EAST

SOUTH

Location _____
 Rig Up _____
 Drilling and remarks

1815-

RECORD

Cased _____ in. _____ Ft.
 Sand _____
 Gas _____
 Oil _____
 Total Depth _____


PRODUCTION

1st 24 hrs. Nat. _____
 1st 24 hrs. after shot _____
 Gas _____ Cu. Ft.
 Dry Hole _____
 Abandoned _____

Date 3/6, 1918 S. Canby Scout

Map No. _____ Sec. 2 Twp. 28 R. 4
 Well No. 10 Martin Farm _____
Cumprine Company _____
 NORTH

WEST

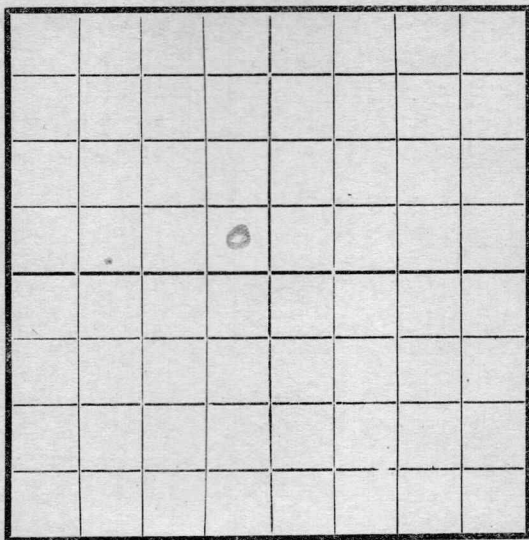

EAST

SOUTH

Location _____
 Rig Up _____
 Drilling and remarks _____

RECORD

Cased _____ in. _____ Ft.
 Sand _____
 Gas _____
 Oil _____
 Total Depth _____

PRODUCTION

1st 24 hrs. Nat. _____
 1st 24 hrs. after shot _____
 Gas _____ Cu. Ft.
 Dry Hole _____
 Abandoned _____

Date

3/13, 1918 Scout

Map No. _____ Sec. 1 Twp. 28 R. 4

Well No. 10 _____ Farm _____

Carpine Company

NORTH

WEST

EAST

SOUTH

Location -----

Rig Up -----

Drilling and remarks

2175

RECORD

Cased_____ in._____Ft.

Sand

Gas _____

Oil _____

Total Depth -----

PRODUCTION

1st 24 hrs. Nat.-----

1st 24 hrs. after shot-----

Gas ----- Cu. Ft.

Dry Hole -----

Abandoned -----

Date _____

3/20 1918 C. C. C. Scout


Map No. _____ Sec. 2 Twp. 38 R. 4

Well No. 10 within Farm _____

Engine Company _____

NORTH

WEST

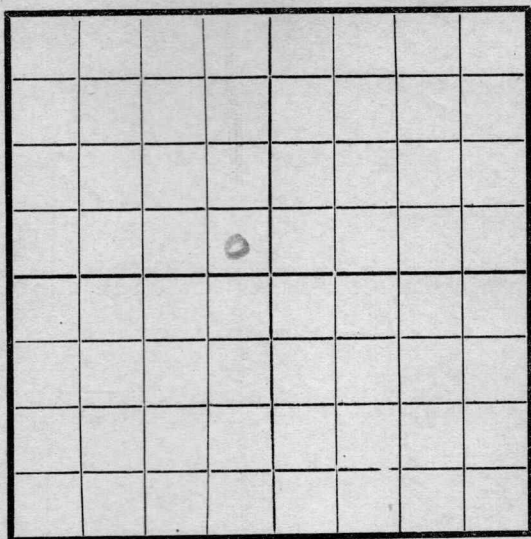

EAST

SOUTH

Location _____

Rig Up _____

Drilling and remarks

2300

RECORD

Cased _____ in. _____ Ft.

Sand _____

Gas _____

Oil _____

Total Depth _____

PRODUCTION

1st 24 hrs. Nat. _____

1st 24 hrs. after shot _____

Gas _____ Cu. Ft.

Dry Hole _____

Abandoned _____


Date

3/27, 1918 J. C. C. C. Scout

Map No. K11 Sec. 2 Twp. 28 R. 4Well No. 10 Martin Farm
Empire Company

NORTH

WEST

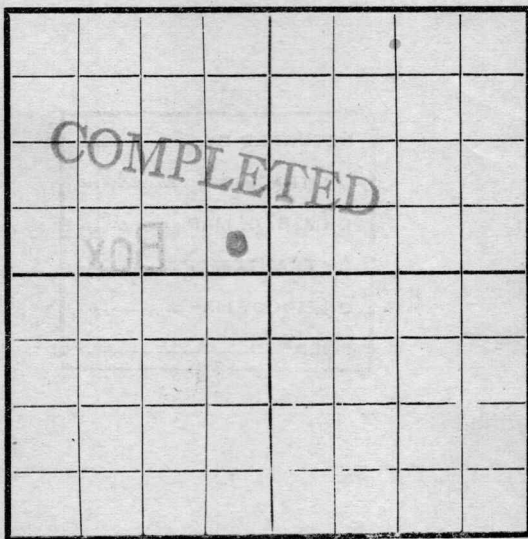

EAST

SOUTH

Location -----

Rig Up -----

Drilling and remarks

Est at
70 Bbls

RECORD

Cased ----- in. ----- Ft.

Sand 2559-2575

Gas -----

Oil -----

Total Depth -----

PRODUCTION

1st 24 hrs. Nat. -----

1st 24 hrs. after shot -----

Gas ----- Cu. Ft.

Dry Hole -----

Abandoned -----

Date

APR 5 1918

Scout