


Map No. _____ Sec. 3 Twp. 28 R. 4Well No. H. Beck Farm _____Wenden Company _____

NORTH

WEST

EAST

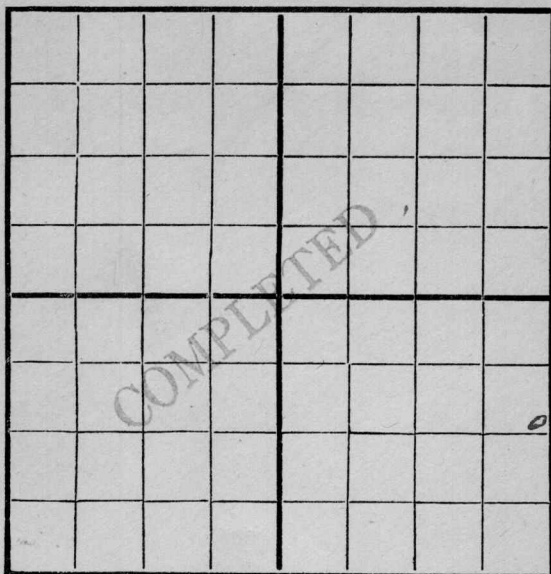

SOUTH

Location _____

Rig Up 11-27-16

Drilling Remarks:

Drilling Remarks:

Q. 12/4 = 12/11 = 12/18 = 12/28 = 1/8/17
Q. 1/18

RECORD

Cased _____ in _____ Ft.

Sand _____

Gas _____

Oil _____

Total Depth _____

PRODUCTION

1st 24 hrs. Nat. _____

1st 24 hrs. after shot _____

Gas _____ Cu. Ft.

Dry Hole _____


Abandoned _____

Map No. _____ Sec. 3 Twp. 28 R. 4
 Well No. 413000 Farm _____
 _____ Company _____

NORTH

WEST

EAST

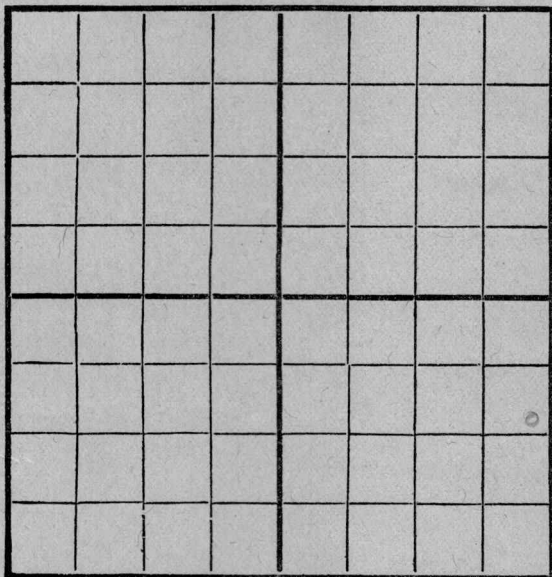

SOUTH

Location _____
 Rig Up ☒ _____
 Drilling and remarks _____

RECORD

Cased _____ in. _____ Ft.
 Sand _____
 Gas _____
 Oil _____
 Total Depth _____

PRODUCTION


1st 24 hrs. Nat. _____
 First 24 h. s. after shot _____
 Gas _____ Cu. Ft.
 Dry Hole _____
 Abandoned _____

Date

10/30, 1916 6. Reed Scout

Map No. _____ Sec. 3 Twp. 28 R. 4
 Well No. 4 Beck Farm _____
Cooder Company _____

NORTH

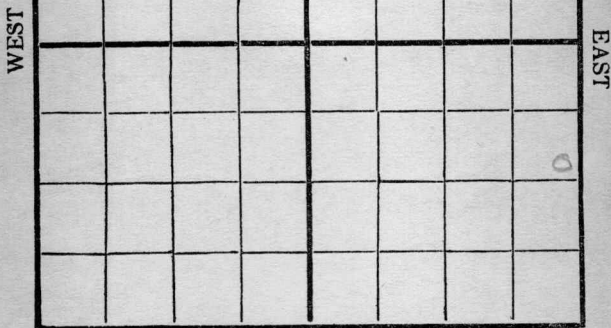

SOUTH

Location _____
 Rig Up _____
 Drilling and remarks _____

RECORD

Cased _____ in. _____ Ft.
 Sand _____
 Gas _____
 Oil _____
 Total Depth _____

PRODUCTION


1st 24 hrs. Nat. _____
 1st 24 hrs. after shot _____
 Gas _____ Cu. Ft.
 Dry Hole _____
 Abandoned _____

Date 11/20, 1916 Cooder Scout

Map No. _____ Sec. 3 Twp. 28 R. 4
 Well No. 4 Beck Farm _____
Paden Company _____

NORTH

WEST

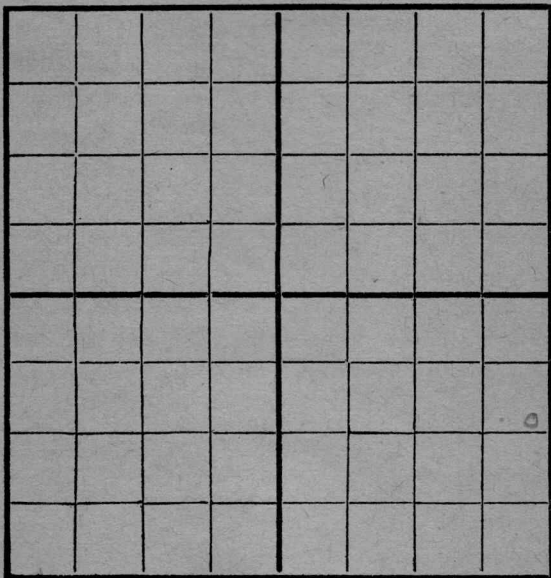

EAST

SOUTH

Location _____
 Rig Up ☒
 Drilling and remarks _____

RECORD

Cased _____ in. _____ Ft.
 Sand _____
 Gas _____
 Oil _____
 Total Depth _____

PRODUCTION

1st 24 hrs. Nat. _____
 1st 24 hrs. after shot _____
 Gas _____ Cu. Ft.
 Dry Hole _____
 Abandoned _____


Date

11/27, 1916 Condy Scout

Map No. _____ Sec. 3 Twp. 28 R. 4
 Well No. 4 Bear Farm _____
Cooden Company _____

NORTH

WEST

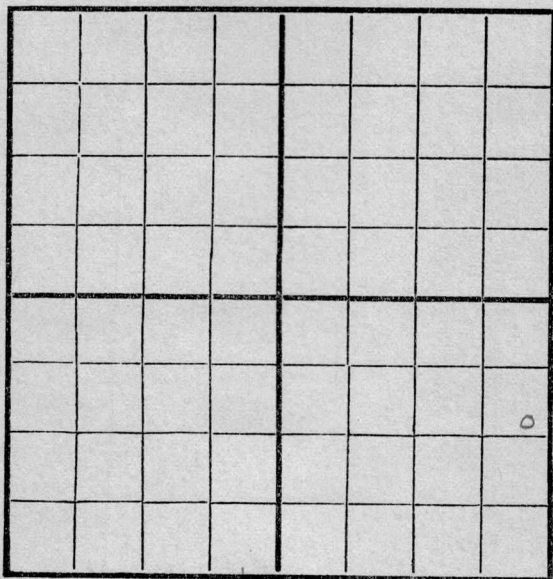

EAST

SOUTH

Location ☒ _____
 Rig Up _____
 Drilling and remarks _____

RECORD

Cased _____ in. _____ Ft.
 Sand _____
 Gas _____
 Oil _____
 Total Depth _____

PRODUCTION

1st 24 hrs. Nat. _____
 1st 24 hrs. after shot _____
 Gas _____ Cu. Ft.
 Dry Hole _____
 Abandoned _____

Date


12/4, 1916, Cooden Scout

Map No. _____ Sec. 3 Twp. 28 R. 4Well No. 4 Bear Farm _____Cosden Company _____

NORTH

WEST

EAST

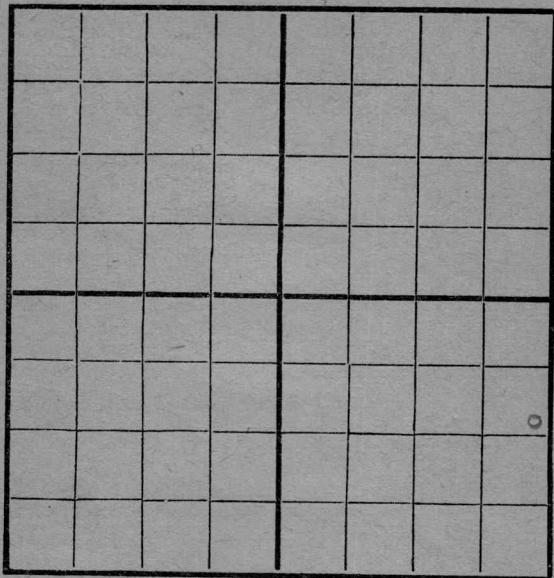

SOUTH

Location _____

Rig Up ☒ _____

Drilling and remarks _____

RECORD

Cased _____ in. _____ Ft.

Sand _____

Gas _____

Oil _____

Total Depth _____

PRODUCTION

1st 24 hrs. Nat. _____

1st 24 hrs. after shot _____

Gas _____ Cu. Ft.

Dry Hole _____


Abandoned _____

Date

12/11, 1916 Cosden Scout

Map No. _____ Sec. 3 Twp. 28 R. 4
 Well No. 41300 Farm _____
Cooden Company _____

NORTH

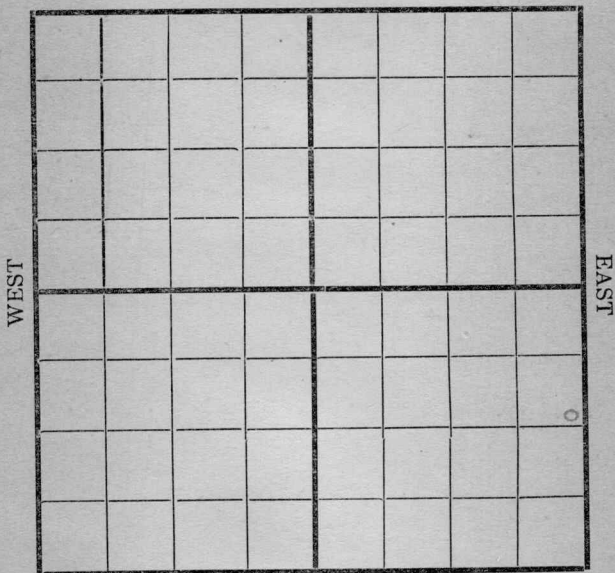

SOUTH

Location _____
 Rig Up _____
 Drilling and remarks _____

RECORD

Cased _____ in. _____ Ft.
 Sand _____
 Gas _____
 Oil _____
 Total Depth _____

PRODUCTION

1st 24 hrs. Nat. _____
 1st 24 hrs. after shot _____
 Gas _____ Cu. Ft.
 Dry Hole _____
 Abandoned _____


Date 12/18/1916 Cooden Scout

Map No. _____ Sec. 3 Twp. 28 R. 4
 Well No. 413000 Farm _____
Carle Company _____

NORTH

WEST

EAST

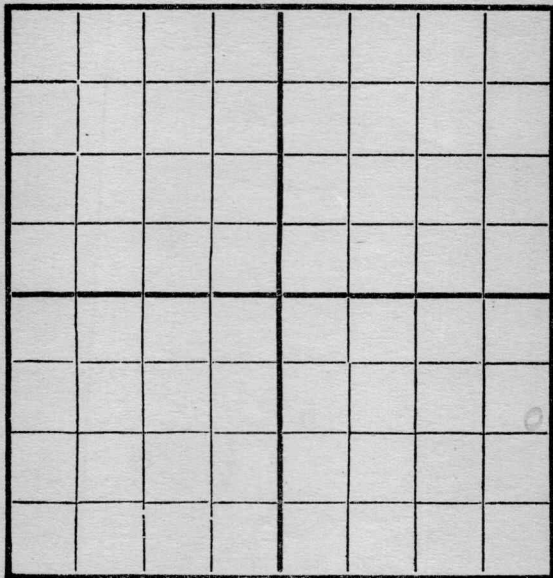

SOUTH

Location _____
 Rig Up ☒ _____
 Drilling and remarks _____

RECORD

Cased _____ in. _____ Ft.
 Sand _____
 Gas _____
 Oil _____
 Total Depth _____

PRODUCTION

1st 24 hrs. Nat. _____
 First 24 hrs. after shot _____
 Gas _____ Cu. Ft.
 Dry Hole _____
 Abandoned _____


Date

12/28, 1916 Carle Scout

Map No. _____ Sec. 3 Twp. 28 R. 4
 Well No. 413 Beck Farm _____
Overton Company

NORTH

WEST

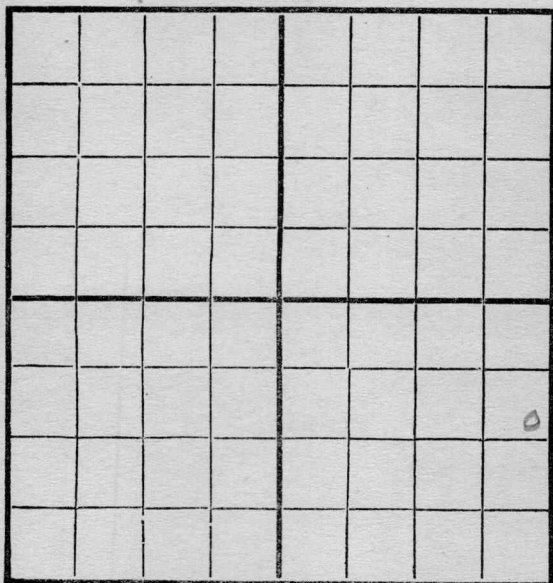

EAST

SOUTH

Location _____
 Rig Up _____
 Drilling and remarks _____

RECORD

Cased _____ in. _____ Ft.
 Sand _____
 Gas _____
 Oil _____
 Total Depth _____

PRODUCTION

1st 24 hrs. Nat. _____
 First 24 hrs. after shot _____
 Gas _____ Cu. Ft.
 Dry Hole _____
 Abandoned _____

Date

1/1, 1917 Overton Scout

Map No. _____ Sec. 3 Twp. 28 R. 4

Well No. 4 Beck Farm _____

_____ Company

NORTH

[illegible]

SOUTH

Location _____

Rig Up ☒

Drilling and remarks

RECORD

Cased_____in. _____Ft.

Sand _____

Gas _____

Oil

Total Depth-----

PRODUCTION

1st 24 hrs. Nat. _____

1st 24 hrs. after shot-----

Gas-----Cu. Ft.

Dry Hole-----

Abandoned_ _ _ _ _

Date _____


1/2, 1917, Quincy Scout

Map No. _____ Sec. 3 Twp. 28 R. 4Well No. 41 Beck Farm _____Cooder Company _____

NORTH

WEST

EAST

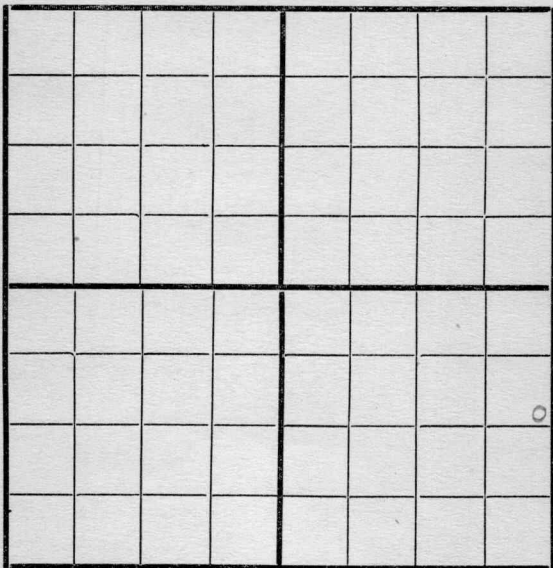

SOUTH

Location _____

Rig Up ☒ _____

Drilling and remarks

Rigging

RECORD

Cased _____ in. _____ Ft.

Sand _____

Gas _____

Oil _____

Total Depth _____

PRODUCTION

1st 24 hrs. Nat. _____

1st 24 hrs. after shot _____

Gas _____ Cu. Ft.

Dry Hole _____


Abandoned _____

Date

1/18, 1917 Cooder Scout

Map No. _____ Sec. 3 Twp. 28 R. 4
 Well No. 41 Bick Farm _____
Cooder Company _____

NORTH

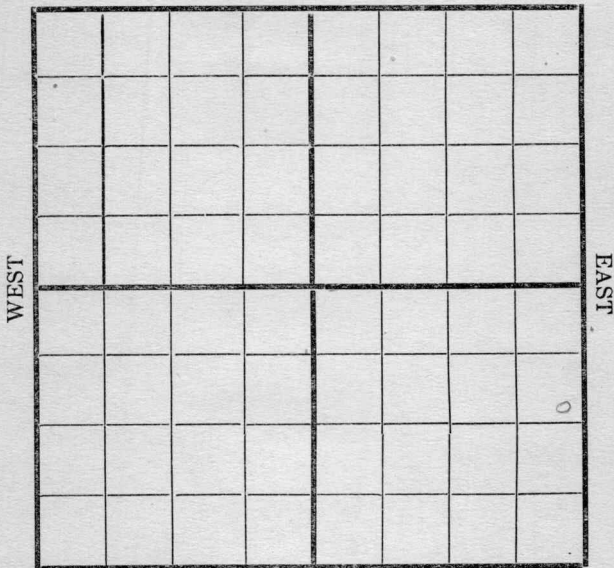

SOUTH

Location _____

Rig Up _____

Drilling and remarks

Shut Down
No water to
drill with

RECORD

Cased _____ in. _____ Ft.

Sand _____

Gas _____

Oil _____

Total Depth _____

PRODUCTION

1st 24 hrs. Nat. _____

1st 24 hrs. after shot _____

Gas _____ Cu. Ft.

Dry Hole _____

Abandoned _____

Date

1/25, 1917 Cooder Scout

Map No. _____ Sec. 3 Twp. 28 R. 4Well No. 4 Beck Farm _____

_____ Company _____

NORTH

WEST

EAST

SOUTH

Location _____

Rig Up _____

Drilling and remarks

400'

RECORD

Cased _____ in. _____ Ft.

Sand _____

Gas _____

Oil _____

Total Depth _____

PRODUCTION

1st 24 hrs. Nat. _____

1st 24 hrs. after shot _____

Gas _____ Cu. Ft.

Dry Hole _____

Abandoned _____

Date


3/9, 1917Cord Scout

Map No. _____ Sec. 3 Twp. 28 R. 4
 Well No. 41 Bear Farm _____
Cosper Company _____

NORTH

WEST

EAST

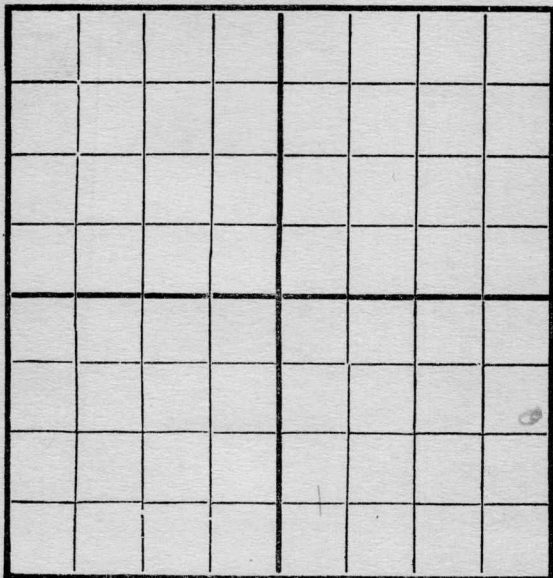

SOUTH

Location _____
 Rig Up _____
 Drilling and remarks _____

RECORD

Cased _____ in. _____ Ft.
 Sand _____
 Gas _____
 Oil _____
 Total Depth _____

PRODUCTION


1st 24 hrs. Nat. _____
 First 24 hrs. after shot _____
 Gas _____ Cu. Ft.
 Dry Hole _____
 Abandoned _____

Date

2/8, 191 ? Cosper Scout

Map No. _____ Sec. 3 Twp. 28 R. 4
 Well No. 4 Beak Farm _____
Cookson Company _____

NORTH

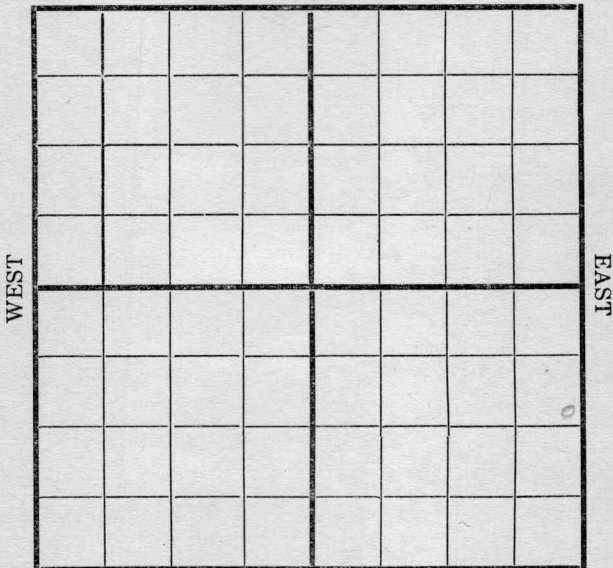

SOUTH

Location _____ Rig Up _____ Drilling and remarks _____ 	RECORD
	Cased _____ in. _____ Ft.
	Sand _____
	Gas _____
	Oil _____
	Total Depth _____
	PRODUCTION
	1st 24 hrs. Nat. _____
	1st 24 hrs. after shot _____
	Gas _____ Cu. Ft.
	Dry Hole _____
	Abandoned _____


Date 2/15, 1911 Scout

Map No. _____ Sec. 3 Twp. 28 R. 4
 Well No. 413000 Farm _____
Casden Company _____

NORTH

WEST

EAST

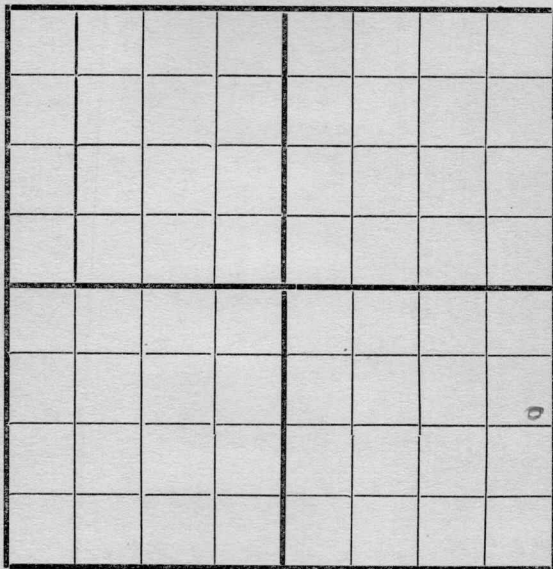

SOUTH

Location _____
 Rig Up _____
 Drilling and remarks _____

RECORD

Cased _____ in. _____ Ft.
 Sand _____
 Gas _____
 Oil _____
 Total Depth _____

PRODUCTION

1st 24 hrs. Nat. _____
 1st 24 hrs. after shot _____
 Gas _____ Cu. Ft.
 Dry Hole _____
 Abandoned _____

Date

3/2/47 191 Casden Scout


Map No. _____ Sec. 3 Twp. 28 R. 4

Well No. 4 Beck Farm _____
Co-den Company _____

NORTH

WEST

EAST

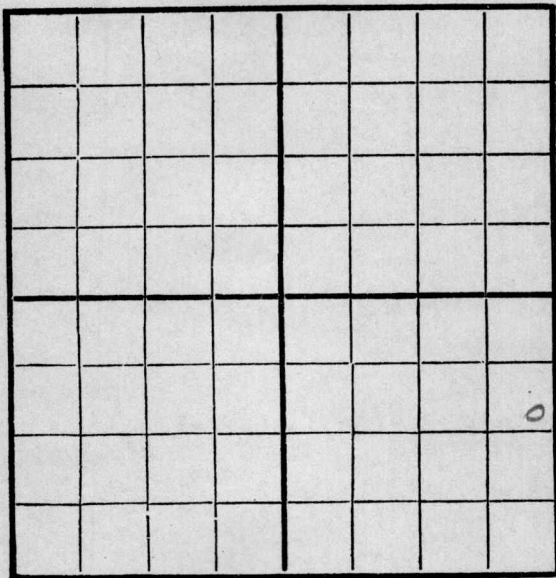

SOUTH

REMARKS:

1100'


Date

3/7, 1917

Co-den Scout

Map No. _____ Sec. 3 Twp. 28 R. 4
Well No. 4 Beat Farm _____
Cascade Company _____

NORTH

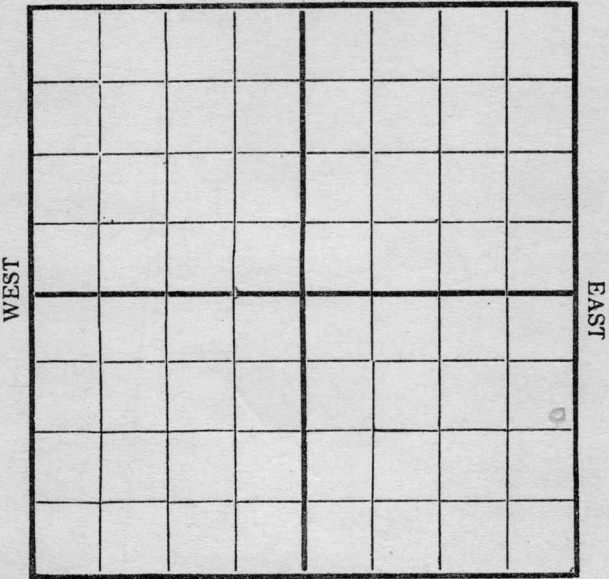

SOUTH

Location _____ Rig Up _____ Drilling and remarks <u>1610'</u>	RECORD
	Cased _____ in. _____ Ft.
	Sand _____
	Gas _____
	Oil _____
	Total Depth _____
	PRODUCTION
	1st 24 hrs. Nat. _____
	1st 24 hrs. after shot _____
	Gas _____ Cu. Ft.
	Dry Hole _____
	Abandoned _____

Date 3/15, 191 7 Cascade Scout


Scout

Map No. _____ Sec. 3 Twp. 28 R. 4
Well No. 4 Black Farm _____
Coader Company _____

NORTH

WEST

EAST

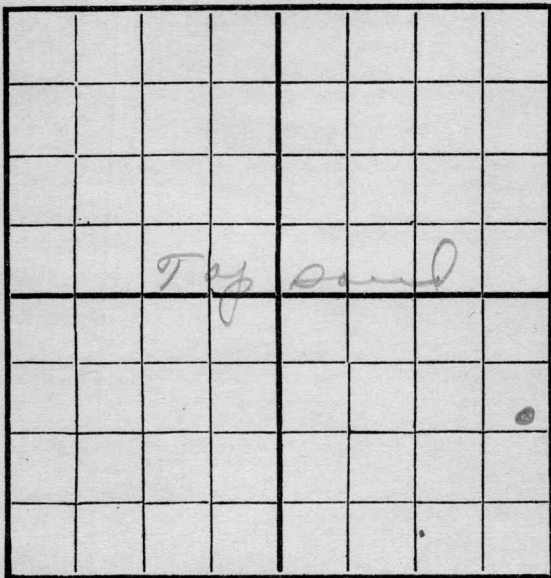

SOUTH

Location _____

Rig Up _____

Drilling and remarks

*Top sand 2550?
will get steel
line measure
much later*

RECORD

Cased _____ in. _____ Ft.

Sand _____

Gas _____

Oil _____

Total Depth _____

PRODUCTION

1st 24 hrs. Nat. _____

1st 24 hrs. after shot _____

Gas _____ Cu. Ft.

Dry Hole _____

Abandoned _____


Date

3/28, 1917 Cady Scout

Map No. _____ Sec. 3 Twp. 28 R. 4
 Well No. H Beck Farm _____
Cosden Company _____

NORTH

WEST

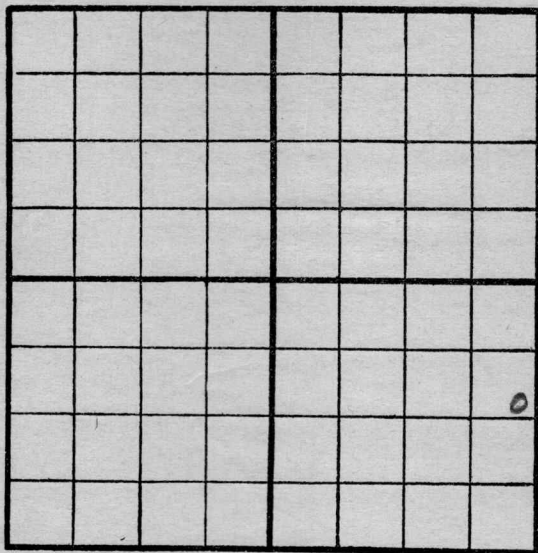

EAST

SOUTH

Location _____
 Rig Up _____
 Drilling and remarks _____

*Cased and
 getting ready
 to drill in*

RECORD

Cased _____ in. _____ Ft.
 Sand _____
 Gas _____
 Oil _____
 Total Depth _____

PRODUCTION

1st 24 hrs. Nat. _____
 1st 24 hrs. after shot _____
 Gas _____ Cu. Ft.
 Dry Hole _____
 Abandoned _____

Date 3/31, 1917

Cosden Scout

Map No. _____ Sec. 3 Twp. 28 R. 4
Well No. 4 Bear Farm _____
Cosden Company _____

NORTH

WEST

EAST

COMPLETED

SOUTH

Location _____
Rig Up _____
Drilling and remarks _____

Estimated
at 150 Bbl.

RECORD

Cased _____ in. _____ Ft.
Sand 2581 - 2594
Gas _____
Oil _____
Total Depth _____

PRODUCTION

1st 24 hrs. Nat. _____
First 24 hrs. after shot _____
Gas _____ Cu. Ft.
Dry Hole _____
Abandoned _____

Date

4/4, 1917 *Carley* Scout