


LOCATION NOTICE

TULSA, OKLA., March 26, 1946, 19.....

WELL NO. 20 ON D. J. Sullivan FARM

WILL BE AS FOLLOWS:

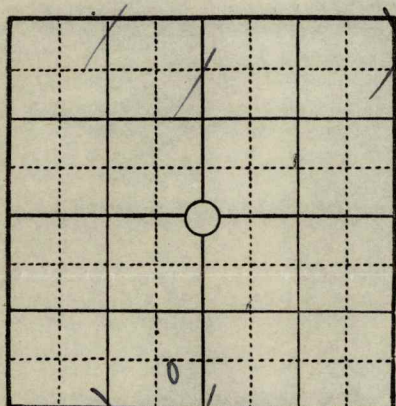

..... FEET FROM NORTH LINE
 330 FEET FROM EAST LINE
 330 FEET FROM SOUTH LINE
 FEET FROM WEST LINE
E 1/2 W 1/2 & N 1/2 N 1/2 NE 1/4
 IN SEC. 14 TWP. 24S RANGE 12E
Greenwood COUNTY, STATE OF Kansas

REMARKS: Lloyd Snyder, Dist. Supt
J. G. Vorhees, Foreman

SIGNED A. E. PIERCE

COPIES TO

- DISTRICT SUPT.
- ACCOUNTING DEPT.
- RENTAL DEPT.
- SCOUTING DEPT.
- ENGINEERING DEPT.
- LEGAL DEPT.
- LEASE INVENTORY
- CLAIM DEPT.
- TAX DEPT.
- GEOLOGICAL DEPT.
- PURCHASING DEPT.
- PIPE LINE DEPT.
- PRIORITIES DEPT.
- FILE

Handwritten signature: W. H. H. H.

*Handwritten note: Carbon
 Mic. Small Maps.*