


Map No. _____ Sec. 3 Twp. 28 R. 4Well No. 3 Beck Farm _____Lowden Company _____

NORTH

WEST

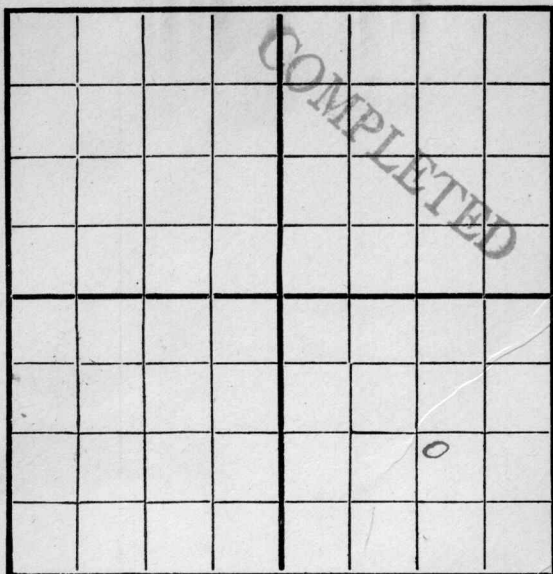

EAST

SOUTH

Location _____

Drilling Remarks

10/11 =10/17 = 35010/24 = 83011/9 = 125011/14 = 148511/27 = 194512/4 = 241512/14 = 265412/18 = 2625 12/28Rig Up 10/2

Drilling Remarks

RECORD

Cased _____ in. _____ Ft.

Sand _____

Gas _____

Oil _____

Total Depth _____

PRODUCTION

1st 24 hrs. Nat. _____

1st 24 hrs. after shot _____

Gas _____ Cu. Ft.

Dry Hole _____

Abandoned _____

Map No. _____ Sec. 3 Twp. 28 R. 4Well No. 3 Beck Farm _____

Company _____

NORTH

WEST

EAST

SOUTH

Location _____

Rig Up _____

Drilling and remarks _____

RECORD

Cased _____ in. _____ Ft.

Sand _____

Gas _____

Oil _____

Total Depth _____

PRODUCTION

1st 24 hrs. Nat. _____

First 24 hrs. after shot _____

Gas _____ Cu. Ft.

Dry Hole _____

Abandoned _____

Date


9/27, 1916 W. A. Dep Scout

Map No. _____ Sec. 3 Twp. 28 R. 4Well No. 3 Beck _____ Farm

_____ Company

NORTH

WEST

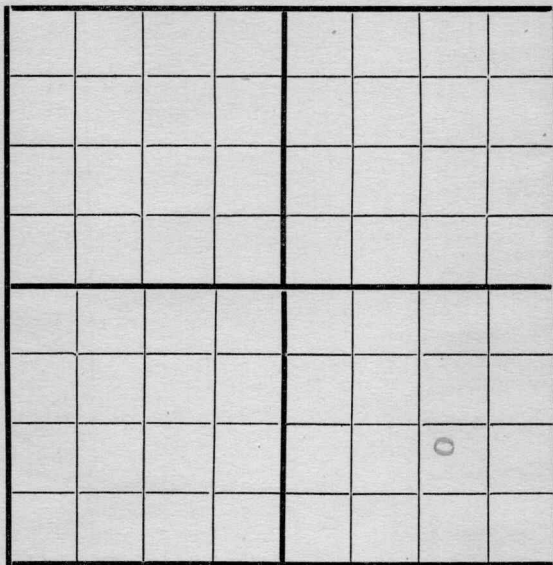

EAST

SOUTH

Location _____

Rig Up _____

Drilling and remarks _____

RECORD

Cased _____ in. _____ Ft.

Sand _____

Gas _____

Oil _____

Total Depth _____

PRODUCTION

1st 24 hrs. Nat. _____

1st 24 hrs. after shot _____

Gas _____ Cu. Ft.

Dry Hole _____

Abandoned _____


Date

10/2, 1916 Scout

Map No. _____ Sec. 3 Twp. 28 R. 4
 Well No. Bessie Farm _____
Quincy Company _____

NORTH

WEST

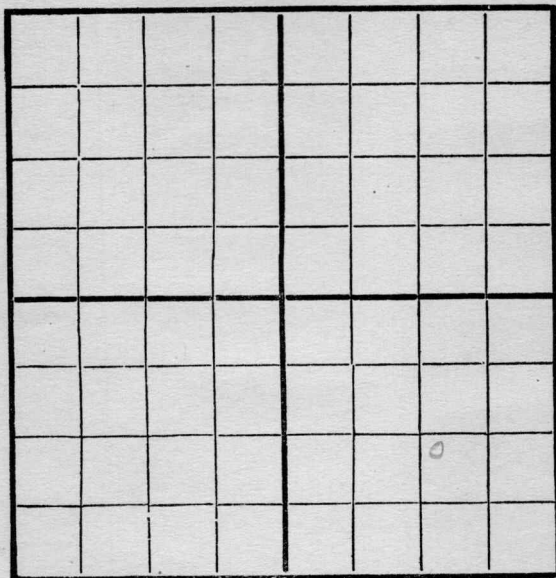

EAST

SOUTH

Location _____
 Rig Up _____
 Drilling and remarks _____

RECORD

Cased _____ in. _____ Ft.
 Sand _____
 Gas _____
 Oil _____
 Total Depth _____

PRODUCTION


1st 24 hrs. Nat. _____
 First 24 hrs. after shot _____
 Gas _____ Cu. Ft.
 Dry Hole _____
 Abandoned _____

Date

10/11, 1916 Scout

Map No. _____ Sec. 3 Twp. 28 R. 4
 Well No. 3 Beck Farm _____
Cosden Company _____

NORTH

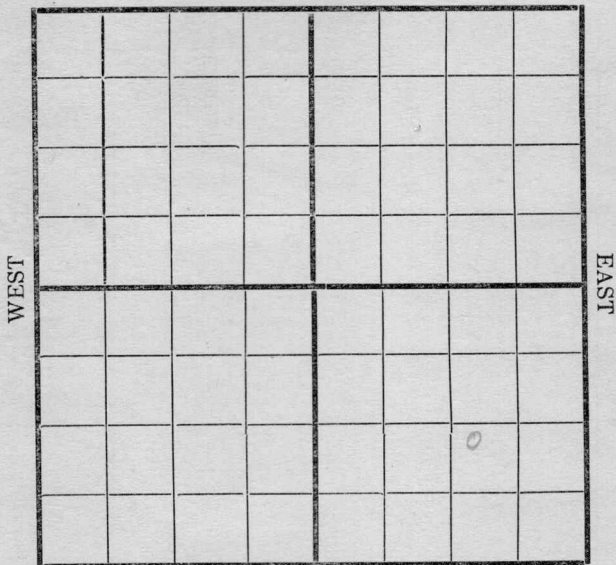

SOUTH

Location _____ Rig Up _____ Drilling and remarks <u>350</u>	RECORD
	Cased _____ in. _____ Ft.
	Sand _____
	Gas _____
	Oil _____
	Total Depth _____
	PRODUCTION
	1st 24 hrs. Nat. _____
	1st 24 hrs. after shot _____
	Gas _____ Cu. Ft.
	Dry Hole _____
	Abandoned _____

Date

10/17/1916 Scout Beck


Map No. _____ Sec. 3 Twp. 38 R. 4Well No. 3 Beck Farm _____

_____ Company _____

NORTH

WEST

EAST

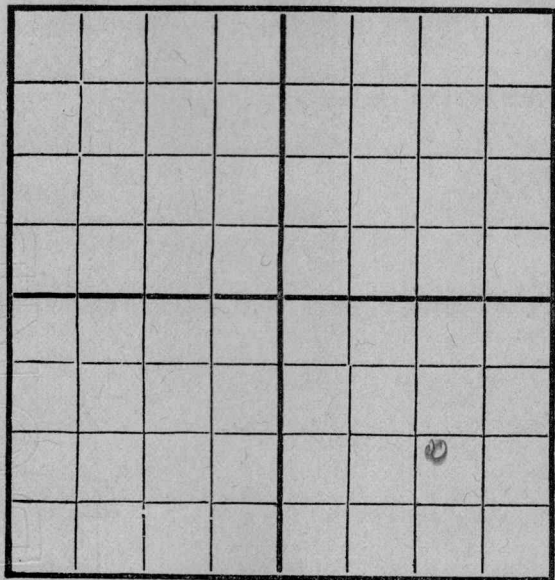

SOUTH

Location _____

Rig Up _____

Drilling and remarks

830

RECORD

Cased _____ in. _____ Ft.

Sand _____

Gas _____

Oil _____

Total Depth _____

PRODUCTION

1st 24 hrs. Nat. _____

First 24 h.s. after shot _____

Gas _____ Cu. Ft.

Dry Hole _____

Abandoned _____

Date


10/24, 1916 Scout

Map No. _____ Sec. 3 Twp. 28 R. 4
 Well No. 3 Beck Farm _____
Cassidy Company _____

NORTH

WEST

EAST

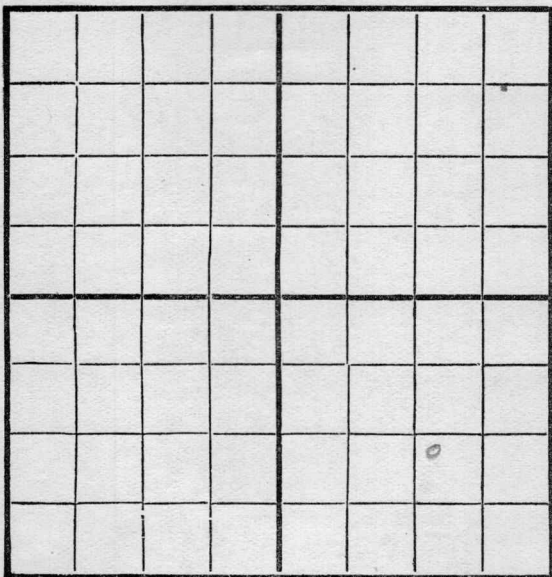

SOUTH

Location _____

Rig Up _____

Drilling and remarks

1000St. Reamy

RECORD

Cased _____ in. _____ Ft.

Sand _____

Gas _____

Oil _____

Total Depth _____

PRODUCTION

1st 24 hrs. Nat. _____

First 24 h.s. after shot _____

Gas _____ Cu. Ft.

Dry Hole _____

Abandoned _____


Date

10/301916St. Reamy

Scout

Map No. _____ Sec. 3 Twp. 28 R. 4
 Well No. 313000 Farm _____
Co. de Company _____

NORTH

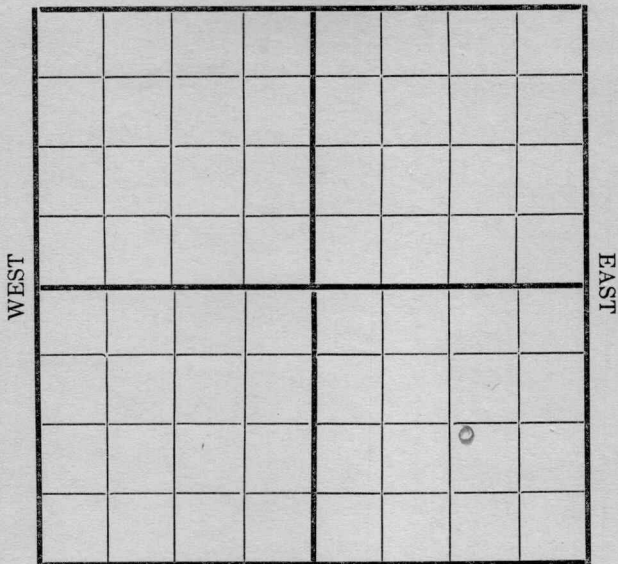

SOUTH

Location _____

Rig Up _____

Drilling and remarks

1250

RECORD

Cased _____ in. _____ Ft.

Sand _____

Gas _____

Oil _____

Total Depth _____

PRODUCTION

1st 24 hrs. Nat. _____

1st 24 hrs. after shot _____

Gas _____ Cu. Ft.

Dry Hole _____

Abandoned _____

Date

11/9

191

E. H. C. J.


Scout

Map No. _____ Sec. 3 Twp. 24 R. 4Well No. 21300 Farm _____

_____ Company

NORTH

WEST

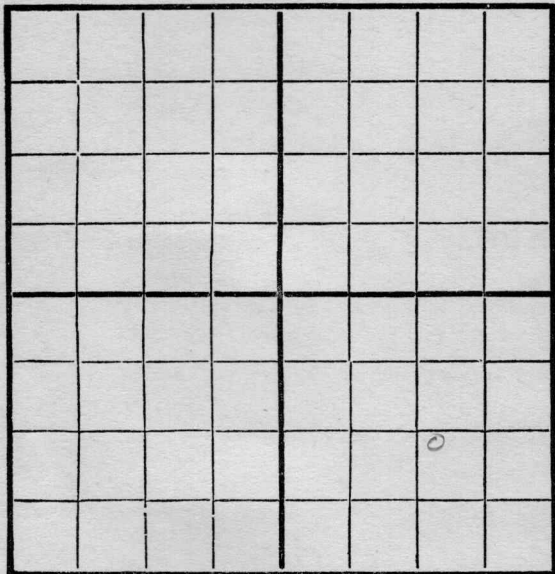

EAST

SOUTH

Location _____

Rig Up _____

Drilling and remarks

1485

RECORD

Cased _____ in. _____ Ft.

Sand _____

Gas _____

Oil _____

Total Depth _____

PRODUCTION

1st 24 hrs. Nat. _____

First 24 hrs. after shot _____

Gas _____ Cu. Ft.

Dry Hole _____

Abandoned _____

Date


11/14, 1916 Conley Scout

Map No. _____ Sec. 3 Twp. 28 R. 4
 Well No. 3 Beck Farm _____
Corden Company _____

NORTH

WEST

EAST

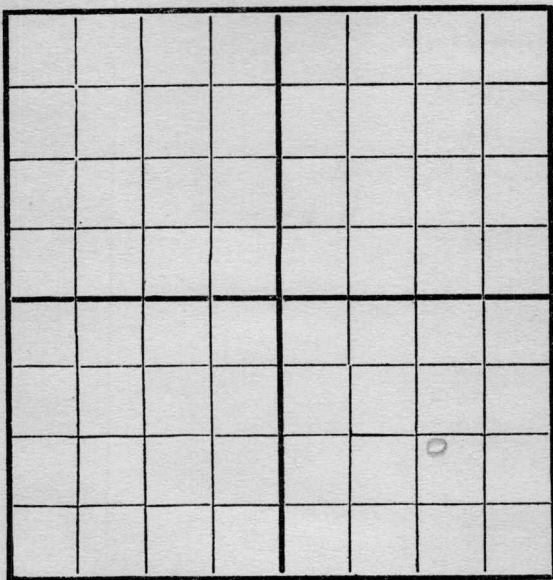

SOUTH

Location _____
 Rig Up _____
 Drilling and remarks _____

1500

RECORD

Cased _____ in. _____ Ft.
 Sand _____
 Gas _____
 Oil _____
 Total Depth _____

PRODUCTION

1st 24 hrs. Nat. _____
 1st 24 hrs. after shot _____
 Gas _____ Cu. Ft.
 Dry Hole _____
 Abandoned _____

Date


11/30, 1916 B. Corden Scout

Map No. _____ Sec. 3 Twp. 28 R 4
 Well No. 3 Beck Farm _____
Cosden Company _____

NORTH

WEST

EAST

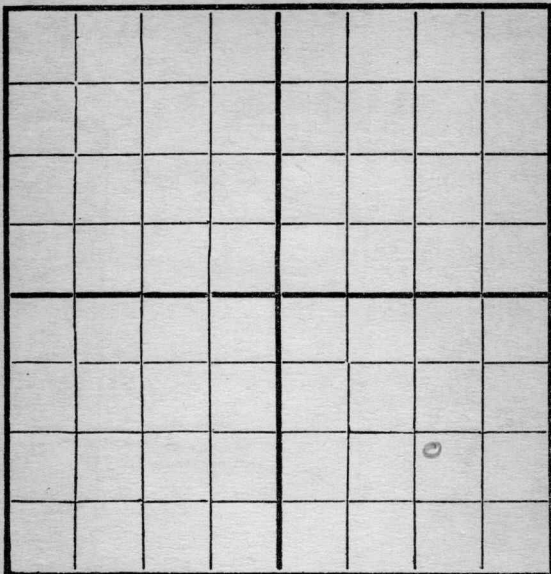

SOUTH

Location _____
 Rig Up _____
 Drilling and remarks

1945

RECORD

Cased _____ in. _____ Ft.
 Sand _____
 Gas _____
 Oil _____
 Total Depth _____

PRODUCTION

1st 24 hrs. Nat. _____
 1st 24 hrs. after shot _____
 Gas _____ Cu. Ft.
 Dry Hole _____
 Abandoned _____


Date

1/27, 1916 Cosden Scout

Map No. _____ Sec. 3 Twp. 28 R. 4
 Well No. 3 Beck Farm _____
Cosden Company _____

NORTH

WEST

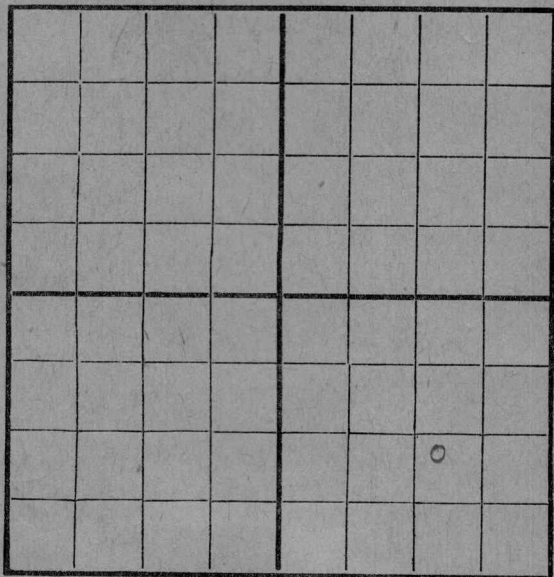

EAST

SOUTH

Location _____

Rig Up _____

Drilling and remarks

2415'

RECORD

Cased _____ in. _____ Ft.

Sand _____

Gas _____

Oil _____

Total Depth _____

PRODUCTION

1st 24 hrs. Nat. _____

1st 24 hrs. after shot _____

Gas _____ Cu. Ft.

Dry Hole _____


Abandoned _____

Date

12/4, 191 6 Cosden Scout

Map No. _____ Sec. 3 Twp. 28 R. 4
 Well No. 3 Beck Farm _____
Cosden Company _____

NORTH

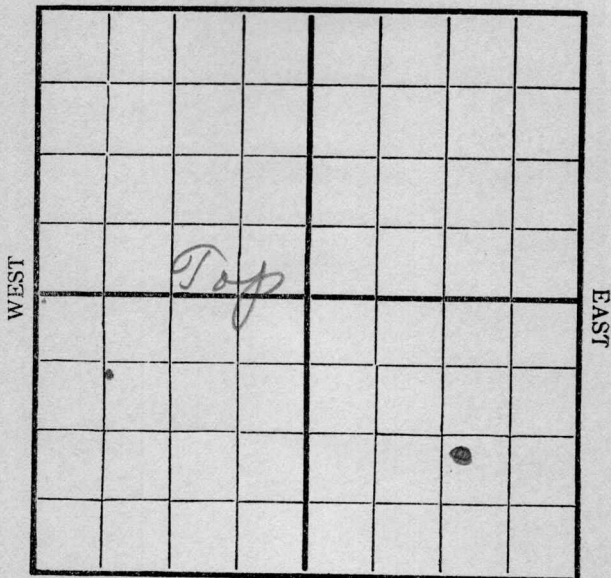

SOUTH

Location _____
 Rig Up _____
 Drilling and remarks _____

Top sand
2613'

25' in. Looks
good for 300 Bbls

RECORD

Cased _____ in. _____ Ft.
 Sand 2613-25'in.
 Gas _____
 Oil _____
 Total Depth _____

PRODUCTION

1st 24 hrs. Nat. _____
 1st 24 hrs. after shot _____
 Gas _____ Cu. Ft.
 Dry Hole _____
 Abandoned _____

Date

Still Drilling


12/14, 1916,

Cosden

Scout

Map No. _____ Sec. 3 Twp. 28 R. 4
 Well No. 3 Beck Farm _____
Cosden Company _____

NORTH

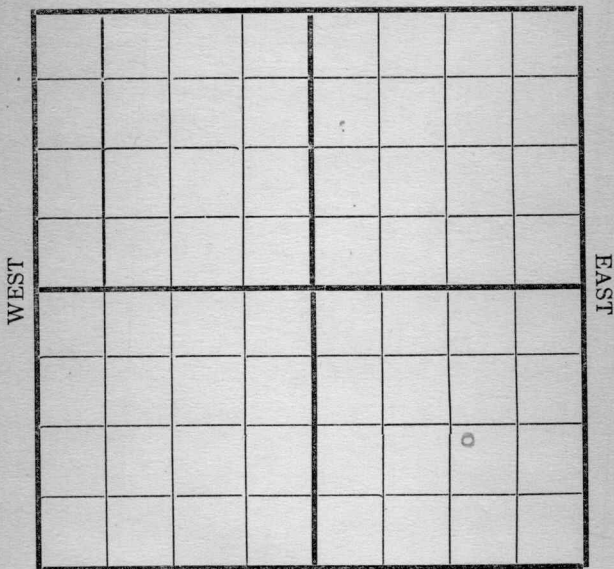

SOUTH

Location _____
 Rig Up _____
 Drilling and remarks _____

2625'

RECORD

Cased _____ in. _____ Ft.
 Sand _____
 Gas _____
 Oil _____
 Total Depth _____

PRODUCTION

1st 24 hrs. Nat. _____
 1st 24 hrs. after shot _____
 Gas _____ Cu. Ft.
 Dry Hole _____
 Abandoned _____


Date

12/18/86 Cosden Scout _____
 191 _____

Map No. _____ Sec. 3 Twp. 28 R. 4
 Well No. 3 Beck Farm _____
Condon Company _____

NORTH

WEST

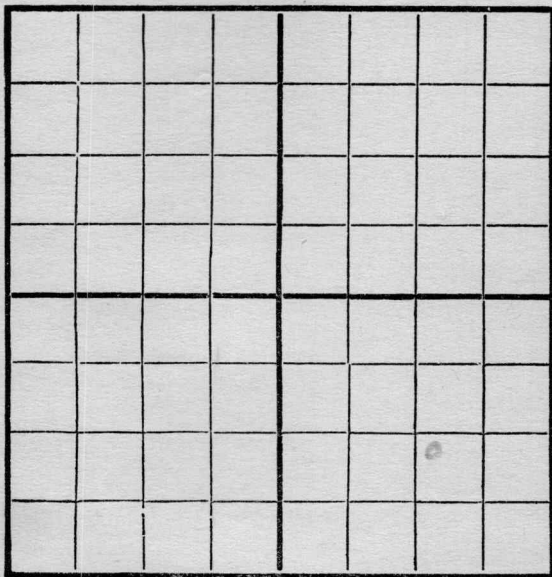

EAST

SOUTH

Location _____
 Rig Up _____
 Drilling and remarks _____

RECORD

Cased _____ in. _____ Ft.
 Sand 2575-2600
 Gas 2613-2625
 Oil _____
 Total Depth _____

PRODUCTION


1st 24 hrs. Nat. _____
 First 24 hrs. after shot _____
 Gas _____ Cu. Ft.
 Dry Hole _____
 Abandoned _____

Date trying to set line
12/28, 1916 _____ Scout _____

Map No. _____ Sec. 3 Twp. 28 R. 4
 Well No. 3 Beef Farm _____
Cooper Company _____

NORTH

WEST

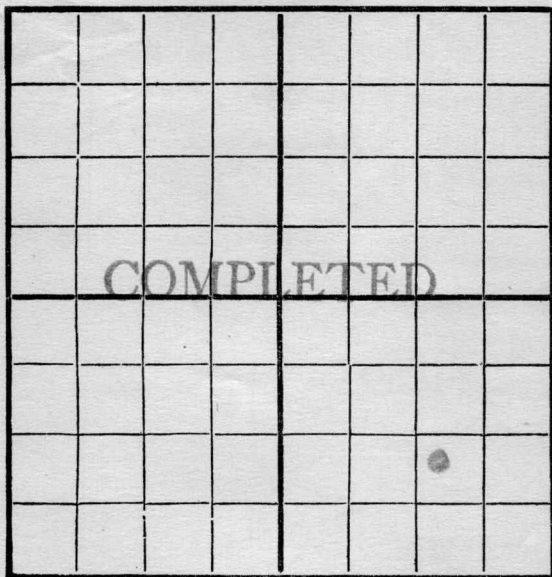

EAST

SOUTH

Location _____

Rig Up _____

Drilling and remarks

1st and 2575-2600Break thru shale2600-26132nd sand2613-2628Est at 500 Bbl

RECORD

Cased _____ in. _____ Ft.

Sand _____

Gas _____

Oil _____

Total Depth _____

PRODUCTION

1st 24 hrs. Nat. _____

First 24 hrs. after shot _____

Gas _____ Cu. Ft.

Dry Hole _____

Abandoned _____

Date

1/1

191

7Cooper

Scout