


Map No. _____ Sec. 3 Twp. 28 R. 4
 Well No. 5 Beck Farm _____
Corden Company _____

NORTH

WEST

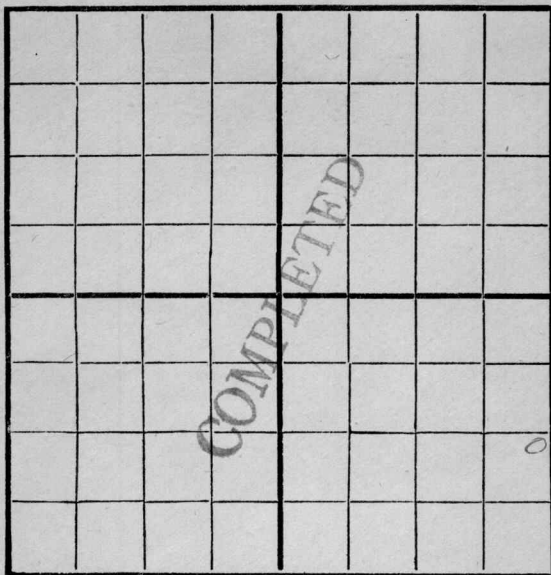

EAST

SOUTH

Location _____

Rig Up _____

Drilling Remarks:

Drilling Remarks:

R. 91 = 12/4 = 12/11 = 12/18 = 12/28 =
spudding = 1/8/17
540 = 1/18 =

RECORD

Cased _____ in _____ Ft.
 Sand _____
 Gas _____
 Oil _____
 Total Depth _____

PRODUCTION


1st 24 hrs. Nat. _____
 1st 24 hrs. after shot _____
 Gas _____ Cu. Ft.
 Dry Hole _____
 Abandoned _____

Map No. _____ Sec. 3 Twp. 28 R. 4

Well No. 5 Beck Farm _____

Quaden Company _____

NORTH

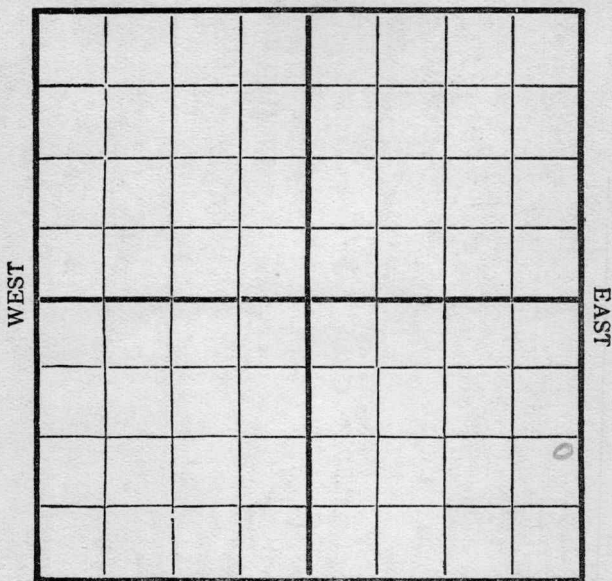

SOUTH

Location _____

Rig Up ☒ _____

Drilling and remarks _____

RECORD

Cased _____ in. _____ Ft.

Sand _____

Gas _____

Oil _____

Total Depth _____

PRODUCTION

1st 24 hrs. Nat. _____

First 24 h.s. after shot _____

Gas _____ Cu. Ft.

Dry Hole _____

Abandoned _____

Date


10/30, 1916 Beck Scout

Map No. _____ Sec. 3 Twp. 28 R. 4
 Well No. 57300K Farm _____
Quadrant Company _____

NORTH

WEST

EAST

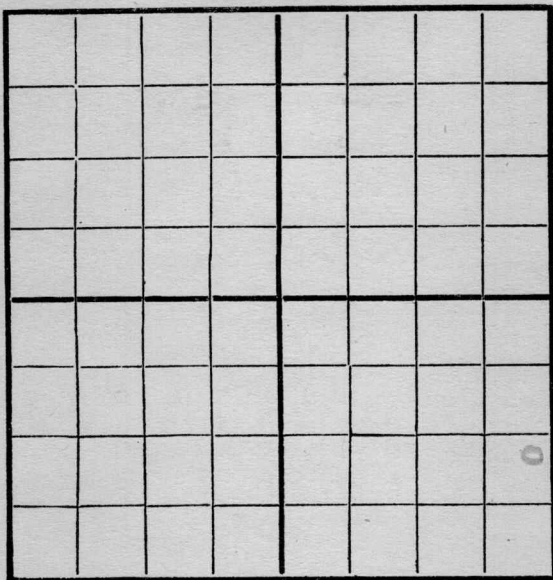

SOUTH

Location ✓
 Rig Up ✓
 Drilling and remarks _____

RECORD

Cased _____ in. _____ Ft.
 Sand _____
 Gas _____
 Oil _____
 Total Depth _____

PRODUCTION


1st 24 hrs. Nat. _____
 1st 24 hrs. after shot _____
 Gas _____ Cu. Ft.
 Dry Hole _____
 Abandoned _____

Date

11/20, 1916 Quadrant Scout

Map No. _____ Sec. 3 Twp. 28 R. 4
 Well No. 5 Beck Farm _____
Cosden Company _____

NORTH

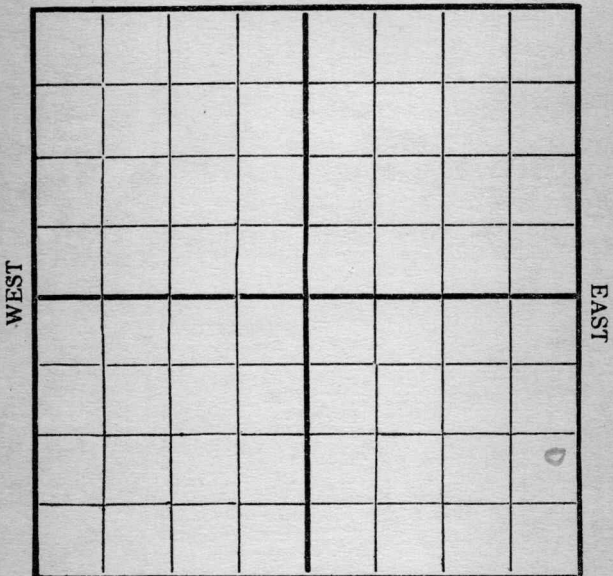

SOUTH

Location _____ Rig Up <u>✓</u> _____ Drilling and remarks _____	RECORD	
	Cased _____ in. _____	Ft. _____
	Sand _____	
	Gas _____	
	Oil _____	
	Total Depth _____	
	PRODUCTION	
	1st 24 hrs. Nat. _____	
	1st 24 hrs. after shot _____	
	Gas _____	Cu. Ft. _____
	Dry Hole _____	
	Abandoned _____	


Date 11/27, 1916 Cosden Scout

Map No. _____ Sec. 3 Twp. 28 R. 4Well No. 5 Beck _____ Farm _____

_____ Company _____

NORTH

WEST

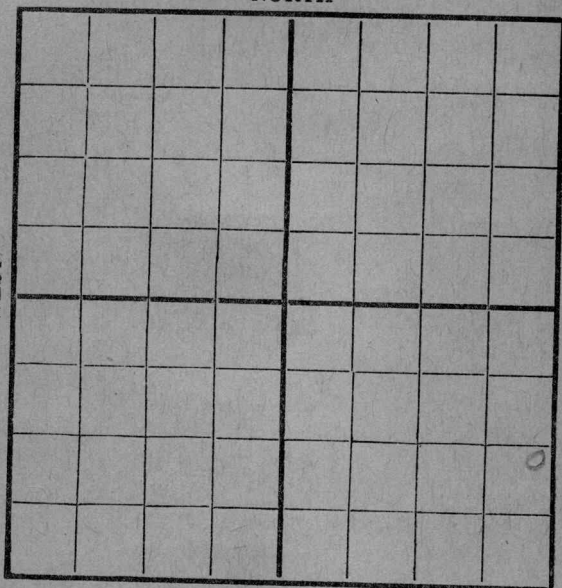

EAST

SOUTH

Location _____

Rig Up ☒ _____

Drilling and remarks _____

RECORD

Cased _____ in. _____ Ft.

Sand _____

Gas _____

Oil _____

Total Depth _____

PRODUCTION

1st 24 hrs. Nat. _____

1st 24 hrs. after shot _____

Gas _____ Cu. Ft.

Dry Hole _____

Abandoned _____


Date

12/4, 1916 Quincy Scout

Map No. _____ Sec. 3 Twp. 28 R. 4Well No. 5 Beech Farm _____
Condon Company _____

NORTH

WEST

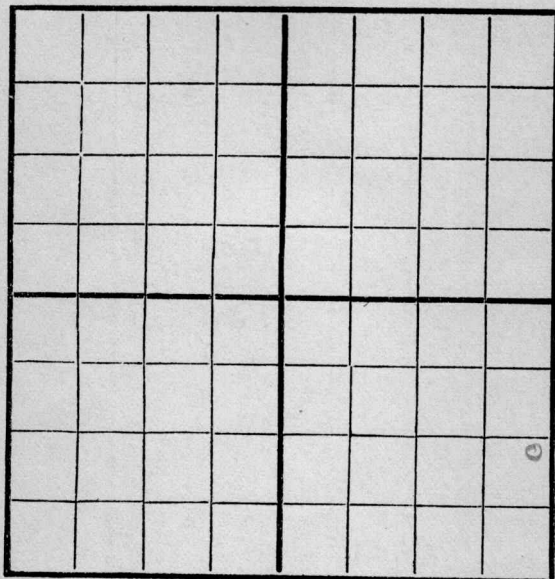

EAST

SOUTH

Location ☒Rig Up ☒

Drilling and remarks

RECORD

Cased _____ in. _____ Ft.

Sand _____

Gas _____

Oil _____

Total Depth _____

PRODUCTION

1st 24 hrs. Nat. _____

1st 24 hrs. after shot _____

Gas _____ Cu. Ft.

Dry Hole _____


Abandoned _____

Date

12/4, 191 6 Condon Scout

Map No. _____ Sec. 3 Twp. 28 R. 4
 Well No. 5 Beck Farm _____
Cooden Company _____

NORTH

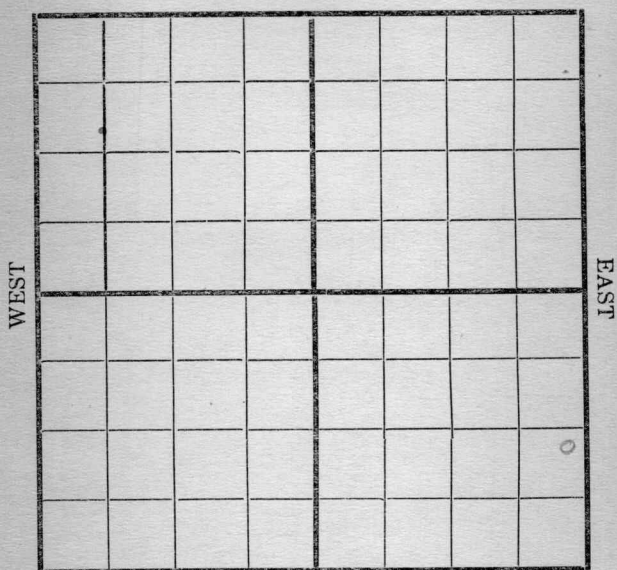

SOUTH

Location _____ Rig Up ☒ _____ Drilling and remarks _____	RECORD
	Cased _____ in. _____ Ft.
	Sand _____
	Gas _____
	Oil _____
	Total Depth _____
	PRODUCTION
	1st 24 hrs. Nat. _____
	1st 24 hrs. after shot _____
	Gas _____ Cu. Ft.
	Dry Hole _____
	Abandoned _____

Date 12/18, 1916 Cooden Scout


Map No. _____ Sec. 3 Twp. 28 R. 4

Well No. 5136 Farm _____

Cosden Company _____

NORTH

WEST

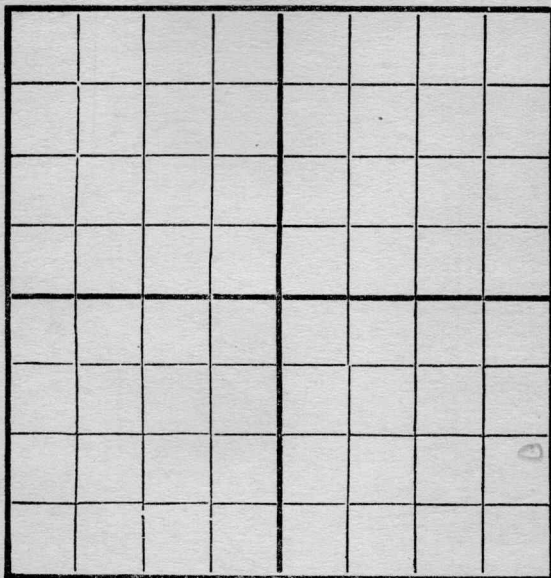

EAST

SOUTH

Location _____

Rig Up ☒ _____

Drilling and remarks _____

RECORD

Cased _____ in. _____ Ft.

Sand _____

Gas _____

Oil _____

Total Depth _____

PRODUCTION

1st 24 hrs. Nat. _____

First 24 hrs. after shot _____

Gas _____ Cu. Ft.

Dry Hole _____

Abandoned _____

Date _____


191

Scout

Map No. _____ Sec. 3 Twp. 38 R. 4
 Well No. 5 Beck Farm _____
Cusden Company _____

NORTH

WEST

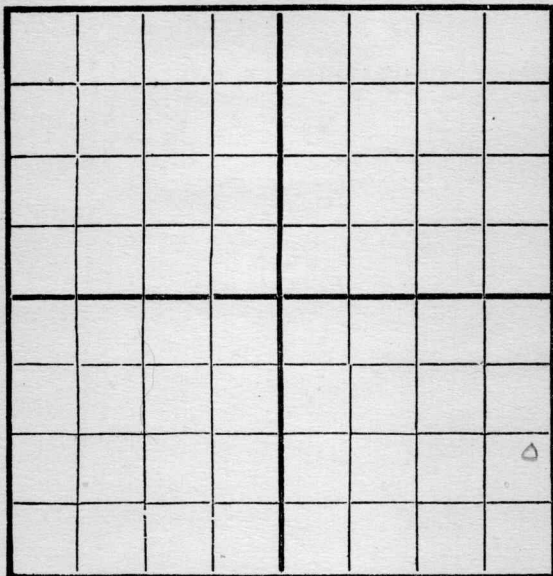

EAST

SOUTH

Location _____

Rig Up _____

Drilling and remarks _____

RECORD

Cased _____ in. _____ Ft.

Sand _____

Gas _____

Oil _____

Total Depth _____

PRODUCTION

1st 24 hrs. Nat. _____

First 24 hrs. after shot _____

Gas _____ Cu. Ft.

Dry Hole _____

Abandoned _____

Date


1/1, 1912 Coulip Scout

Map No. _____ Sec. 3 Twp. 28 R. 4Well No. 51326 Farm _____

_____ Company _____

NORTH

WEST

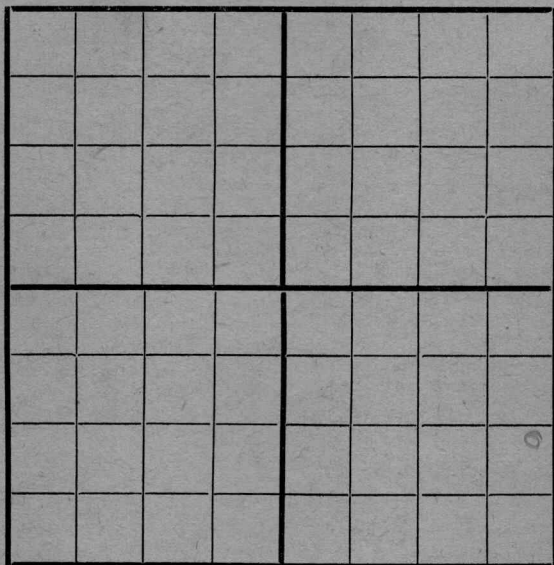

EAST

SOUTH

Location _____

Rig Up _____

Drilling and remarks

RECORD

Cased _____ in. _____ Ft.

Sand _____

Gas _____

Oil _____

Total Depth _____

PRODUCTION

1st 24 hrs. Nat. _____

1st 24 hrs. after shot _____

Gas _____ Cu. Ft.

Dry Hole _____

Abandoned _____

Date

1/18, 1917 Condeff Scout

Map No. _____ Sec. 3 Twp. 38 R. 4
 Well No. 5 Bear Farm _____
Cosden Company _____

NORTH

WEST

EAST

SOUTH

Location _____
 Rig Up _____
 Drilling and remarks _____

Shut Down
990
No water to
drill with

RECORD

Cased _____ in. _____ Ft.
 Sand _____
 Gas _____
 Oil _____
 Total Depth _____

PRODUCTION

1st 24 hrs. Nat. _____
 1st 24 hrs. after shot _____
 Gas _____ Cu. Ft.
 Dry Hole _____
 Abandoned _____

Date


1/26, 1917 Cosden Scout

Map No. _____ Sec. 3 Twp. 28 R. 4
 Well No. 513012 Farm _____
Cosden Company _____

NORTH

WEST

EAST

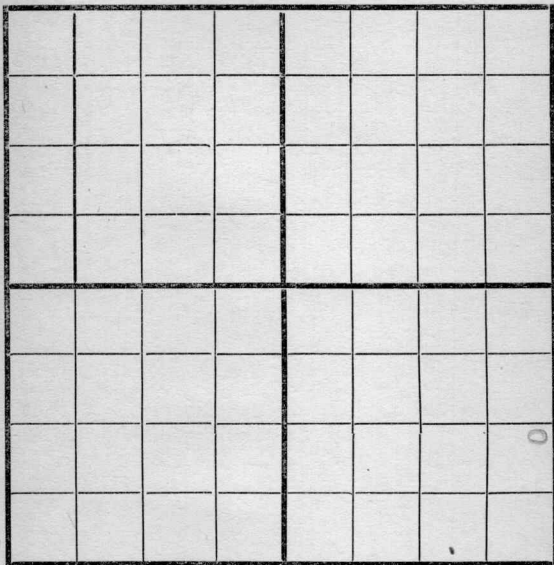

SOUTH

Location _____
 Rig Up _____
 Drilling and remarks _____

1125'

RECORD

Cased _____ in. _____ Ft.
 Sand _____
 Gas _____
 Oil _____
 Total Depth _____

PRODUCTION

1st 24 hrs. Nat. _____
 1st 24 hrs. after shot _____
 Gas _____ Cu. Ft.
 Dry Hole _____
 Abandoned _____

Date


1/29, 1917 Cosden Scout

Map No. _____ Sec. 3 Twp. 28 R. 4
 Well No. 51300 Farm _____
Cosden Company

NORTH

WEST

EAST

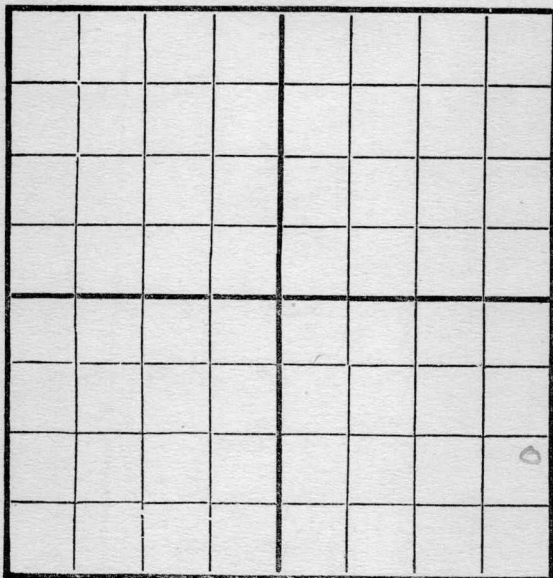

SOUTH

Location _____
 Rig Up _____
 Drilling and remarks _____

Shut Down
1315'

RECORD

Cased _____ in. _____ Ft.
 Sand _____
 Gas _____
 Oil _____
 Total Depth _____

PRODUCTION


1st 24 hrs. Nat. _____
 First 24 hrs. after shot _____
 Gas _____ Cu. Ft.
 Dry Hole _____
 Abandoned _____

Date

2/8 191 2 Cosden Scout

Map No. _____ Sec. 3 Twp. 28 R. 4
 Well No. 51322 Farm _____
Cordell Company _____

NORTH

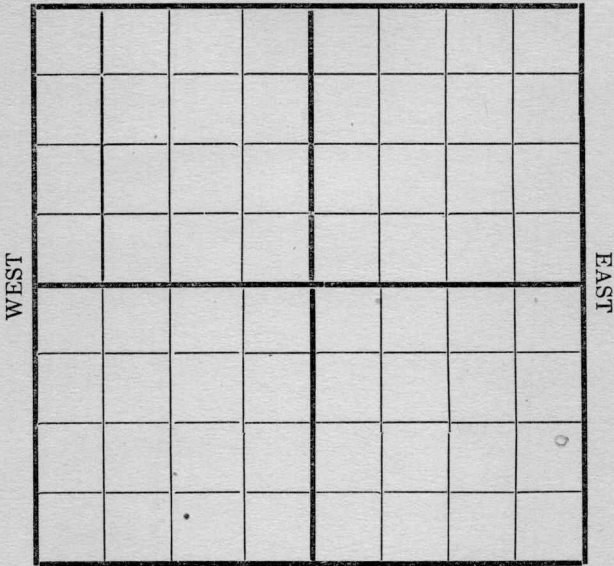

SOUTH

Location _____
 Rig Up _____
 Drilling and remarks _____

RECORD

Cased _____ in. _____ Ft.
 Sand _____
 Gas _____
 Oil _____
 Total Depth _____

PRODUCTION

1st 24 hrs. Nat. _____
 1st 24 hrs. after shot _____
 Gas _____ Cu. Ft.
 Dry Hole _____
 Abandoned _____

Date 2/15, 1917 Cordell Scout

Map No. _____ Sec. 3 Twp. 28 R. 4
Well No. 51364 Farm _____
Casden Company _____

NORTH

[illegible]

SOUTH

Location _____

Rig Up-----

Drilling and remarks

Fishing
1600'

RECORD

Cased _____ in. _____ Ft.

Sand_____

Gas _____

Oil _____

Total Depth_____

PRODUCTION

1st 24 hrs. Nat.

1st 24 hrs. after shot-----

Gas_____Cu. Ft.

Dry Hole _____

Abandoned.....


Date _____

Date 3/2, 1917. Carney Scout

Scout

Map No. _____ Sec. 3 Twp. 28 R. 4Well No. 5 Beck _____ Farm_____ Cooper Company

NORTH

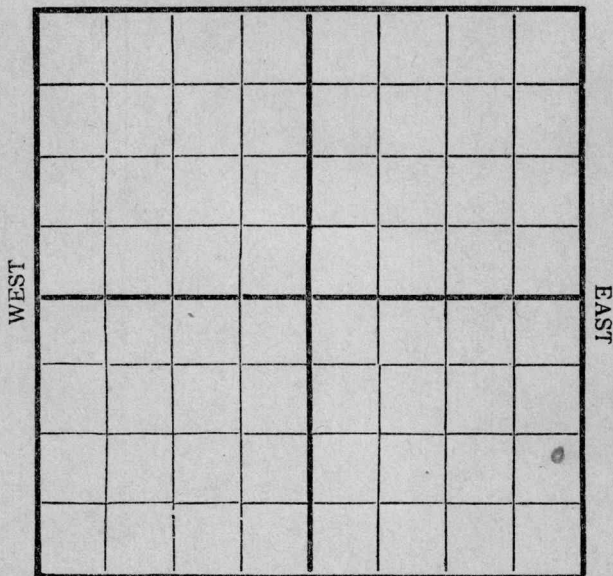

SOUTH

REMARKS:


Find 1810/1648'

Date

3/7, 1917 Cooper Scout

Map No. _____ Sec. 3 Twp. 28 R. 4
Well No. 5 Beck Farm _____
Condon Company _____

NORTH

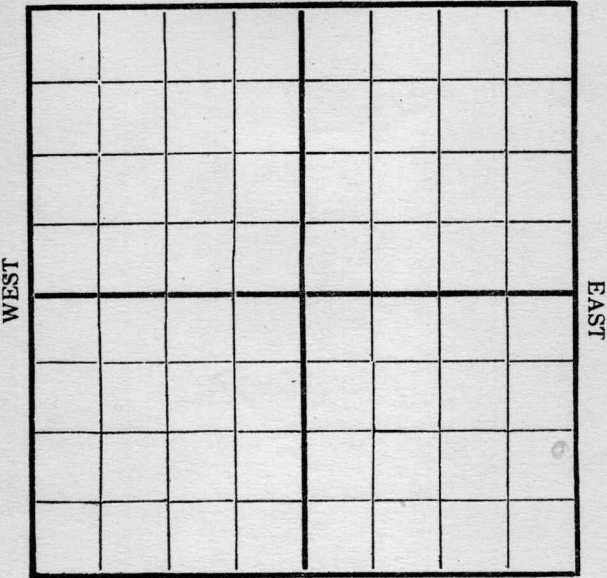

SOUTH

Location _____ Rig Up _____ Drilling and remarks <u>2120'</u>	RECORD
	Cased _____ in. _____ Ft.
	Sand _____
	Gas _____
	Oil _____
	Total Depth _____
	PRODUCTION
	1st 24 hrs, Nat. _____
	1st 24 hrs. after shot _____
	Gas _____ Cu. Ft.
	Dry Hole _____
	Abandoned _____

Date 3/15, 1917 Condon Scout

Map No. _____ Sec. 3 Twp. 28 R. 4
 Well No. 50322 Farm _____
Condor Company

NORTH

WEST

EAST

SOUTH

Location _____
 Rig Up _____
 Drilling and remarks

Fishing
2355

RECORD

Cased _____ in. _____ Ft.
 Sand _____
 Gas _____
 Oil _____
 Total Depth _____

PRODUCTION

1st 24 hrs. Nat. _____
 1st 24 hrs. after shot _____
 Gas _____ Cu. Ft.
 Dry Hole _____
 Abandoned _____

Date


3/22, 191 *7* *Condor* Scout

Map No. _____ Sec. 3 Twp. 28 R. 4Well No. 5 Black Farm _____
Caden Company _____

NORTH

WEST

EAST

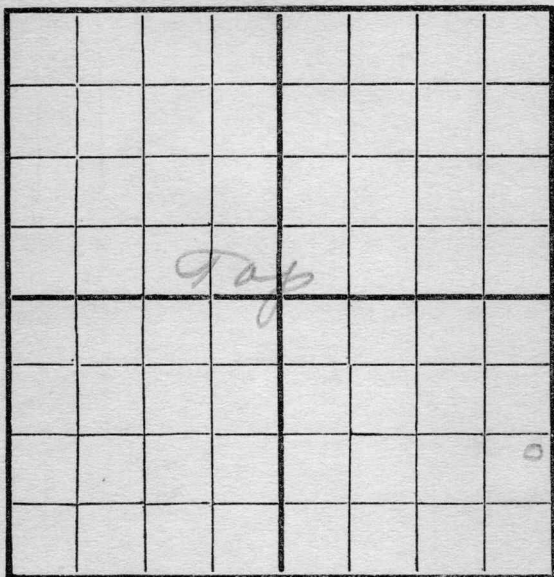

SOUTH

Location _____

Rig Up _____

Drilling and remarks

Tap sound
2581' Steele
line measure
vents

RECORD

Cased _____ in. _____ Ft.

Sand _____

Gas _____

Oil _____

Total Depth _____

PRODUCTION

1st 24 hrs. Nat. _____

1st 24 hrs. after shot _____

Gas _____ Cu. Ft.

Dry Hole _____

Abandoned _____


Date

3/28, 191 *7* *Caden* Scout

Map No. _____ Sec. 3 Twp. 28 R. 4
 Well No. 51300K Farm _____
Cooden Company _____

NORTH

WEST

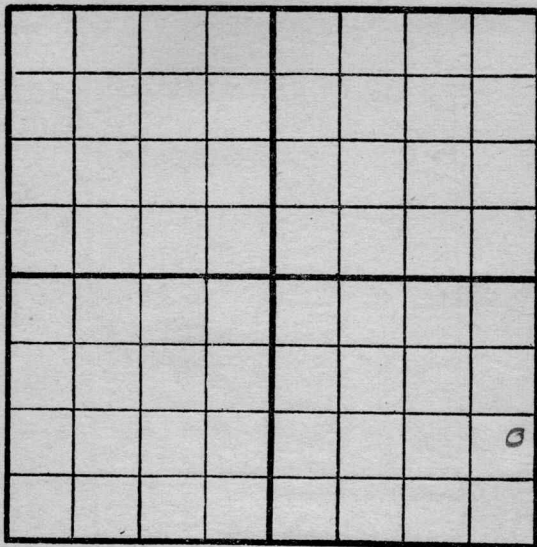

EAST

SOUTH

Location _____

Rig Up _____

Drilling and remarks

*cased and
ready to
fill in*

RECORD

Cased _____ in. _____ Ft.

Sand _____

Gas _____

Oil _____

Total Depth _____

PRODUCTION

1st 24 hrs. Nat. _____

1st 24 hrs. after shot _____

Gas _____ Cu. Ft.

Dry Hole _____

Abandoned _____

Date

3/31, 191 *7*


Carley Scout

Map No. _____ Sec. 3 Twp. 38 R. 4
 Well No. 5 Beck Farm _____
Cooper Company _____

NORTH

WEST

EAST

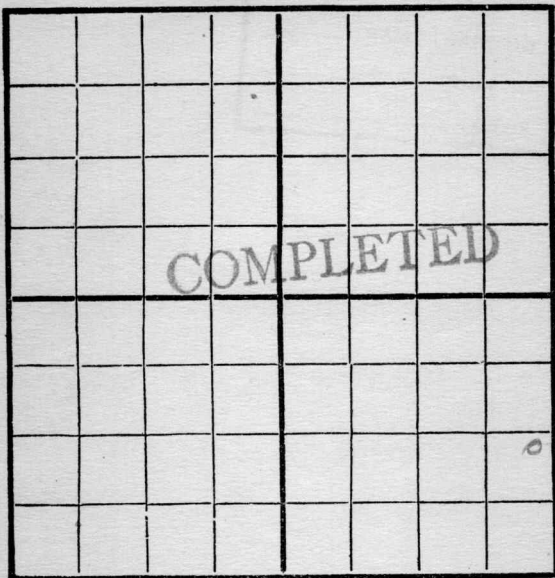

SOUTH

Location _____
 Rig Up _____
 Drilling and remarks _____

*Probably
 good for
 150 Bbls*

RECORD

Cased _____ in. _____ Ft.
 Sand 2586-2598
 Gas _____
 Oil _____
 Total Depth _____

PRODUCTION

1st 24 hrs. Nat. _____
 First 24 hrs. after shot _____
 Gas _____ Cu. Ft.
 Dry Hole _____
 Abandoned _____

Date

4/5, 191 7 Cooper Scout