


Map No. _____ Sec. 3 Twp. 28 R. 4
 Well No. 3 Riddell Farm _____
Empire Company

NORTH

WEST

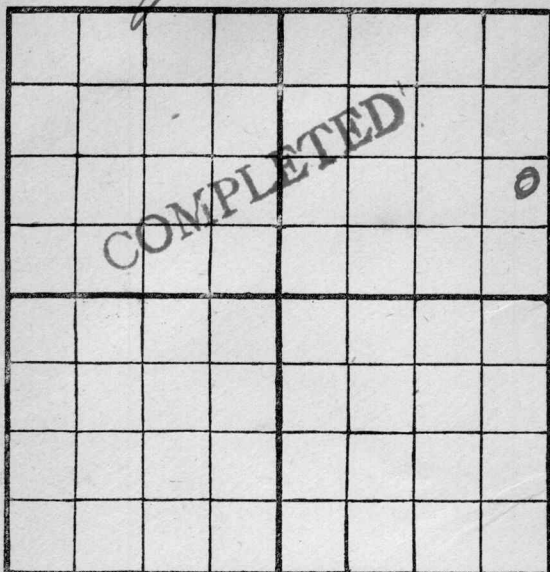

EAST

SOUTH

Location _____

Rig Up _____

Drilling Remarks:

Drilling Remarks:

RECORD

PRODUCTION

Cased _____ in. _____ ft.

1st 24 hrs. Nat. _____

Sand _____

1st 24 hrs. after shot _____

Gas _____

Gas _____ cu. ft

Oil _____

Dry Hole _____

Total Depth _____

Abandoned _____

Map No. 102 K11 Sec. 3 Twp. 28 R. 4


Well No. 3 Tiddle Farm

Empire Company

NORTH

WEST

EAST

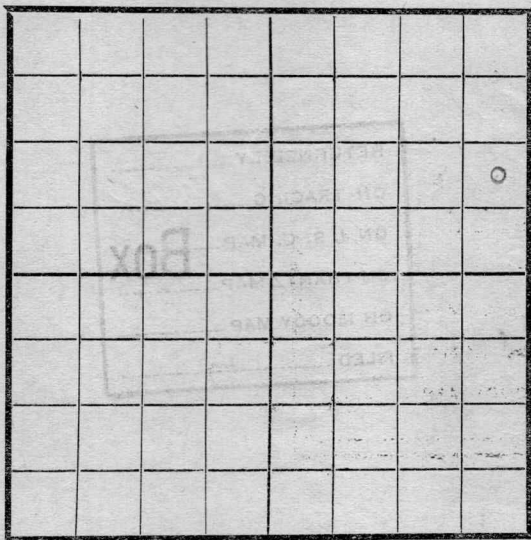

SOUTH

Location ✓

Rig Up ✓

Drilling and remarks

RECORD

Cased _____ in. _____ Ft.

Sand _____

Gas _____

Oil _____

Total Depth _____

FIRST REPORT

PRODUCTION

1st 24 hrs. Nat. _____

1st 24 hrs. after shot _____

Gas _____ Cu. Ft.

Dry Hole _____

Abandoned _____


Date

4/15, 1918. Condy Scout

Map No. _____ Sec. 3 Twp. 28 R. 4Well No. 3 of Biddle Farm _____Company Empire

NORTH

WEST

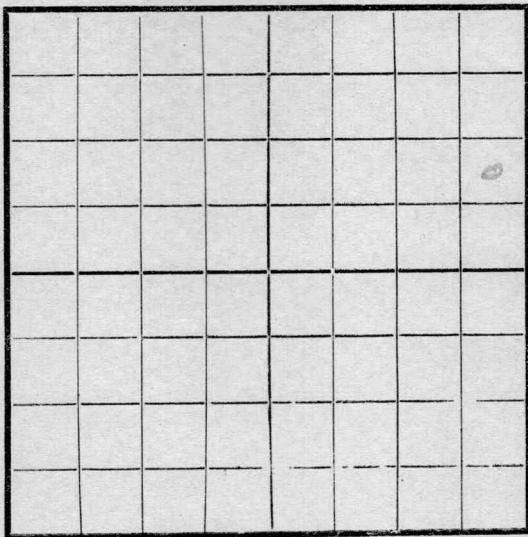

EAST

SOUTH

Location _____

Rig Up _____

Drilling and remarks

*Rigging up**V. M. Rine
Drilling Co
August 1914*

RECORD

Cased _____ in _____ Ft.

Sand _____

Gas _____

Oil _____

Total Depth _____

PRODUCTION

1st 24 hrs. Nat. _____

1st 24 hrs. after shot _____

Gas _____ Cu. Ft.

Dry Hole _____

Abandoned _____


Date

5/8, 1914 *Empire* Scout

Map No. _____ Sec. 3 Twp 38 R. 4
 Well No. 3 Reddell Farm _____
Empire Company _____

NORTH

WEST

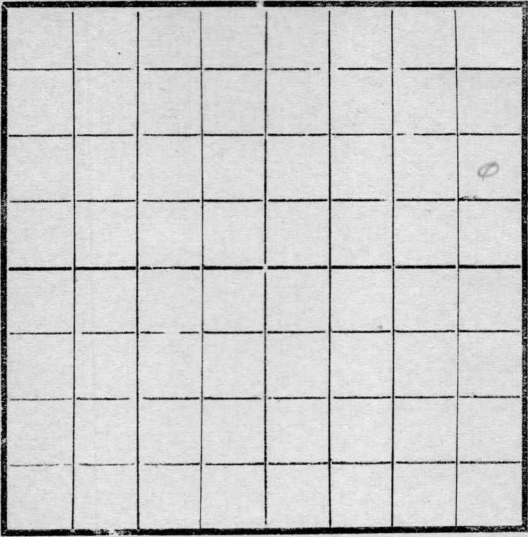

EAST

SOUTH

Location _____
 Rig Up _____
 Drilling and remarks _____

Drilling

Perkins Drill Co.
August 7, 1915

RECORD

Cased _____ in. _____ Ft.
 Sand _____
 Gas _____
 Oil _____
 Total Depth _____

PRODUCTION

1st 24 hrs. Nat. _____
 1st 24 hrs. after shot _____
 Gas _____ Cu. Ft.
 Dry Hole _____
 Abandoned _____


Date

5/15, 1915 *S. C. Cady* Scout

Map No. _____ Sec. 3 Twp. 28 R. 4
 Well No. 3 Riddle Farm _____
Empire Company

NORTH

WEST

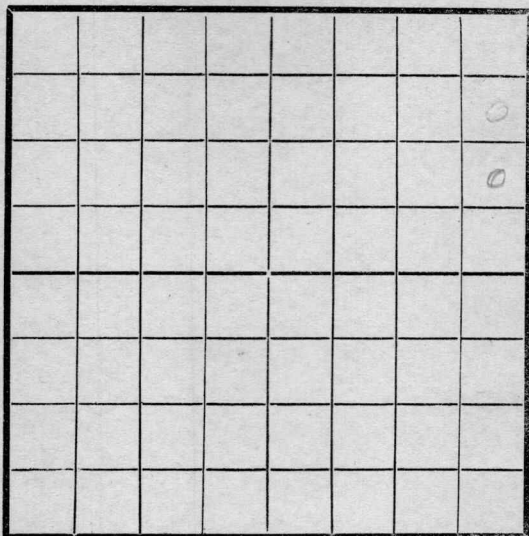

EAST

SOUTH

Location _____
 Rig Up _____
 Drilling and remarks

110

RECORD

Cased _____ in. _____ Ft.
 Sand _____
 Gas _____
 Oil _____
 Total Depth _____

PRODUCTION

1st 24 hrs. Nat. _____
 1st 24 hrs. after shot _____
 Gas _____ Cu. Ft.
 Dry Hole _____
 Abandoned _____

Date

5/22, 1918 Riddle Scout


Map No. _____ Sec. 3 Twp. 28 R. 4

Well No. 3 Riddle Farm

_____ Company

NORTH

WEST

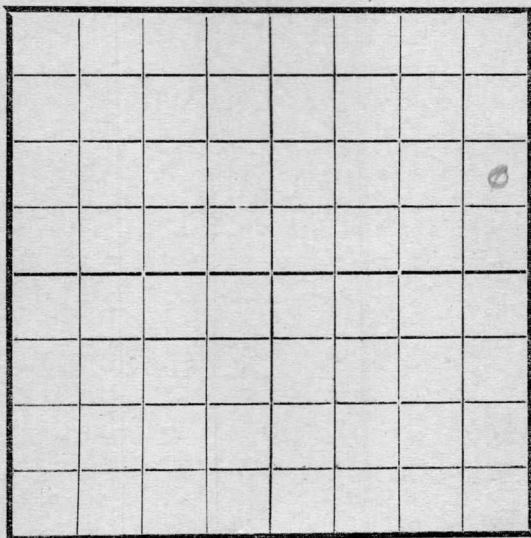

EAST

SOUTH

Location _____

Rig Up _____

Drilling and remarks

960

RECORD

Cased _____ in. _____ Ft

Sand _____

Gas _____

Oil _____

Total Depth _____

PRODUCTION

1st 24 hrs. Nat. _____

1st 24 hrs. after shot _____

Gas _____ Cu. Ft.

Dry Hole _____

Abandoned _____

Date


5/29, 1918 A. R. Riddle Scout

Map No. _____ Sec. 3 Twp. 38 R. 4

Well No. 3 Riddle Farm _____
Cummins Company

NORTH

WEST

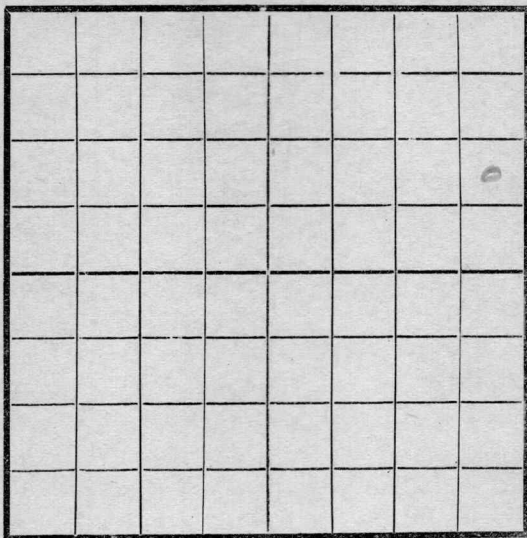

EAST

SOUTH

Location _____

Rig Up _____

Drilling and remarks

1370

RECORD

Cased _____ in. _____ Ft.

Sand _____

Gas _____

Oil _____

Total Depth _____

PRODUCTION

1st 24 hrs. Nat. _____

1st 24 hrs. after shot _____

Gas _____ Cu. Ft.

Dry Hole _____

Abandoned _____

Date

6/5, 191 8 Canby Scout

Map No. _____ Sec. 3 Twp. 38 R. 4Well No. 3 RiddleEngine Company _____

Contractor _____

NORTH

WEST

EAST

SOUTH

Location _____

Rig up _____

Drilling and Remarks:

2100

RECORD

Cased _____ in., _____ ft.

Sand _____

Gas _____

Oil _____

Total Depth _____

PRODUCTION

1st 24 hrs. Nat. _____

1st 24 hrs. after shot _____

Gas _____ Cu. Ft.

Dry Hole _____


Abandoned _____

Date

6/12/28 191 C. Conley Scout

Map No. _____ Sec. 3 Twp. 28 R. 4
 Well No. 3 Riddle
Engine _____ Company _____
 Contractor _____

NORTH

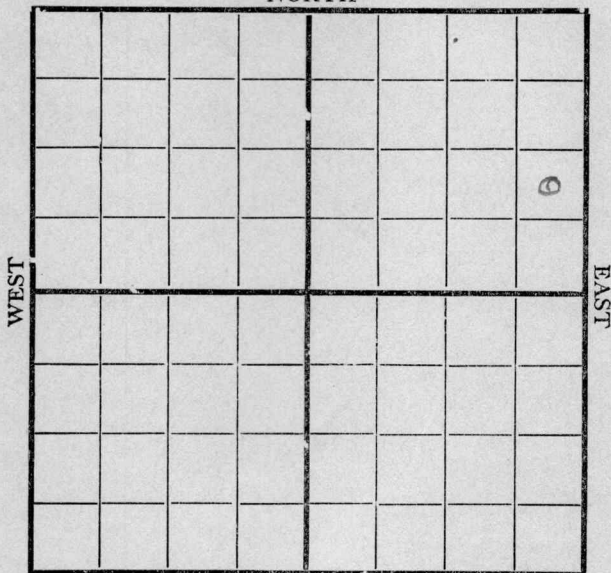

WEST

EAST

SOUTH

Location _____

Rig up _____

Drilling and Remarks:

2380

RECORD

Cased _____ in., _____ ft.

Sand _____

Gas _____

Oil _____

Total Depth _____

PRODUCTION

1st 24 hrs. Nat. _____

1st 24 hrs. after shot _____

Gas _____ Cu. Ft.

Dry Hole _____

Abandoned _____

Date

6/211918Conley

Scout

1002 KH Map No. Sec. 3 Twp. 28 R. 4


Well No. 3 Riddle

Empire Company

R. H. Rine Drilling Co. Contractor

Augusta NORTH

WEST

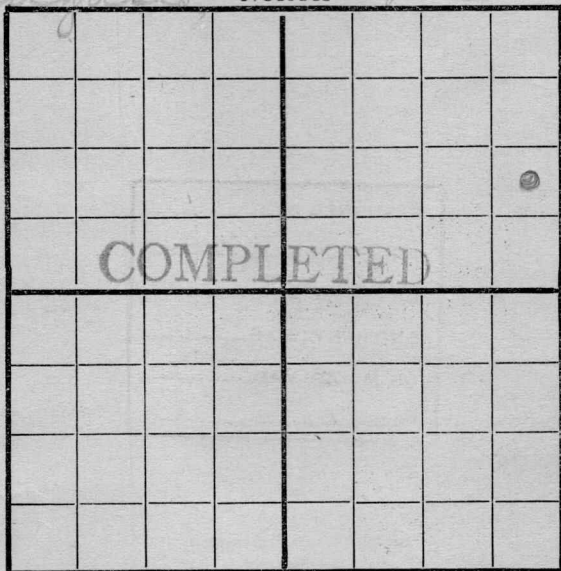

EAST

SOUTH

Location

Rig up

Drilling and Remarks:

Est at
50 Bbls

RECORD

Cased in., ft.

Sand 2577-2586

Gas

Oil

Total Depth

PRODUCTION

1st 24 hrs. Nat.

1st 24 hrs. after shot

Gas Cu. Ft.

Dry Hole

Abandoned

Date

6/26 1918 C. C. Condit Scout