


Map No. _____ Sec. 3 Twp. 28 R. 4Well No. 1 Riddle Farm __________Empire_____
Company

NORTH

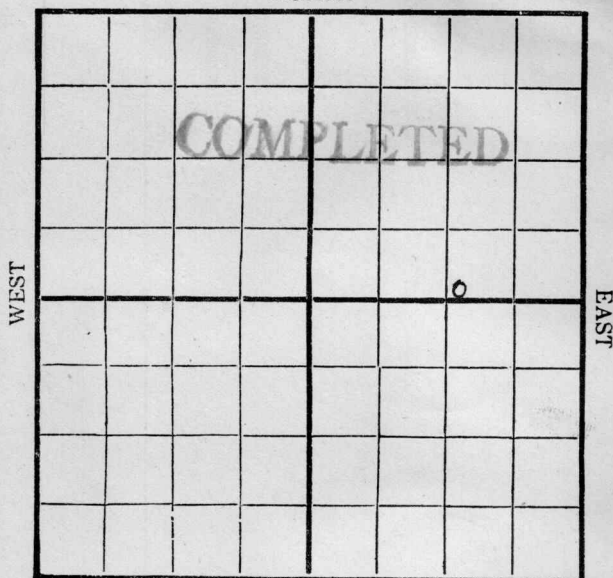

SOUTH

Location _____

Rig Up 12/11/16

Drilling Remarks:

Drilling Remarks:

Rel: 12/18: 12/28
30' = 1/8/17
180' = 1/15

RECORD

PRODUCTION

Cased _____ in _____ Ft.

1st 24 hrs. Nat. _____

S and _____

1st 24 hrs. after shot _____

Gas _____

Gas _____ Cu. Ft.

Oil _____

Dry Hole _____


Total Depth _____

Abandoned _____

Map No. _____ Sec. 3 Twp. 28 R. 4Well No. 1 Riddle Farm _____Engine Company _____

NORTH

WEST

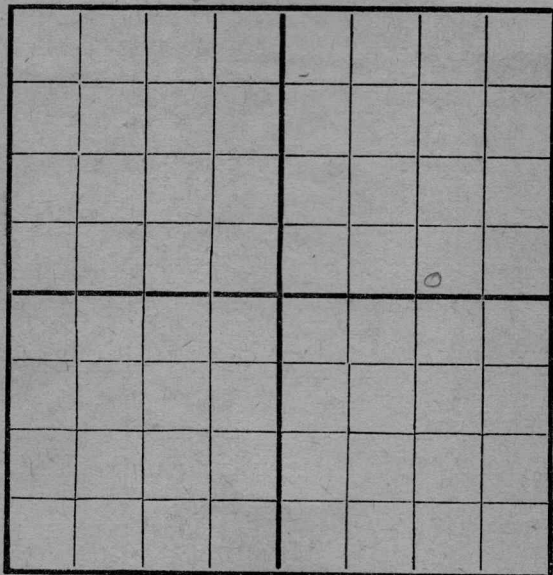

EAST

SOUTH

RECORD

Location _____

Cased _____ in. _____ Ft.

Rig Up _____

Sand _____

Drilling and remarks _____

Gas _____

Oil _____

Total Depth _____

PRODUCTION

1st 24 hrs. Nat. _____

1st 24 hrs. after shot _____

Gas _____ Cu. Ft.

Dry Hole _____

Abandoned _____

Date

12/11, 1916 Condy Scout


Map No. _____ Sec. 3 Twp. 28 R. 4

Well No. 1 Riddle Farm _____

Empire Company _____

NORTH

WEST

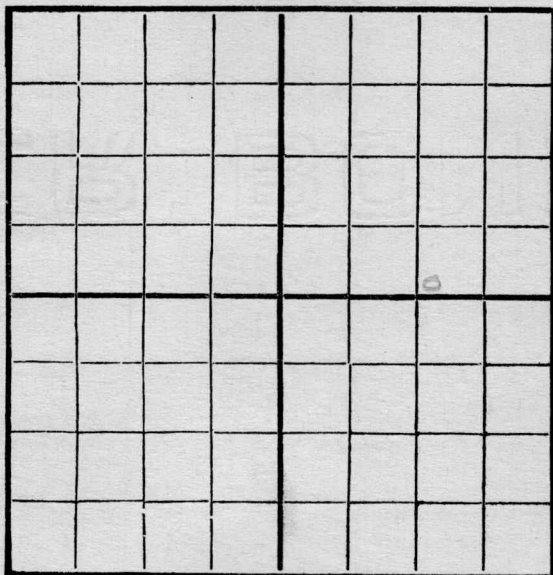

EAST

SOUTH

RECORD

Location _____

Cased _____ in. _____ Ft.

Rig Up ☒ _____

Sand _____

Drilling and remarks _____

Gas _____

Oil _____

Total Depth _____

PRODUCTION

1st 24 hrs. Nat. _____

1st 24 hrs. after shot _____

Gas _____ Cu. Ft.

Dry Hole _____

Abandoned _____

Date _____

12/8, 1916 Couch Scout

Map No. _____ Sec. 3 Twp. 28 R. 4
 Well No. 1 _____ Farm _____
Pringle Company

NORTH

WEST

EAST

SOUTH

Location _____

Rig Up _____

Drilling and remarks

Rigging up

RECORD

Cased _____ in. _____ Ft.

Sand _____

Gas _____

Oil _____

Total Depth _____

PRODUCTION

1st 24 hrs. Nat. _____

First 24 hrs. after shot _____

Gas _____ Cu. Ft.

Dry Hole _____

Abandoned _____


Date

12/28, 1916 C. J. C. Scout

Map No. _____ Sec. 3 Twp. 28 R. 4
 Well No. 1 Riddle Farm _____
Empire Company _____

NORTH

WEST

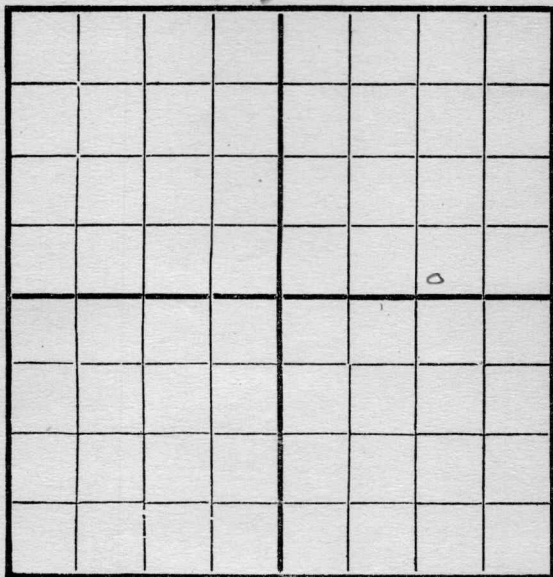

EAST

SOUTH

Location _____

Rig Up _____

Drilling and remarks

Rigged up

RECORD

Cased _____ in. _____ Ft.

Sand _____

Gas _____

Oil _____

Total Depth _____

PRODUCTION

1st 24 hrs. Nat. _____

First 24 hrs. after shot _____

Gas _____ Cu. Ft.

Dry Hole _____

Abandoned _____

Date

1/1, 1917 Land Scout

Map No. _____ Sec. 3 Twp. 28 R. 4

Well No 1212 Farm _____

_____ Company

NORTH

[illegible]

SOUTH

Location _____

Rig Up-----

Drilling and remarks

RECORD

Cased-----in. -----Ft.

Sand _____

Gas _____

Oil _____

Total Depth_____

PRODUCTION

1st 24 hrs. Nat.-----

1st 24 hrs. after shot-----

Gas-----Cu. Ft.

Dry Hole-----


Abandoned_--- -----

Date _____

191 Scout

Map No. _____ Sec. 3 Twp. 28 R. 4
 Well No. 1 Ridge Farm _____
Company Company _____

NORTH

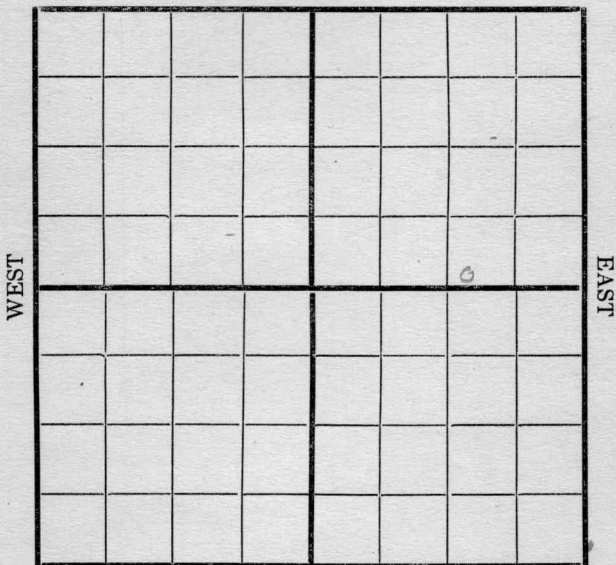

SOUTH

Location _____
 Rig Up _____
 Drilling and remarks _____

180'

RECORD

Cased _____ in. _____ Ft.
 Sand _____
 Gas _____
 Oil _____
 Total Depth _____

PRODUCTION

1st 24 hrs. Nat. _____
 1st 24 hrs. after shot _____
 Gas _____ Cu. Ft.
 Dry Hole _____
 Abandoned _____

Date

4/15, 1917 Cooley Scout

Map No. _____ Sec. 3 Twp. 28 R. 4

Well No. 1 Kiddle Farm
Empire Company

NORTH

[illegible]

SOUTH

Location _____

Rig Up-----

Drilling and remarks

570

RECORD

Cased-----in. -----Ft.

Sand_____

Gas _____

Oil _____

Total Depth_____

PRODUCTION

1st 24 hrs. Nat.

1st 24 hrs. after shot-----

Gas..... Cu. Ft.

Dry Hole.....


Abandoned.....

Date _____

1/22, 1917. *Car. Jeff* Scout

Map No. _____ Sec. 3 Twp. 28 R. 4
 Well No. 1 Riddle Farm _____
Enterprise Company _____

NORTH

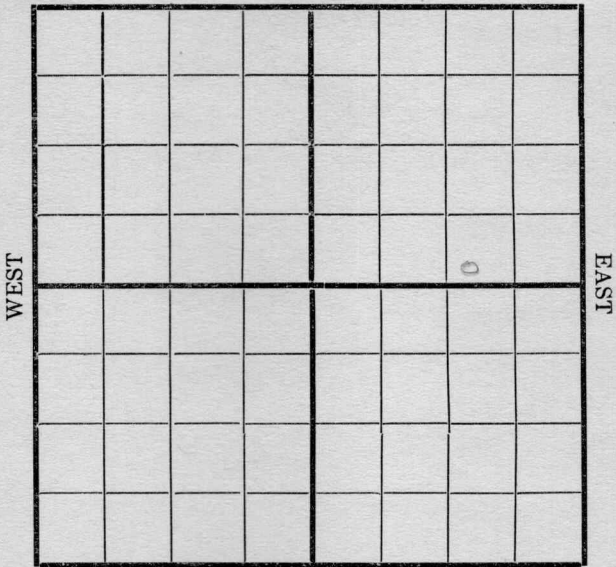

SOUTH

Location _____
 Rig Up _____
 Drilling and remarks

RECORD
 Cased _____ in. _____ Ft.
 Sand _____
 Gas _____
 Oil _____
 Total Depth _____

PRODUCTION
 1st 24 hrs. Nat. _____
 1st 24 hrs. after shot _____
 Gas _____ Cu. Ft.
 Dry Hole _____
 Abandoned _____


750'

Date 1/29 1917 C. D. [Signature] Scout

Map No. _____ Sec. 3 Twp. 28 R. 4Well No. 1 Riddle Farm _____Company Cummins

NORTH

WEST

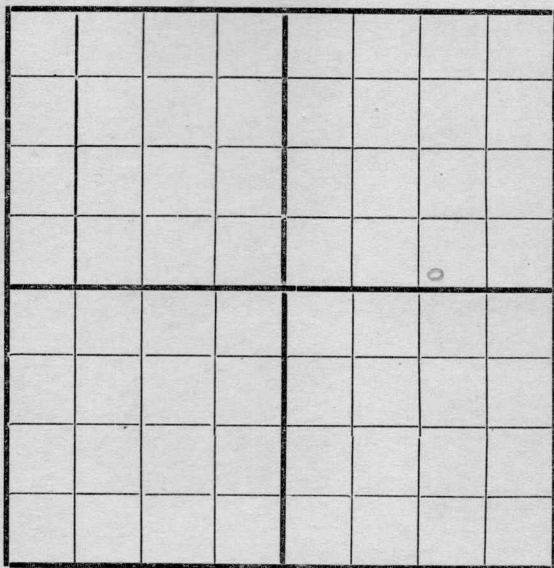

EAST

SOUTH

Location _____

Rig Up _____

Drilling and remarks

1010'

RECORD

Cased _____ in. _____ Ft.

Sand _____

Gas _____

Oil _____

Total Depth _____

PRODUCTION

1st 24 hrs. Nat. _____

1st 24 hrs. after shot _____

Gas _____ Cu. Ft.

Dry Hole _____


Abandoned _____

Date

2/5, 1917 Cummins Scout

Map No. _____ Sec. 3 Twp. 28 R. 4
 Well No. 1 Riddle Farm _____
Emery Company _____

NORTH

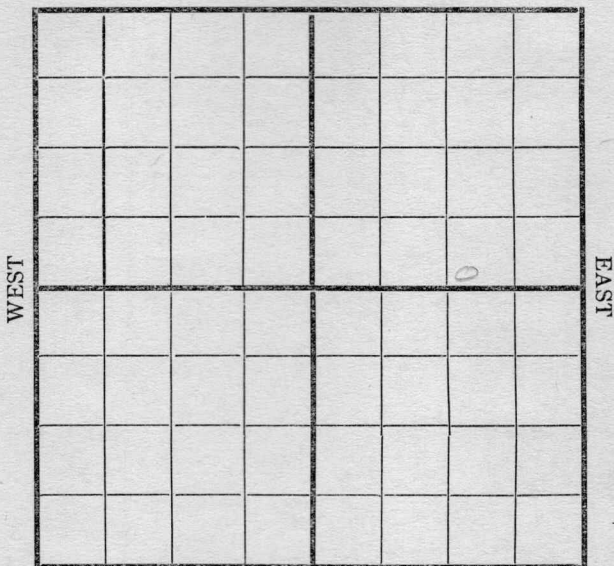

SOUTH

Location _____
 Rig Up _____
 Drilling and remarks _____

Under
Reamer
1010

RECORD

Cased _____ in. _____ Ft.
 Sand _____
 Gas _____
 Oil _____
 Total Depth _____

PRODUCTION


1st 24 hrs. Nat. _____
 1st 24 hrs. after shot _____
 Gas _____ Cu. Ft.
 Dry Hole _____
 Abandoned _____

Date 2/2, 1917 C. Emery Scout

Map No. _____ Sec. 3 Twp. 38 R. 4
 Well No. 3 Riddlee Farm _____
Amesbury Company _____

NORTH

WEST

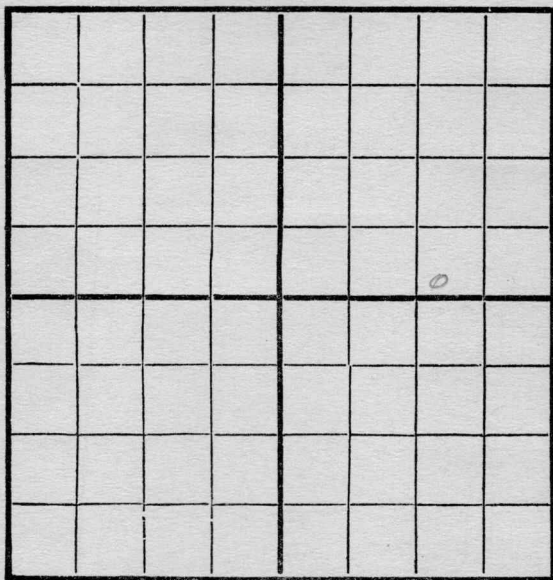

EAST

SOUTH

Location _____

Rig Up _____

Drilling and remarks

U. R
1010

RECORD

Cased _____ in. _____ Ft.

Sand _____

Gas _____

Oil _____

Total Depth _____

PRODUCTION

1st 24 hrs. Nat. _____

First 24 hrs. after shot _____

Gas _____ Cu. Ft.

Dry Hole _____


Abandoned _____

Date

2/19, 1917 Condy Scout

Map No. _____ Sec. 3 Twp. 28 R. 4
 Well No. 1 Riddle Farm _____
Engine Company _____

NORTH

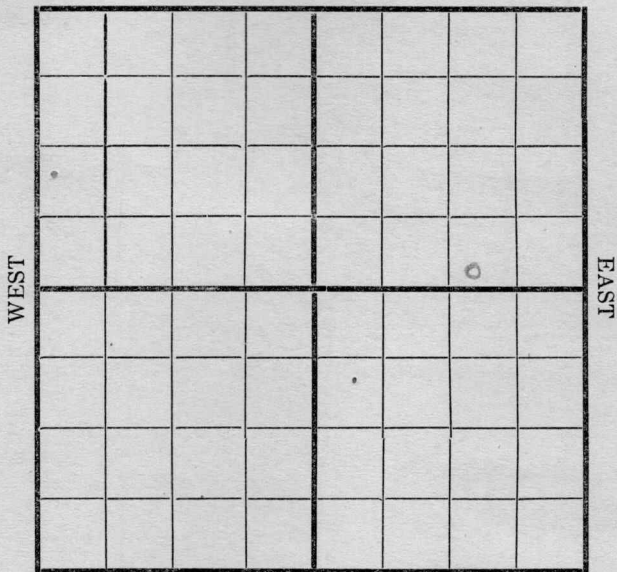

SOUTH

Location _____
 Rig Up _____
 Drilling and remarks _____

1000

RECORD

Cased _____ in. _____ Ft.
 Sand _____
 Gas _____
 Oil _____
 Total Depth _____

PRODUCTION

1st 24 hrs. Nat. _____
 1st 24 hrs. after shot _____
 Gas _____ Cu. Ft.
 Dry Hole _____
 Abandoned _____

Date


Feb 2 1912 Condey Scout

Map No. _____ Sec. 3 Twp. 28 R. 4

Well No. 1 Riddle Farm

Empire Company

NORTH

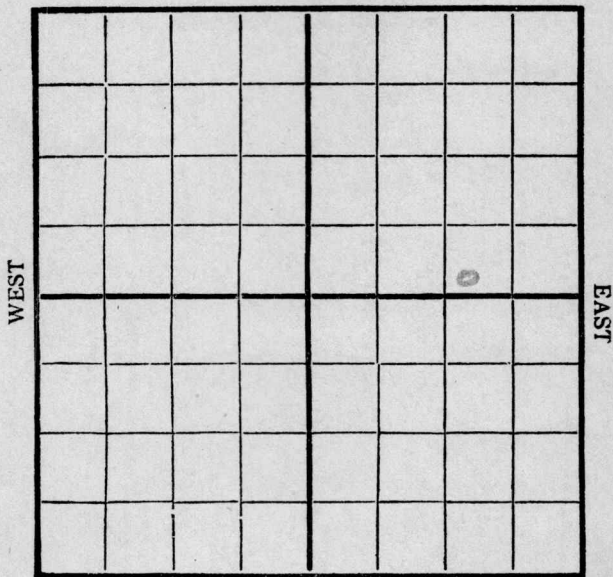

SOUTH

REMARKS:

1240

Date

3/5, 1917

Carley


Scout

Map No. _____ Sec. 3 Twp. 28 R. 4
 Well No. 1 Biddle Farm _____
Cummins Company _____

NORTH

WEST

EAST

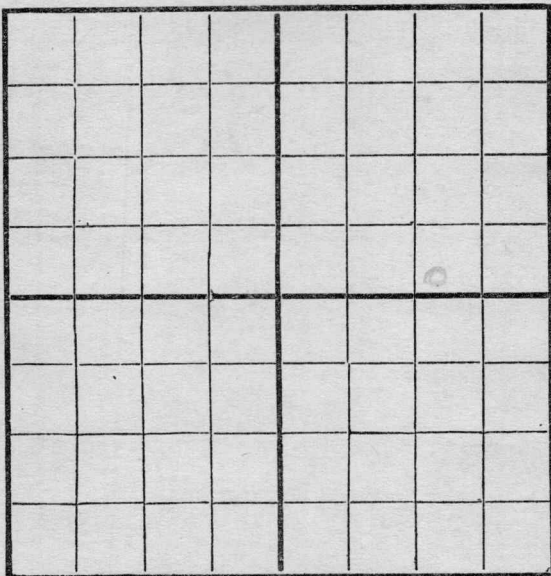

SOUTH

Location _____
 Rig Up _____
 Drilling and remarks

1360'

RECORD

Cased _____ in. _____ Ft.
 Sand _____
 Gas _____
 Oil _____
 Total Depth _____

PRODUCTION

1st 24 hrs. Nat. _____
 1st 24 hrs. after shot _____
 Gas _____ Cu. Ft.
 Dry Hole _____
 Abandoned _____


Date

3/12, 1917 Cummins Scout

Map No. _____ Sec. 3 Twp. 28 R. 4Well No. 1 Ridge Farm _____
Empire Company _____

NORTH

WEST

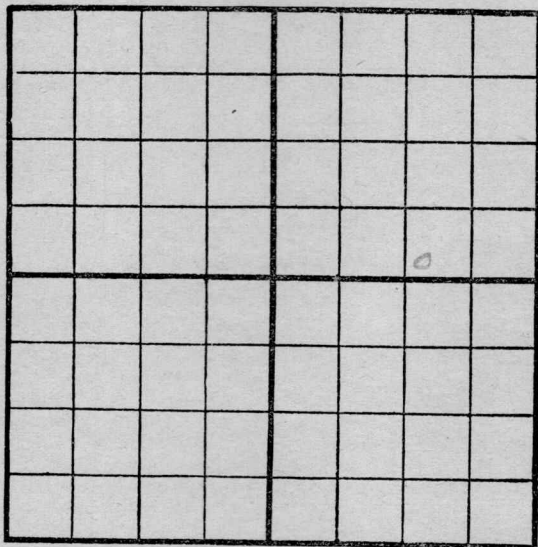

EAST

SOUTH

Location _____

Rig Up _____

Drilling and remarks

1600'

RECORD

Cased _____ in. _____ Ft.

Sand _____

Gas _____

Oil _____

Total Depth _____

PRODUCTION

1st 24 hrs. Nat. _____

1st 24 hrs. after shot _____

Gas _____ Cu. Ft.

Dry Hole _____

Abandoned _____

Date

3/9, 1917Candys Scout

Map No. _____ Sec. 3 Twp. 28 R. 4Well No. 1 Riddle Farm _____Engine Company _____

NORTH

WEST

EAST

SOUTH

Location _____

Rig Up _____

Drilling and remarks
3040

RECORD

Cased _____ in. _____ Ft.

Sand _____

Gas _____

Oil _____

Total Depth _____

PRODUCTION

1st 24 hrs. Nat. _____

1st 24 hrs. after shot _____

Gas _____ Cu. Ft.

Dry Hole _____

Abandoned _____

Date

3/26, 1917 C. E. S. Scout

Map No. _____ Sec. 3 Twp. 28 R. 4
 Well No. 1 Riddle Farm _____
Engine Company _____

NORTH

WEST

EAST

SOUTH

Location _____

Rig Up _____

Drilling and remarks

2200'

RECORD

Cased _____ in. _____ Ft.

Sand _____

Gas _____

Oil _____

Total Depth _____

PRODUCTION

1st 24 hrs. Nat. _____

First 24 hrs. after shot _____

Gas _____ Cu. Ft.

Dry Hole _____

Abandoned _____

Date


4/4, 191 7 C. C. C. Scout _____

Map No. _____ Sec. 3 Twp. 28 R. 4
 Well No. 1 Riddle Farm _____
Engine Company _____

NORTH

WEST

EAST

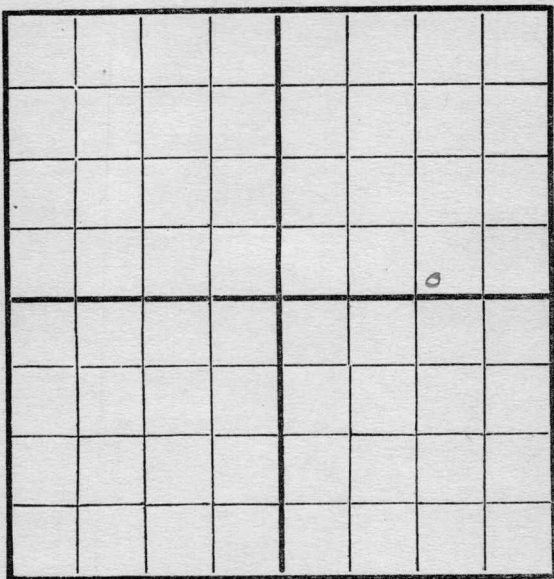

SOUTH

Location _____

Rig Up _____

Drilling and remarks

2585'

RECORD

Cased _____ in. _____ Ft.

Sand _____

Gas _____

Oil _____

Total Depth _____

PRODUCTION

1st 24 hrs. Nat. _____

1st 24 hrs. after shot _____

Gas _____ Cu. Ft.

Dry Hole _____


Abandoned _____

Date

4/10, 1917, Candiff Scout

Map No. _____ Sec. 3 Twp. 28 R. 4
 Well No. 1 Riddle Farm _____
Empire Company _____

NORTH

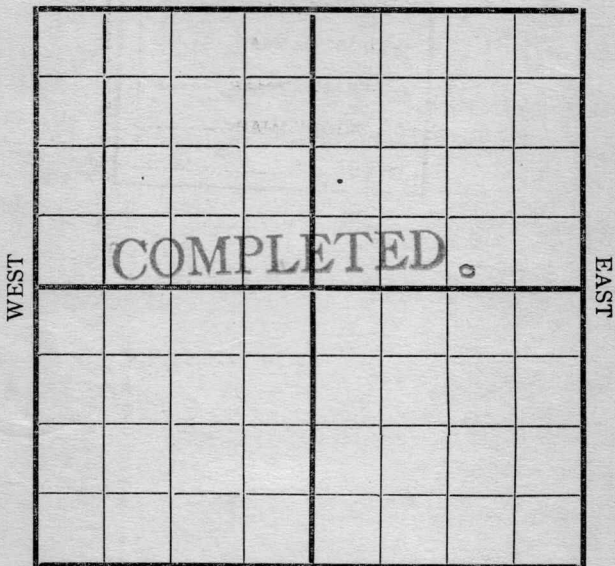

SOUTH

Location _____
 Rig Up _____
 Drilling and remarks _____

*Estimated
 good for
 60 Bbls*

RECORD

Cased _____ in. _____ Ft.
 Sand 2590-2615
 Gas _____
 Oil _____
 Total Depth _____

PRODUCTION

1st 24 hrs. Nat. _____
 1st 24 hrs. after shot _____
 Gas _____ Cu. Ft.
 Dry Hole _____
 Abandoned _____

Date

4/17, 1917 Candy Scout