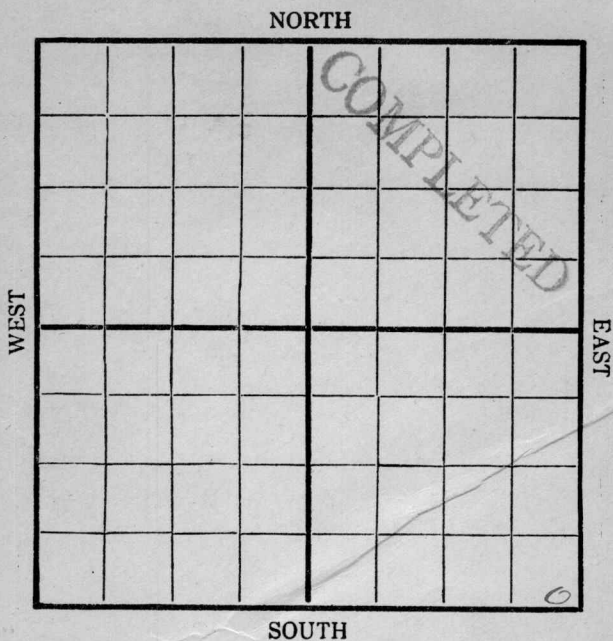


Map No. _____ Sec. 3 Twp. 28 R. 4Well No. 6 Buck Farm _____
Corden Company _____

Location _____

Rig Up 10/30

Drilling Remarks:

Drilling Remarks:

200 = 11/27800 = 12/141050 = 12/111650 = 12/181665 = 12/282170 = 1/8/172570 = 1/15

RECORD

PRODUCTION

Cased _____ in _____ Ft.

1st 24 hrs. Nat. _____

Sand _____

1st 24 hrs. after shot _____

Gas _____

Gas _____ Cu. Ft.

Oil _____

Dry Hole _____

Total Depth _____

Abandoned _____

Map No. _____ Sec. 3 Twp. 28 R. 4Well No. 6 Beek FarmCassidy Company

NORTH

WEST

EAST

SOUTH

Location ✓Rig Up ✓

Drilling and remarks

RECORD

Cased _____ in. _____ Ft.

Sand _____

Gas _____

Oil _____

Total Depth _____

PRODUCTION

1st 24 hrs. Nat. _____

First 24 h.s. after shot _____

Gas _____ Cu. Ft.

Dry Hole _____


Abandoned _____

Date

10/30, 191 6 Cassidy Scout

Map No. _____ Sec. 3 Twp. 28 R. 4
Well No. 6 Beck Farm _____
Condon Company _____

NORTH

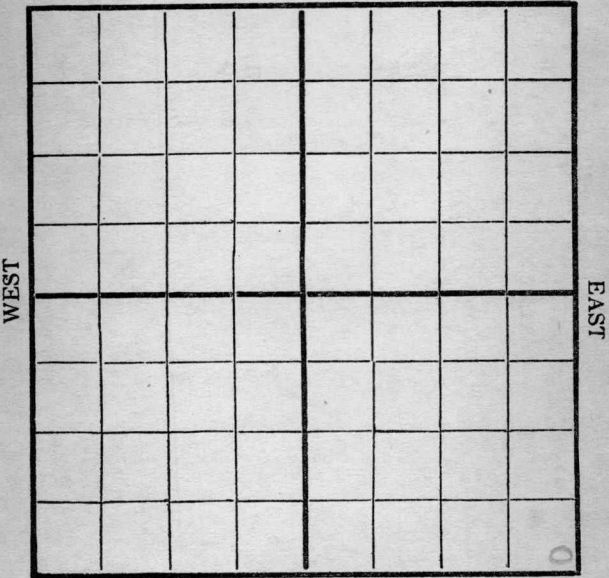

SOUTH

	RECORD
Location _____	Cased _____ in. _____ Ft.
Rig Up _____	Sand _____
Drilling and remarks	Gas _____
<u>Rigging up</u>	Oil _____
	Total Depth _____

PRODUCTION	
1st 24 hrs. Nat. _____	
1st 24 hrs. after shot _____	
Gas _____	Cu. Ft.
Dry Hole _____	
Abandoned _____	


Date 11/20, 1916 Condon Scout

Map No. _____ Sec. 3 Twp. 28 R. 4
 Well No. 6 Beck Farm _____
Cobden Company _____

NORTH

WEST

EAST

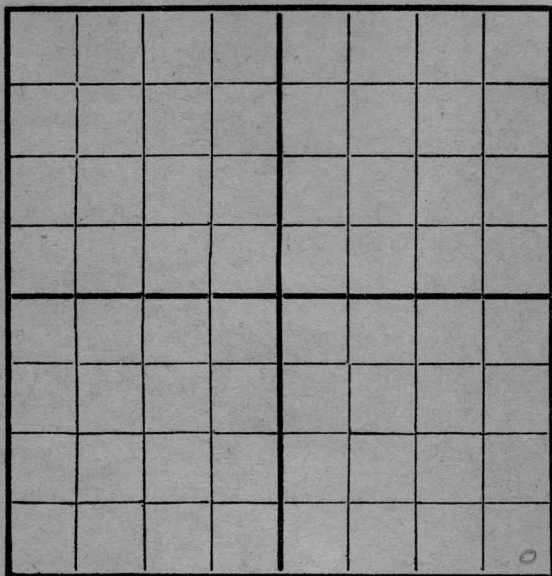

SOUTH

Location _____
 Rig Up _____
 Drilling and remarks _____

200'

RECORD

Cased _____ in. _____ Ft.
 Sand _____
 Gas _____
 Oil _____
 Total Depth _____

PRODUCTION

1st 24 hrs. Nat. _____
 1st 24 hrs. after shot _____
 Gas _____ Cu. Ft.
 Dry Hole _____
 Abandoned _____


Date

4/27, 1916 Cobden Scout

Map No. _____ Sec. 3 Twp. 28 R. 4
 Well No. 6 Beck Farm _____
Cosden Company _____

NORTH

WEST

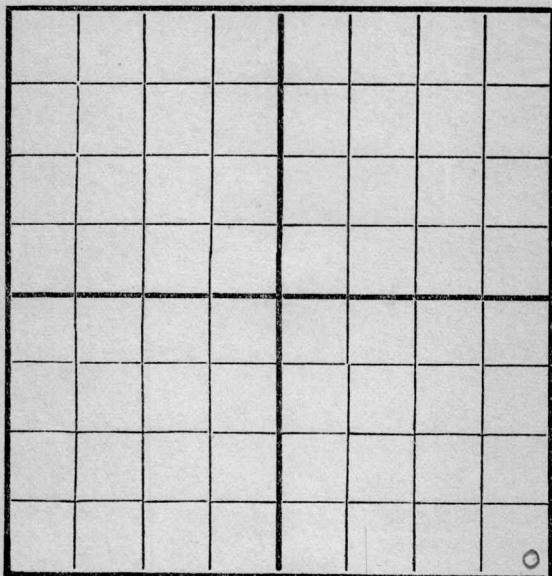

EAST

SOUTH

Location _____

Rig Up _____

Drilling and remarks

800'

RECORD

Cased _____ in. _____ Ft.

Sand _____

Gas _____

Oil _____

Total Depth _____

PRODUCTION

1st 24 hrs. Nat. _____

1st 24 hrs. after shot _____

Gas _____ Cu. Ft.

Dry Hole _____

Abandoned _____

Date

12/4, 191 6, Cosden Scout

Map No. _____ Sec. 3 Twp. 28 R. 4


Well No. 6 Beck Farm _____

Canadian Company _____

NORTH

WEST

EAST

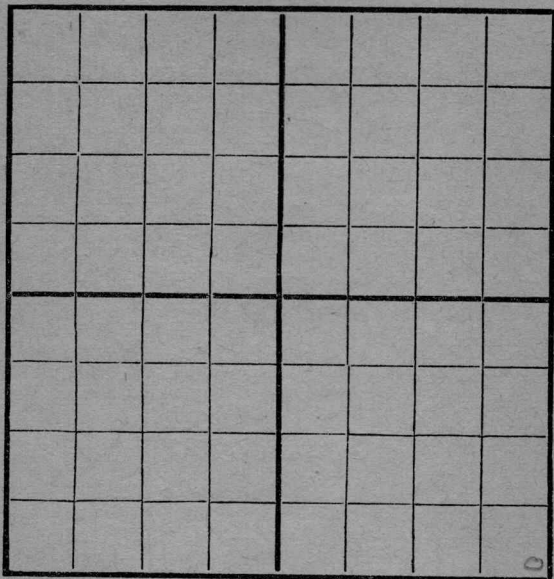

SOUTH

RECORD

Location _____

Rig Up _____

Drilling and remarks

Cased _____ in. _____ Ft.

Sand _____

Gas _____

Oil _____

Total Depth _____

PRODUCTION

1st 24 hrs. Nat. _____

1st 24 hrs. after shot _____

Gas _____ Cu. Ft.

Dry Hole _____


Abandoned _____

Date

10/11, 1916 Co. Jeff Scout

Map No. _____ Sec. 3 Twp. 28 R 4
 Well No. 6 Beck Farm _____
Cosden Company _____

NORTH

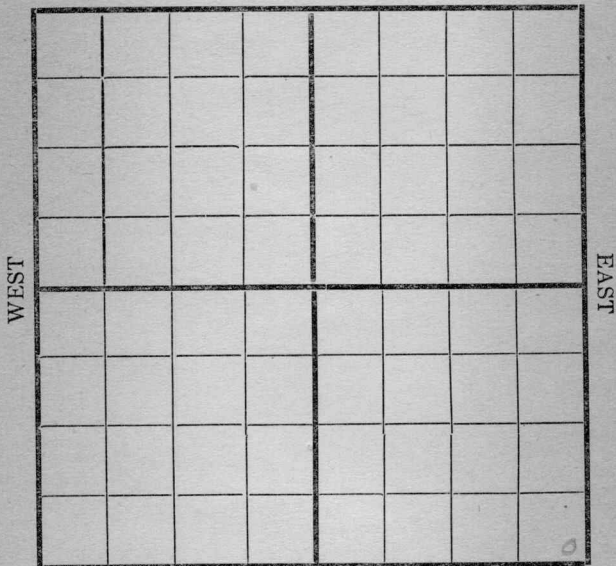

SOUTH

Location _____
 Rig Up _____
 Drilling and remarks

1650'

RECORD

Cased _____ in. _____ Ft.
 Sand _____
 Gas _____
 Oil _____
 Total Depth _____

PRODUCTION

1st 24 hrs. Nat. _____
 1st 24 hrs. after shot _____
 Gas _____ Cu. Ft.
 Dry Hole _____
 Abandoned _____


Date

12/18 6 Cordiff Scout
 _____, 191 _____

Map No. _____ Sec. 3 Twp. 28 R. 4Well No. 6 Bessie Farm __________Cosden Company _____

NORTH

WEST

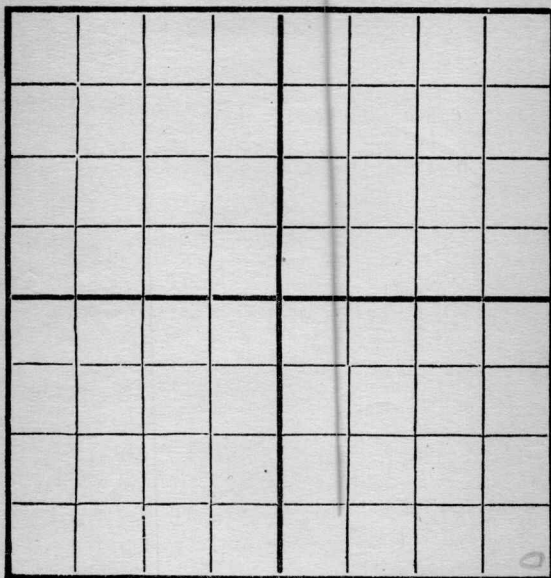

EAST

SOUTH

Location _____

Rig Up _____

Drilling and remarks

Shut Down
1665

RECORD

Cased _____ in. _____ Ft.

Sand _____

Gas _____

Oil _____

Total Depth _____

PRODUCTION

1st 24 hrs. Nat. _____

First 24 hrs. after shot _____

Gas _____ Cu. Ft.

Dry Hole _____

Abandoned _____


Date

12/28 191 *6 Cosden* Scout

Map No. _____ Sec. 3 Twp. 28 R. 4
 Well No. 6 Beck _____ Farm
Casden _____ Company

NORTH

WEST

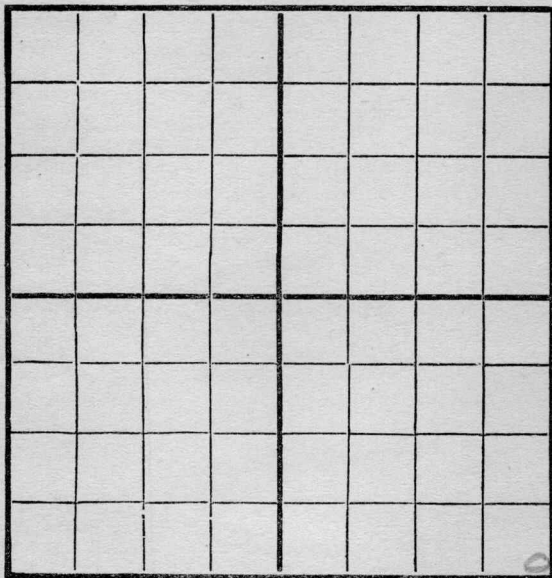

EAST

SOUTH

Location _____

Rig Up _____

Drilling and remarks

1685

RECORD

Cased _____ in. _____ Ft.

Sand _____

Gas _____

Oil _____

Total Depth _____

PRODUCTION

1st 24 hrs. Nat. _____

First 24 hrs. after shot _____

Gas _____ Cu. Ft.

Dry Hole _____

Abandoned _____

Date

1/1, 1917 Casden Scout

Map No. _____ Sec. 3 Twp. 38 R. 4
 Well No. 6 Bush Farm _____
Cooder Company _____

NORTH

WEST

EAST

SOUTH

Location _____
 Rig Up _____
 Drilling and remarks _____

2170

RECORD

Cased _____ in. _____ Ft.
 Sand _____
 Gas _____
 Oil _____
 Total Depth _____

PRODUCTION

1st 24 hrs. Nat. _____
 1st 24 hrs. after shot _____
 Gas _____ Cu. Ft.
 Dry Hole _____
 Abandoned _____


Date

1/8, 1912 Cooder Scout

Map No. _____ Sec. 3 Twp. 28 R 4Well No. 613011 Farm _____Cosden Company _____

NORTH

WEST

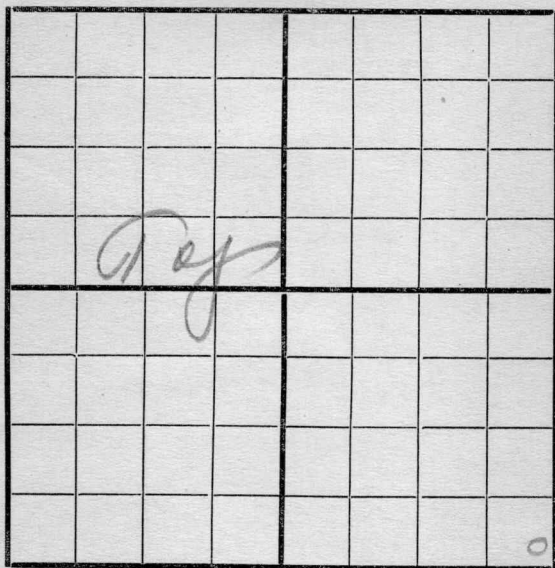

EAST

SOUTH

Location _____

Rig Up _____

Drilling and remarks

Tap sand 2570
Pulling big
Pipe

RECORD

Cased _____ in. _____ Ft.

Sand _____

Gas _____

Oil _____

Total Depth _____

PRODUCTION

1st 24 hrs. Nat. _____

1st 24 hrs. after shot _____

Gas _____ Cu. Ft.

Dry Hole _____

Abandoned _____


Date

1/15, 1917 Cosden Scout

Map No. 11 Sec. 3 Twp. 28 R. 4
 Well No. 6 Beck Farm _____
Corden Company _____

NORTH

WEST

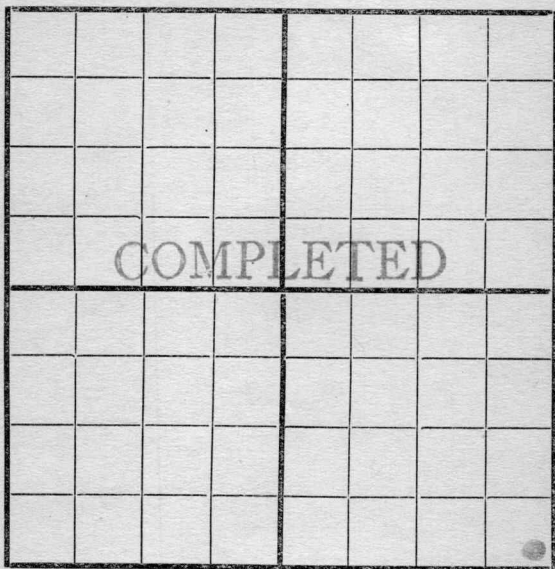

EAST

SOUTH

Location _____

Rig Up _____

Drilling and remarks

Estimated

at 500 Bbls

RECORD

Cased _____ in. _____ Ft.

Sand 2568-2596

Gas _____

Oil _____

Total Depth _____

PRODUCTION

1st 24 hrs. Nat. _____

1st 24 hrs. after shot _____

Gas _____ Cu. Ft.

Dry Hole _____

Abandoned _____

Date

1/23

191

7

Corden

Scout