

Butler


FORM 51

KANSAS
4E

Section 3 Township 28 Range

Well No. #1 Dumas

Company Murfin & Ewalt

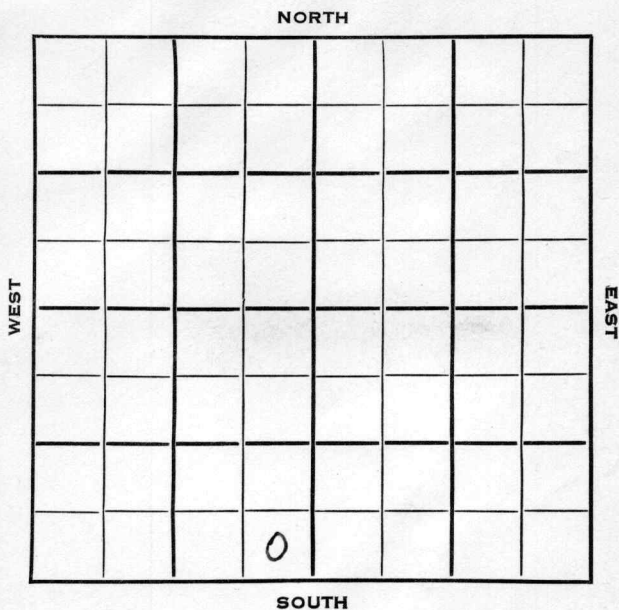

Butler

KANSAS

SEC. 3	TWP. 28	R. 4E
-----------	------------	----------

WELL NO.

#1 Dumas

FARM

COMPANY.

Murfin & Ewalt

CONTRACTOR

Murfin


_____ Ft. from N. Line

330 _____ Ft. from S. Line

330 _____ Ft. from E. Line

_____ Ft. from W. Line

SE SE SW

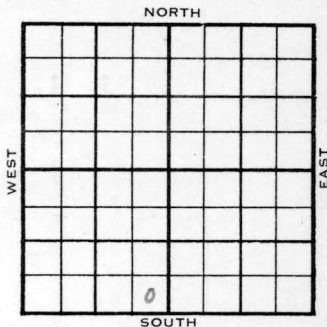

1953

ELEVATION

1267'

REPORT

10/7

M I M

11/4

Spud 10-10-53

D&A

TD 2641'

13" @ 843'


8" @ 1503'

KC 2080', Simp 2627', Arb. 2640'

TD 2641'

D&A

ABANDONED

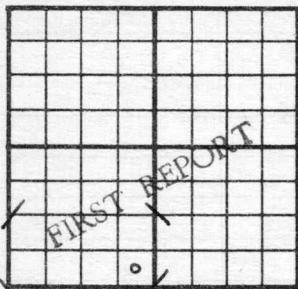County Butler State KansasSec. 3 (Blk.) 28 (Sur.) 4E Map No.Operator Murfin & EwaltWell No. 1 Farm DumasElev. Location SE SE SW330Ft. From S Line SW330Ft. From E Line Quarter1st. Report OCT 7 1953

Completion

Remarks

Murfin - Contr.

Spudding Date

Drlg. Data

M I M

County **Butler** State **Kansas**Sec. **3** (Blk.) **28** (Sur.) **4E** Map No.Operator **Murfin & Ewalt**Well No. **1** Farm **Dumas**Elev. **1267** Location **SE SE SW****330** Ft. From **S** Line **SW****330** Ft. From **E** Line **Quarter**

1st. Report

Completion **NOV 4 1953**

Remarks

Murfin - Contr.Spudding Date **10-10-53**Drig. Data **D & A** **TD 2641****13" @ 843 8" @ 1503 KC 2080****Simp. 2627 Arb. 2640 TD 2641****D & A**