


Section 3 Township 28 Range 4-E

Well No. #1 Dunne

Company Dunn & Strait

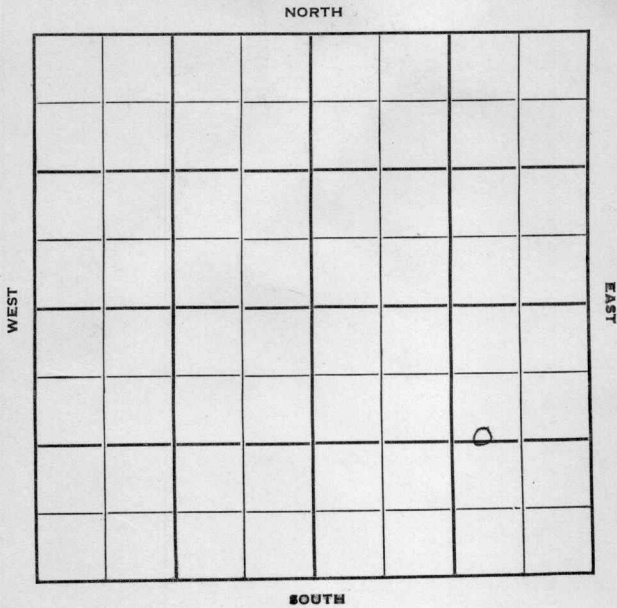

Butler

KANSAS

Sec. 3 Twp. 28 R. 4E

Well No. #1 Dunn Farm

Dunn & Strait Company

Dunn & Strait - Contr. Contractor


 Ft. from N. Line

1400' Ft. from S. Line

990' Ft. from E. Line

 Ft. from W. Line

C W L E $\frac{1}{2}$ SE

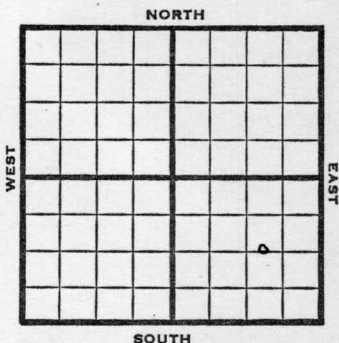

1950 Elev. 1282' REPORT

10/18 Spud 10-12-50
8" @ 80'

11/22 Drlg. 1600'

8" @ 80

Simp 2581

5" @ 2581

TD 2600

Comp 15 bopd

Completed

COMPLETED

County Butler State KansasSec. 3 (Blk.) 28 (Sur.) 4E Map No.Operator Dunn & StraitWell No. 1 Farm DunnElev. 1282 Location C W L E $\frac{1}{2}$ SE

FIRST REPORT

1400 Ft. From S Line SE990 Ft. From E Line Quarter1st. Report OCT 18 1950

Completion


Remarks

Dunn & Strait - Contr.Spudding Date 10-12-50

Drlg. Data

8" @ 80 drlg. 1600

J. E. TYRA

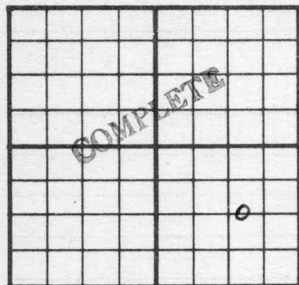County Butler State KansasSec. 3 (Blk.
Twp.) 28 (Sur.
Rge.) 4E Map No.Operator Dunn & StraitWell No. 1 Farm DunnElev. 1282 Location C W L E₂ SE1400 Ft. From S Line SE990 Ft. From E Line Quarter

1st. Report

Completion NOV 22 1950

Remarks

Dunn & Strait - Contr.Spudding Date 10-12-50Drlg. Data Oil well TD 26008" @ 80 Simp. 2581 5" @ 2581TD 2600 Comp. 15 bopd

J. E. TYRA