


Section 3 Township 28 Range 4 EWell No. # 2 DunneCompany D. E. Dunne Jr.

NORTH

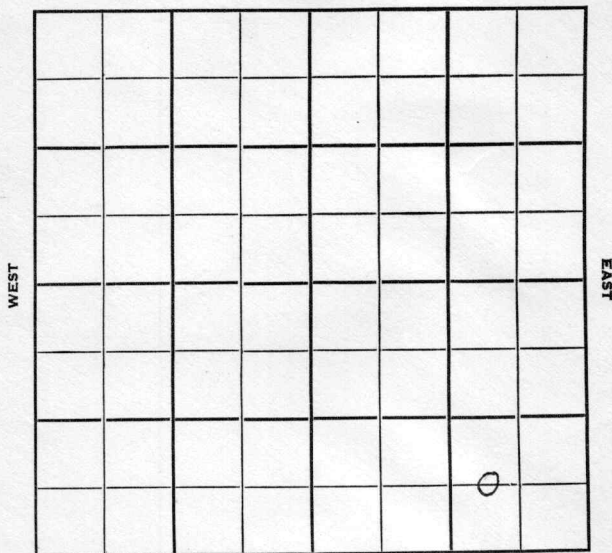

SOUTH

Butler

KANSAS

Sec. 3 Twp. 28 R. ✓ 4E

Well No. #2 Dunne Farm

D. E. Dunne, Jr. Company

Morrison Drlg. - Contr. Contractor


_____ Ft. from N. Line

660' Ft. from S. Line

990' Ft. from E. Line

_____ Ft. from W. Line

C W L SE SE

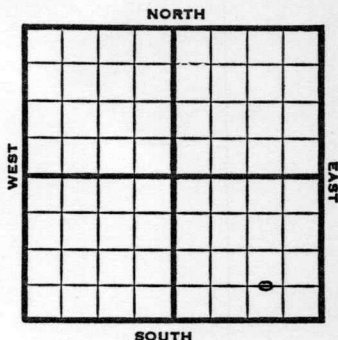

1951

Elev. 1289'

REPORT

4/11

Spud 4-9-51

8" @ 85'

Drlg. 1020'

5/16

Spud 4-9-51

Oil Well TD 2605

8" @ 85

Simp. 2579

5" @ 2580

TD 2605 Comp. 65 bopd

COMPLETE

County Butler State Kansas
 Sec. 3 (Blk.) 28 (Sur.) 4E Map No.
 (Twp.)
 Operator D. E. Dunne Jr.
 Well No. 2 Farm Dunne
 Elev. Location C W L SE SE



660 Ft. From S Line SE
990 Ft. From E Line Quarter
 1st. Report APR 11 1951
 Completion
 Remarks
Morrison Drlg. - Contr.
 Spudding Date 4-9-51

Drlg. Data

8" @ 85 drlg. 1020

J. E. TYRA

County Butler State KansasSec. 3 (Blk.
Twp.) 28 (Sur.
Rge.) 4E Map No.Operator D. E. Dunne Jr.Well No. 2 Farm DunneElev. 1289 Location C W L SE SE660 Ft. From S Line SE990 Ft. From E Line Quarter

1st. Report _____

Completion MAY 16 1951

Remarks _____

Morrison D.,lg. - Contr.Spudding Date 4-9-51Drlg. Data Oil well TD 26058" @ 85 Simp. 2579 5" @ 2580 TD 2605Comp. 65 bopd

J. E. TYRA