


Section 3 Township 28 Range 4E

Well No. 4 Dunne

Company D. E. Dunne

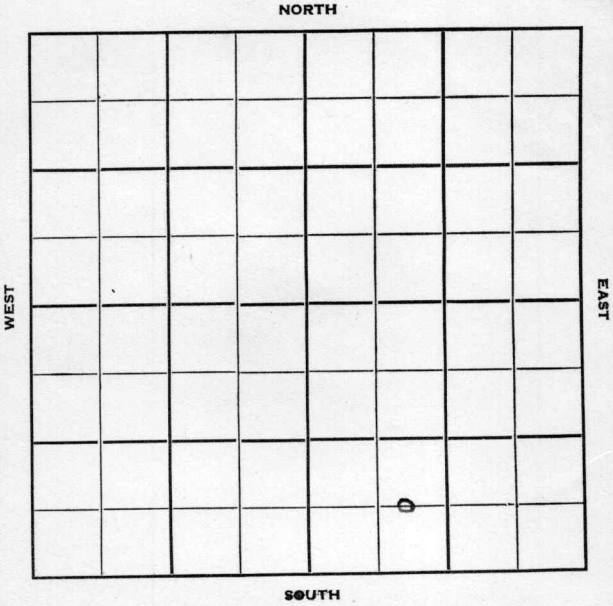

Butler

KANSAS

Sec. 3 Twp. 28 R. 4E

Well No. #4 Dunne Farm

D. E. Dunne Company

Augusta Pool

Ft. from N. Line

660'


Ft. from S. Line

Ft. from E. Line

990'

Ft. from W. Line

C E L SW SE

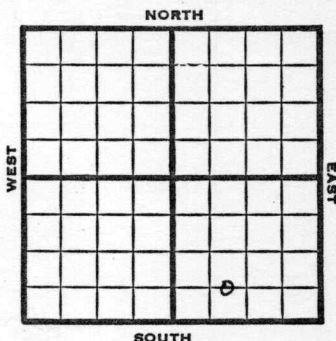

1951

Elev. 1278' REPORT

8/1

Spud 7-30-51

8" @95'

Drlg. 1030'

8/15

Spud 7-30-51

Oil Well TD 2626

8" @ 95

Simp 2585 5" @ 2583

TD 2603 DD 2618

35 qt/2598-2618 DD 2626

Fu 500' oil 16 hr.

Comp. 20 bopd

COMPLETED

County Butler State Kansas
 Sec. 3 (Blk.) 28 (Sur.) 4E Map No.
 Operator D. E. Dunne
 Well No. 4 Farm Dunne

Elev. _____ Location C E L SW SE (old wells
 abd)



660 Ft. From S Line SE

990 Ft. From W Line Quarter

1st. Report AUG 1 1951

Completion _____

Remarks _____

Spudding Date 7-30-51

Drlg. Data _____

Augusta Pool

8" @ 95 drlg. 1030

J. E. TYRA

Kansas

(Blk.)
(Twp.)

D. E. Dunne

4 Farm Dunne

1278

COMPLETE

660 Ft. From S Line SE

990 Ft. From W Line Quarter

1st. Report

Completion

Remarks August a Pool

Spudding Date 7-30-51

Drlg. Data Oil well TD 2626

8" @ 95 Simp. 2585 5" @ 2583 TD 2603

DD 2618 35 qt/ 2598-2618 DD 2626

FU 500' oil 16 hr. Comp. 20 bopd

J. E. TYRA