

Map No. _____ Sec 3 Twp 28 R 4Well No. 1 New Farm _____Empire Company _____

NORTH

WEST

EAST

SOUTH

Location _____

Rig Up 11/20/16

Drilling Remarks:

Drilling Remarks:

R. 21 = 11/27-12/4 = 12/11-12/18400' = 12/28770 = 1/8/171220 = 1/15

RECORD

PRODUCTION

Cased _____ in _____ Ft.

1st 24 hrs. Nat. _____

Sand _____

1st 24 hrs. after shot _____

Gas _____

Gas _____ Cu. Ft.

Oil _____


Dry Hole _____

Total Depth _____

Abandoned _____

Map No. _____ Sec. 3 Twp. 28 R. 4
Well No. 1 Hall Farm
Cummins Company

NORTH

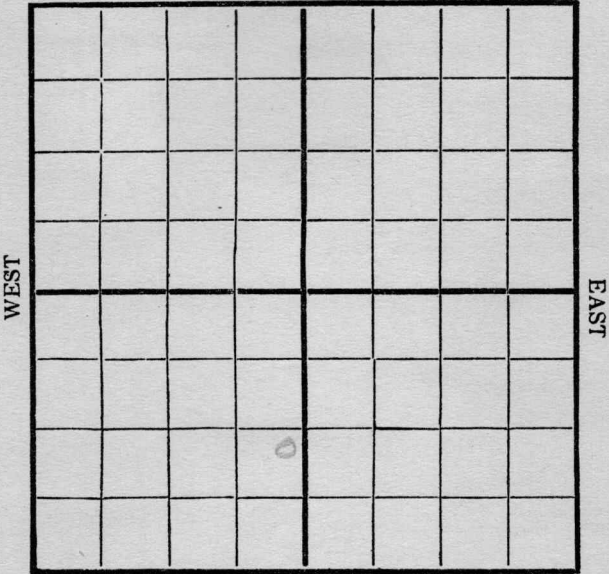

SOUTH

Location _____ Rig Up ☒ Drilling and remarks _____	RECORD
	Cased _____ in. _____ Ft.
	Sand _____
	Gas _____
	Oil _____
	Total Depth _____
	PRODUCTION
	1st 24 hrs. Nat. _____
	1st 24 hrs. after shot _____
	Gas _____ Cu. Ft.
	Dry Hole _____
	Abandoned _____


Date 11/20 1916 Cummins Scout

Map No. _____ Sec. 3 Twp. 28 R. 4
 Well No. 1 Homer Farm _____
Campbell Company _____

NORTH

WEST

EAST

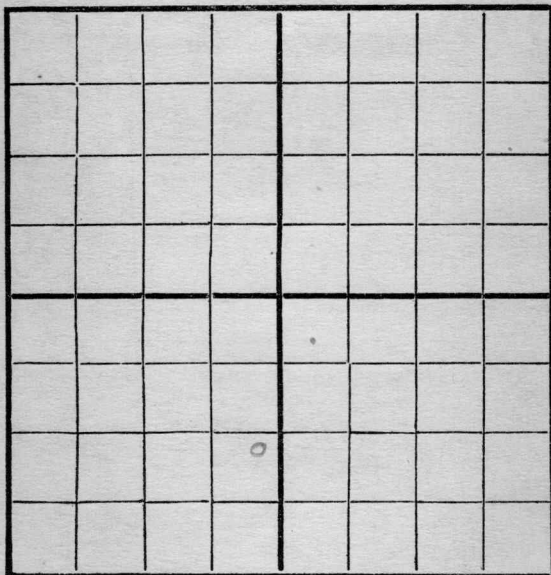

SOUTH

Location _____
 Rig Up ☒ _____
 Drilling and remarks _____

RECORD

Cased _____ in. _____ Ft.
 Sand _____
 Gas _____
 Oil _____
 Total Depth _____

PRODUCTION

1st 24 hrs. Nat. _____
 1st 24 hrs. after shot _____
 Gas _____ Cu. Ft.
 Dry Hole _____
 Abandoned _____


Date

11/27, 1916 Campbell Scout

Map No. _____ Sec. 3 Twp. 28 R. 4

Well No. 1 Haines Farm _____
Empire Company

NORTH

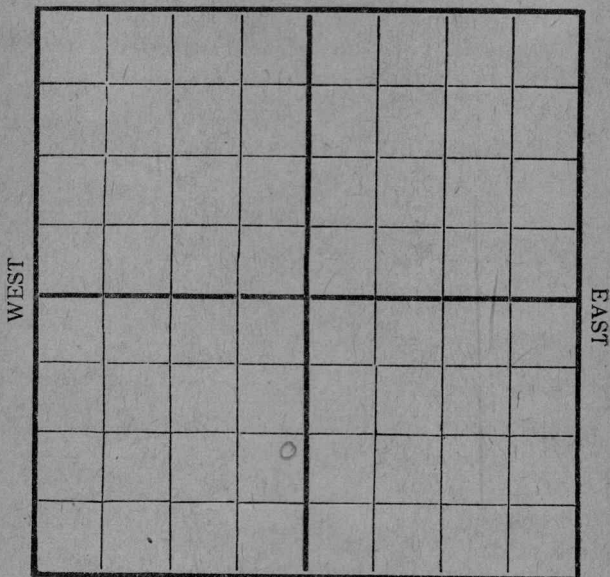

SOUTH

Location _____
 Rig Up ✓ _____
 Drilling and remarks _____

RECORD

Cased _____ in. _____ Ft.
 Sand _____
 Gas _____
 Oil _____
 Total Depth _____

PRODUCTION

1st 24 hrs. Nat. _____
 1st 24 hrs. after shot _____
 Gas _____ Cu. Ft.
 Dry Hole _____
 Abandoned _____

Date

12/4, 1916, Corduff Scout

Map No. _____ Sec. 3 Twp. 28 R. 4Well No. 6 Haines Farm
Engine Company

NORTH

WEST

EAST

SOUTH

Location _____

Rig Up _____

Drilling and remarks

Rigged up

RECORD

Cased _____ in. _____ Ft.

Sand _____

Gas _____

Oil _____

Total Depth _____

PRODUCTION

1st 24 hrs. Nat. _____

1st 24 hrs. after shot _____

Gas _____ Cu. Ft.

Dry Hole _____

Abandoned _____

Date


12/11, 1916 Condy Scout

Map No. _____ Sec. 3 Twp. 28 R. 4Well No. 1 Farm _____Company Emery

NORTH

WEST

EAST

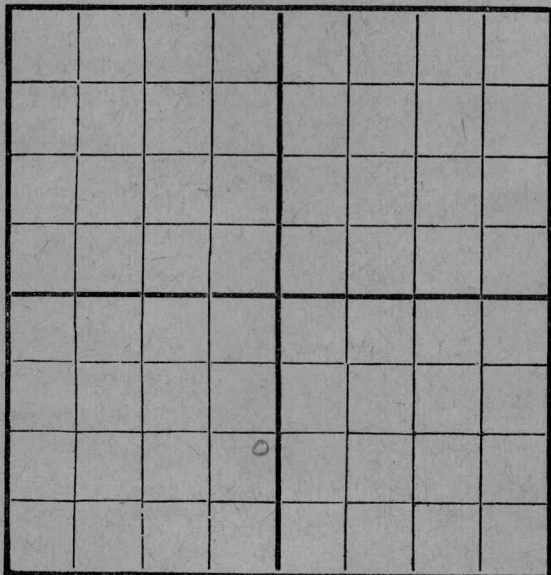

SOUTH

Location _____

Rig Up _____

Drilling and remarks

Rigged up

RECORD

Cased _____ in. _____ Ft.

Sand _____

Gas _____

Oil _____

Total Depth _____

PRODUCTION

1st 24 hrs. Nat. _____

1st 24 hrs. after shot _____

Gas _____ Cu. Ft.

Dry Hole _____

Abandoned _____

Date

7/2/8, 1916 *Conroy* Scout

Map No. _____ Sec. 3 Twp. 28 R. 4Well No. 1-34 Farm _____

_____ Company _____

NORTH

WEST

EAST

SOUTH

Location _____

Rig Up _____

Drilling and remarks

RECORD

Cased _____ in. _____ Ft.

Sand _____

Gas _____

Oil _____

Total Depth _____

PRODUCTION

1st 24 hrs. Nat. _____

First 24 hrs. after shot _____

Gas _____ Cu. Ft.

Dry Hole _____

Abandoned _____

Date


12/28, 1916 Conley Scout

Map No. _____ Sec. 3 Twp. 28 R. 4
 Well No. 1 Home Farm _____
Engine Company _____

NORTH

WEST

EAST

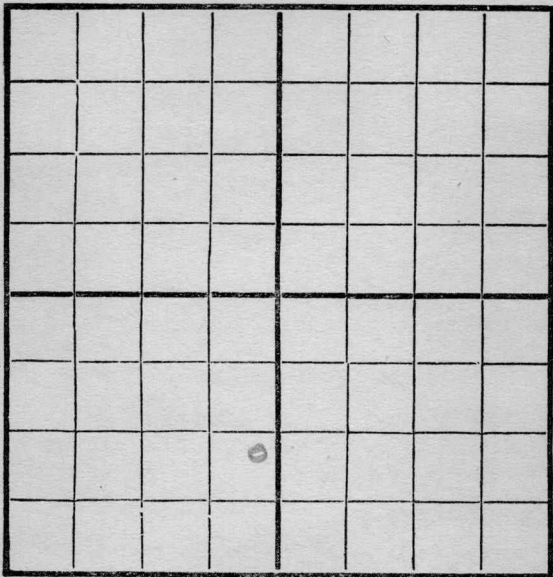

SOUTH

Location _____
 Rig Up _____
 Drilling and remarks _____

465'

RECORD

Cased _____ in. _____ Ft.
 Sand _____
 Gas _____
 Oil _____
 Total Depth _____

PRODUCTION

1st 24 hrs. Nat. _____
 First 24 hrs. after shot _____
 Gas _____ Cu. Ft.
 Dry Hole _____
 Abandoned _____


Date

1/1, 1917 Carly Scout _____

Map No. _____ Sec. 3 Twp. 28 R. 4
 Well No. 1 Homes Farm
Cummins Company

NORTH

WEST

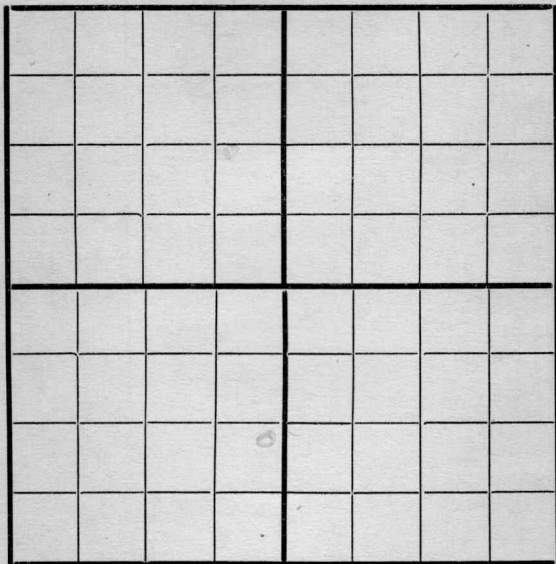

EAST

SOUTH

Location _____
 Rig Up _____
 Drilling and remarks _____

770

RECORD

Cased _____ in. _____ Ft.
 Sand _____
 Gas _____
 Oil _____
 Total Depth _____

PRODUCTION

1st 24 hrs. Nat. _____
 1st 24 hrs. after shot _____
 Gas _____ Cu. Ft.
 Dry Hole _____
 Abandoned _____


Date

1/8, 191 2 Conley Scout

Map No. _____ Sec. 3 Twp. 28 R. 4
 Well No. 1 House Farm _____
Engine Company _____

NORTH

WEST

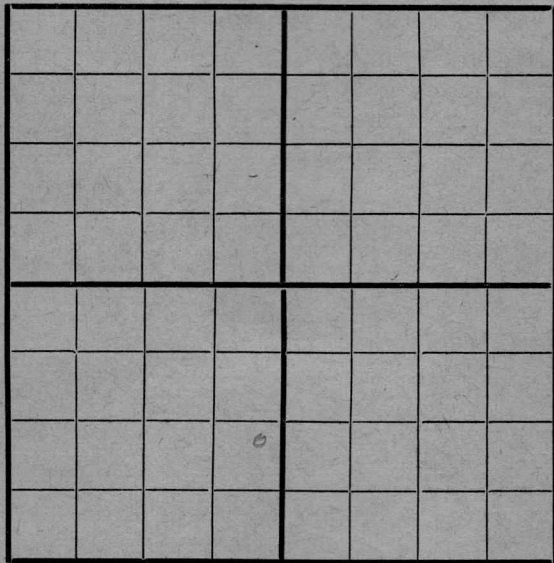

EAST

SOUTH

Location _____

Rig Up _____

Drilling and remarks

1200'

RECORD

Cased _____ in. _____ Ft.

Sand _____

Gas _____

Oil _____

Total Depth _____

PRODUCTION

1st 24 hrs. Nat. _____

1st 24 hrs. after shot _____

Gas _____ Cu. Ft.

Dry Hole _____

Abandoned _____


Date

1/15, 1917

Condit Scout

Map No. _____ Sec. 3 Twp. 28 R. 4
 Well No. 160111 Farm _____
 _____ Company

NORTH

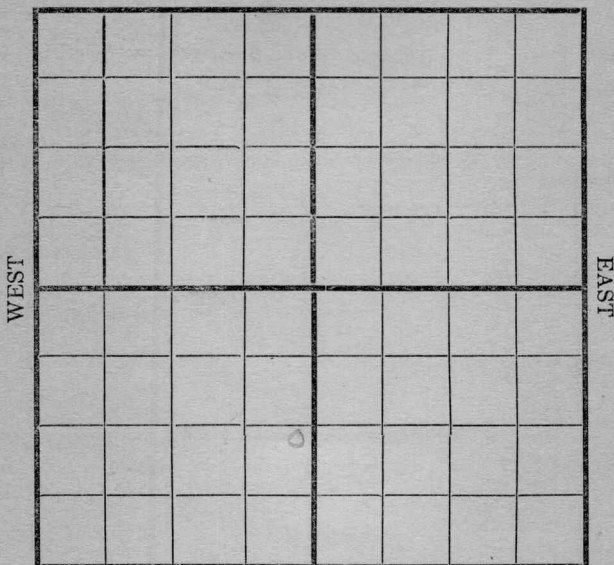


SOUTH

Location _____ Rig Up _____ Drilling and remarks <u>1490</u>	RECORD
	Cased _____ in. _____ Ft.
	Sand _____
	Gas _____
	Oil _____
	Total Depth _____
	PRODUCTION
	1st 24 hrs. Nat. _____
	1st 24 hrs. after shot _____
	Gas _____ Cu. Ft.
	Dry Hole _____
	Abandoned _____

Date 1/22, 1917 Carroll Scout

Map No. _____ Sec. 3 Twp. 28 R. 4
 Well No. 1 Hansen Farm
Enterprise Company

NORTH

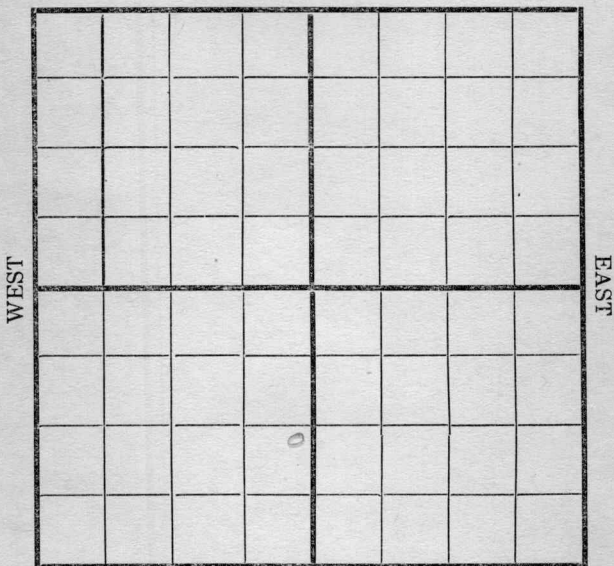

SOUTH

Location _____
 Rig Up _____
 Drilling and remarks

RECORD

Cased _____ in. _____ Ft.
 Sand _____
 Gas _____
 Oil _____
 Total Depth _____

PRODUCTION


1st 24 hrs. Nat. _____
 1st 24 hrs. after shot _____
 Gas _____ Cu. Ft.
 Dry Hole _____
 Abandoned _____

Date

1/29, 1917 C. Conley Scout

Map No. _____ Sec. 3 Twp. 28 R. 4
 Well No. 1 Home Farm
Empire Company

NORTH

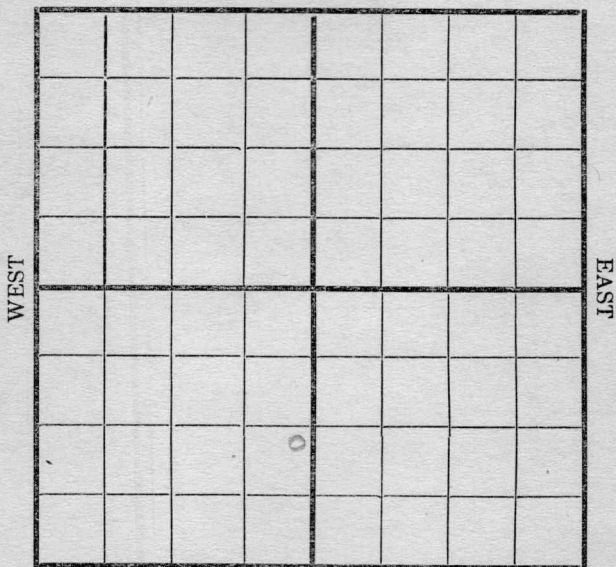

SOUTH

Location _____
 Rig Up _____
 Drilling and remarks

2165'

RECORD

Cased _____ in. _____ Ft.
 Sand _____
 Gas _____
 Oil _____
 Total Depth _____

PRODUCTION


1st 24 hrs. Nat. _____
 1st 24 hrs. after shot _____
 Gas _____ Cu. Ft.
 Dry Hole _____
 Abandoned _____

Date

2/5, 1917 Cordiff Scout

Map No. _____ Sec. 3 Twp. 28 R. 4
Well No. 1 Home Farm
Empire Company

NORTH

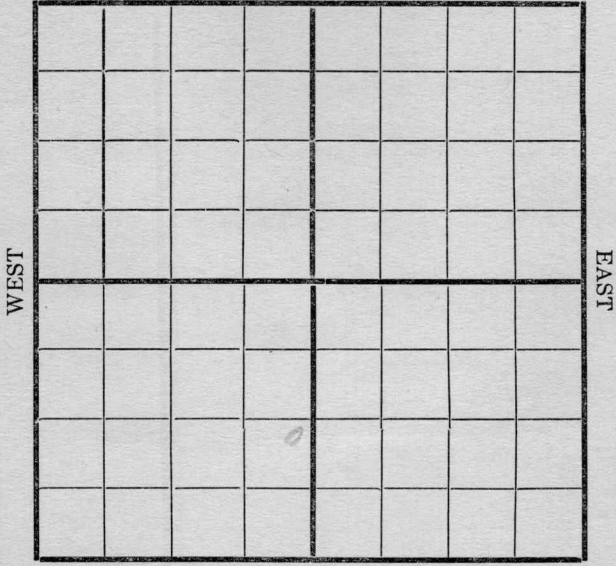

SOUTH

Location _____ Rig Up _____ Drilling and remarks <u>2335</u>	RECORD
	Cased _____ in. _____ Ft.
	Sand _____
	Gas _____
	Oil _____
	Total Depth _____
	PRODUCTION
	1st 24 hrs. Nat. _____
	1st 24 hrs. after shot _____
	Gas _____ Cu. Ft.
	Dry Hole _____
	Abandoned _____


Date 2/12, 1917 Carly Scout

Map No. _____ Sec. 3 Twp. 28 R. 4
 Well No. 1 Home Farm _____
Empire Company _____

NORTH

WEST

EAST

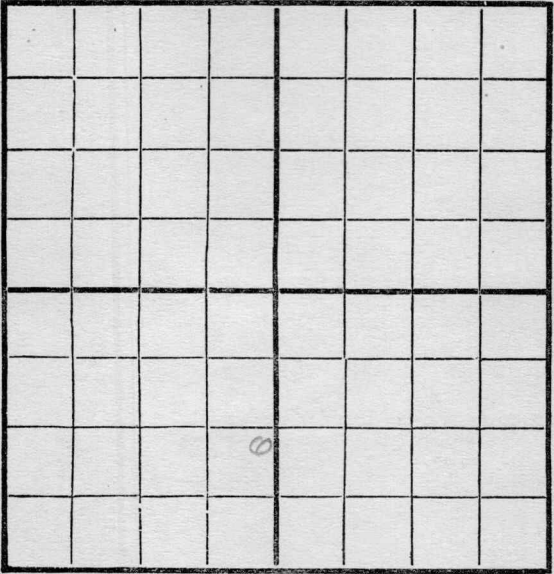

SOUTH

Location _____
 Rig Up _____
 Drilling and remarks _____

RECORD

Cased _____ in. _____ Ft.
 Sand _____
 Gas _____
 Oil _____
 Total Depth _____

PRODUCTION

1st 24 hrs. Nat. _____
 First 24 hrs. after shot _____
 Gas _____ Cu. Ft.
 Dry Hole _____
 Abandoned _____


Date

2/19, 1917 Cordell Scout

Map No. _____ Sec. 3 Twp. 28 R. 4
 Well No. 1 Home Farm _____
Amprise Company _____

NORTH

WEST

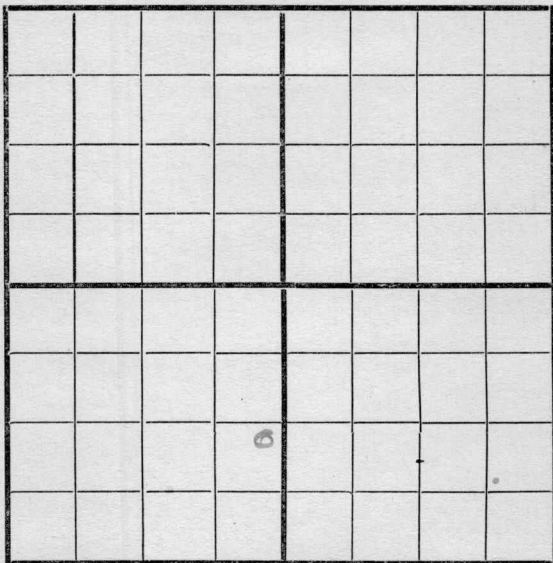

EAST

SOUTH

Location _____

Rig Up _____

Drilling and remarks

Shut Down
2480'

RECORD

Cased _____ in. _____ Ft.

Sand _____

Gas _____

Oil _____

Total Depth _____

PRODUCTION

1st 24 hrs. Nat. _____

1st 24 hrs. after shot _____

Gas _____ Cu. Ft.

Dry Hole _____

Abandoned _____

Date


2/26 1912 Cordery Scout

Map No. _____ Sec. 3 Twp. 28 R. 4Well No. 1 Haines Farm
Empire Company

NORTH

WEST

EAST

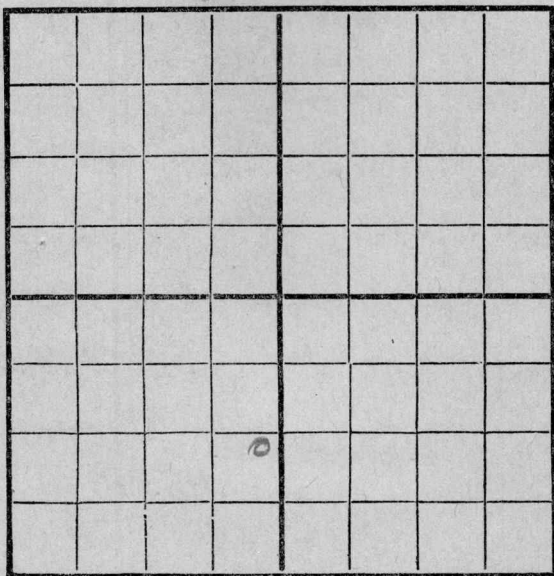

SOUTH

REMARKS:

Sand 2470
 2480
 2502
 small showing. Sand
 broken and not much
 pit. Drilling 2670

Date

3/5, 1917

Candy Scout

Map No. _____ Sec. 3 Twp. 28 R. 4Well No. 1 Haines Farm _____

_____ Company _____

NORTH

WEST

EAST

SOUTH

Location _____

Rig Up _____

Drilling and remarks

*Dry and
Plugged.
2684*

RECORD

Cased _____ in. _____ Ft.

Sand _____

Gas _____

Oil _____

Total Depth _____

PRODUCTION

1st 24 hrs. Nat. _____

1st 24 hrs. after shot _____

Gas _____ Cu. Ft.

Dry Hole _____

Abandoned _____

Date

3/12, 191 *2* _____ Scout

MAP NO. K11 KANSAS SEC. 3 TWP. 58S R. 4E

WELL NO. 1 Haines
Empire COMPANY

CONTRACTOR

SECTION PLAT

ABANDONED

_____ FT. FROM N. LINE
_____ FT. FROM S. LINE
_____ FT. FROM E. LINE
_____ FT. FROM W. LINE

LOCATION _____

RIG UP _____

DRILLING AND REMARKS:

RECORD

CASED _____ IN. _____ FT.
SAND _____
GAS _____
OIL _____
TOTAL DEPTH 2681

PRODUCTION

1ST 24 HRS. NAT. _____
1ST 24 HRS. AFTER SHOT _____
GAS _____ CU. FT.
DRY HOLE ☒
ABANDONED ☒

DATE

3-14 1917 SCOUT