


Map No. _____ Sec. 3 Twp. 28 R. 4Well No. 4 Myers (Myers) FarmMid Kansas Company

NORTH

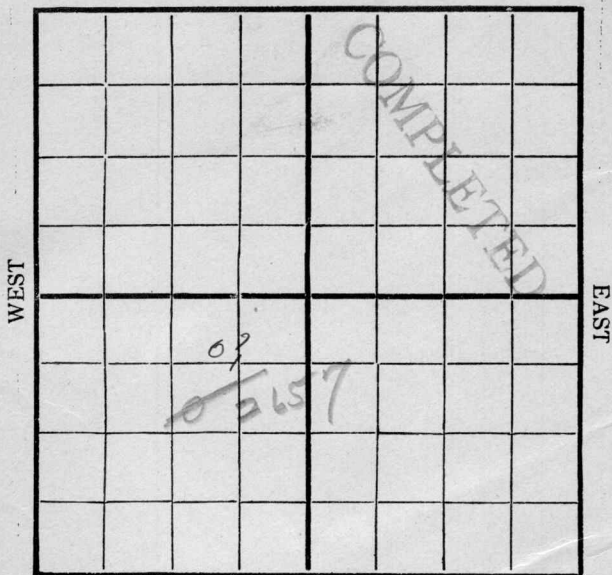

SOUTH

Location _____

Rig Up _____

Drilling Remarks:

Drilling Remarks:

RECORD

Cased _____ in _____ Ft.

Sand _____

Gas _____

Oil _____

Total Depth _____

PRODUCTION

1st 24 hrs. Nat. _____

1st 24 hrs. after shot _____

Gas _____ Cu. Ft.

Dry Hole _____


Abandoned _____

Map No. _____ Sec. 3 Twp. 28 R. 4Well No. 4 Myers Farm
Bendheim & Trees Company

NORTH

WEST

EAST

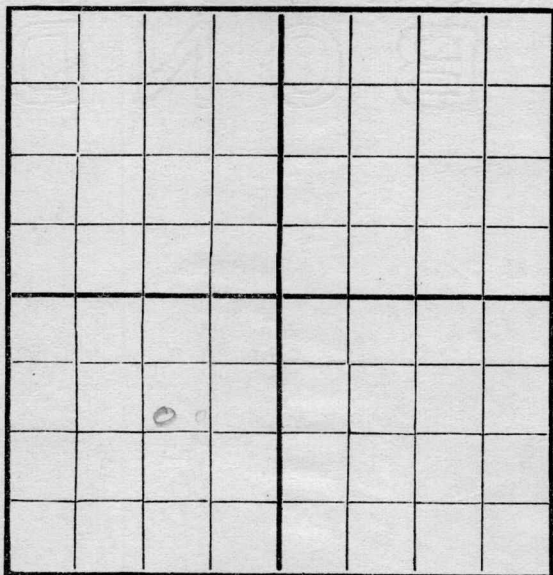

SOUTH

 Location _____
 Rig Up ☒ _____
 Drilling and remarks _____

RECORD

 Cased _____ in. _____ Ft.
 Sand _____
 Gas _____
 Oil _____
 Total Depth _____

PRODUCTION

 1st 24 hrs. Nat. _____
 1st 24 hrs. after shot _____
 Gas _____ Cu. Ft. .
 Dry Hole _____
 Abandoned _____


Date

5/22, 1916, Leandiff Scout

Map No. _____ Sec. 3 Twp. 28 R. 4Well No. 4 Meyer Farm _____Mid Kansas Company _____

NORTH

WEST

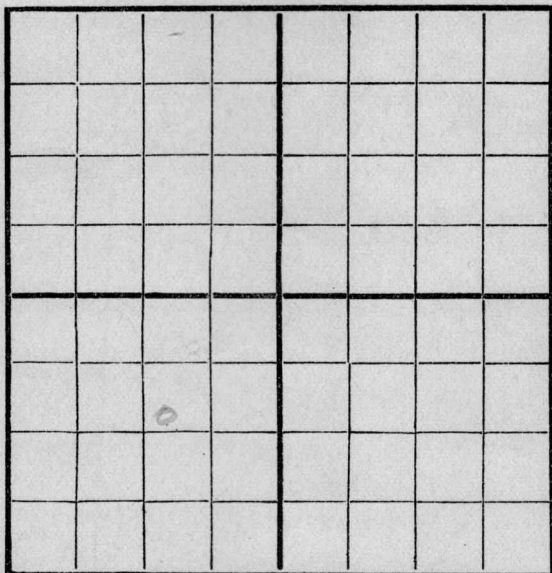

EAST

SOUTH

Location _____

Rig Up _____

Drilling and remarks _____

400'

RECORD

Cased _____ in. _____ Ft.

Sand _____

Gas _____

Oil _____

Total Depth _____

PRODUCTION

1st 24 hrs. Nat. _____

1st 24 hrs. after shot _____

Gas _____ Cu. Ft.

Dry Hole _____

Abandoned _____


Date _____

6/8, 1916 Scout

Map No. _____ Sec. 3 Twp. 28 R. 4Well No. 4 Myers Farm _____Mid Kansas Company _____

NORTH

WEST

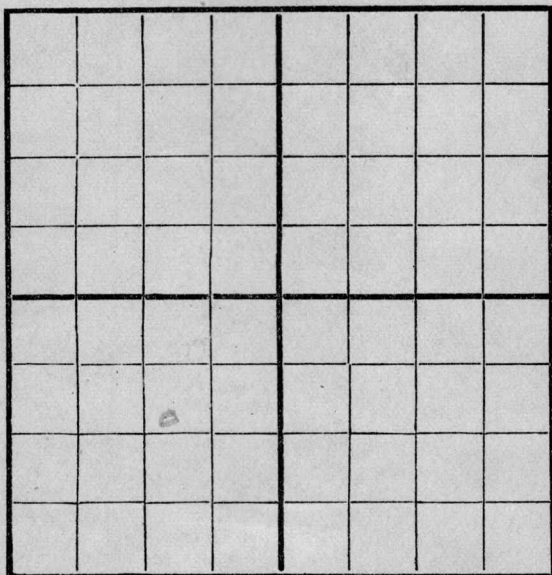

EAST

SOUTH

Location _____

Rig Up _____

Drilling and remarks

650'

RECORD

Cased _____ in. _____ Ft.

Sand _____

Gas _____

Oil _____

Total Depth _____

PRODUCTION

1st 24 hrs. Nat. _____

1st 24 hrs. after shot _____

Gas _____ Cu. Ft.

Dry Hole _____

Abandoned _____

Date

4/13, 1916 SPC 07/ Scout

Map No. _____ Sec. 3 Twp. 28 R. 4
Well No. 4 Meyer Farm _____
Midway Company _____

NORTH

WEST

EAST

SOUTH

Location _____

Rig Up_____

Drilling and remarks

RECORD

Cased _____ in. _____ Ft.

Sand

Gas _____

Oil _____

Total Depth _____

PRODUCTION

1st 24 hrs. Nat.

1st 24 hrs. after shot_____

Gas _____ Cu. Ft.

Dry Hole _____


Abandoned -----

Date _____

191 Scout

Map No. _____ Sec. 3 Twp. 28 R. 4
 Well No. 4 Myers Farm _____
Mid Kansas Company _____

NORTH

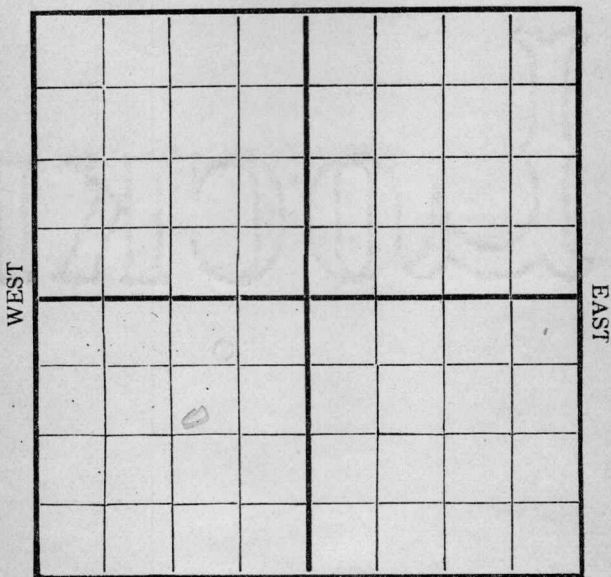

SOUTH

Location _____

Rig Up _____

Drilling and remarks _____

2125'

RECORD

Cased _____ in. _____ Ft.

Sand _____

Gas _____

Oil _____

Total Depth _____

PRODUCTION

1st 24 hrs. Nat. _____

1st 24 hrs. after shot _____

Gas _____ Cu. Ft.

Dry Hole _____

Abandoned _____


Date

6/30, 1916 Lee J. J. Scout

Map No. _____ Sec. 3 Twp. 28 R. 4
 Well No. 4 Myers Farm _____
Mid Kansas Company _____

NORTH

WEST

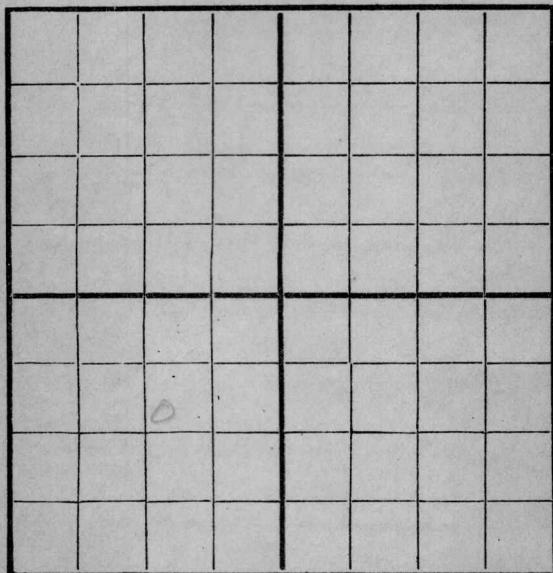

EAST

SOUTH

Location _____

Rig Up _____

Drilling and remarks

2350'

RECORD

Cased _____ in. _____ Ft.

Sand _____

Gas _____

Oil _____

Total Depth _____

PRODUCTION

1st 24 hrs. Nat. _____

1st 24 hrs. after shot _____

Gas _____ Cu. Ft.

Dry Hole _____

Abandoned _____

Date


7/8, 1916 W. A. B. Co. Scout

Map No. _____ Sec. 3 Twp. 28. R. 4
 Well No. 4 _____ Farm _____
Mid-Kansas Company

NORTH

WEST

EAST

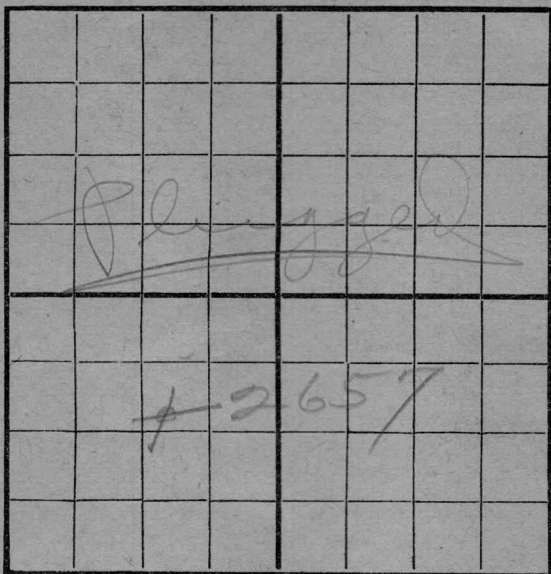

SOUTH

Location _____
 Rig Up _____
 Drilling and remarks _____

RECORD

Cased _____ in. _____ Ft.
 Sand _____
 Gas _____
 Oil _____
 Total Depth _____

PRODUCTION

1st 24 hrs. Nat. _____
 1st 24 hrs. after shot _____
 Gas _____ Cu. Ft.
 Dry Hole _____
 Abandoned _____

Date

7/17, 1916 L. L. Co. Inc. Scout

MAP NO. K11 KANSAS SEC. 3 TWP. 28S R. 1E

WELL NO. 4 Myers

COMPANY _____

CONTRACTOR _____

SECTION PLAT

ABANDONED

_____ FT. FROM N. LINE
 _____ FT. FROM S. LINE
 _____ FT. FROM E. LINE
 _____ FT. FROM W. LINE

RECORD

LOCATION _____

CASED _____ IN. _____ FT.

RIG UP _____

SAND _____

DRILLING AND REMARKS:

GAS _____

OIL _____

TOTAL DEPTH 7637

PRODUCTION

1ST 24 HRS. NAT. _____

1ST 24 HRS. AFTER SHOT _____

GAS _____ CU. FT.

DRY HOLE /

ABANDONED _____

DATE

_____ 192 _____ SCOUT