


Map No. _____ Sec. 3 Twp. 28 R. 4
 Well No. 2 J R Myers Farm _____
Mid-Kansas (Myers) Company

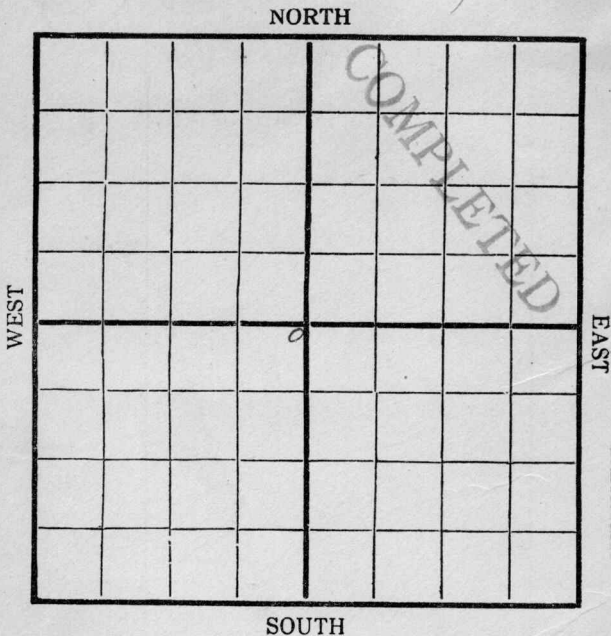

Location _____

Rig Up _____

Drilling Remarks:

Drilling Remarks:

3/30 2540
3/28 2990 -
4/5 2615 No showing


RECORD

PRODUCTION

Cased _____ in. _____ Ft.
 Sand _____
 Gas _____
 Oil _____
 Total Depth _____

1st 24 hrs. Nat. _____
 1st 24 hrs. after shot _____
 Gas _____ Cu. Ft.
 Dry Hole _____
 Abandoned _____

Map No. _____ Sec. 3 Twp. 28 R. 4
 Well No. 3 J R Fryer Farm _____
Budding & Trees Company _____

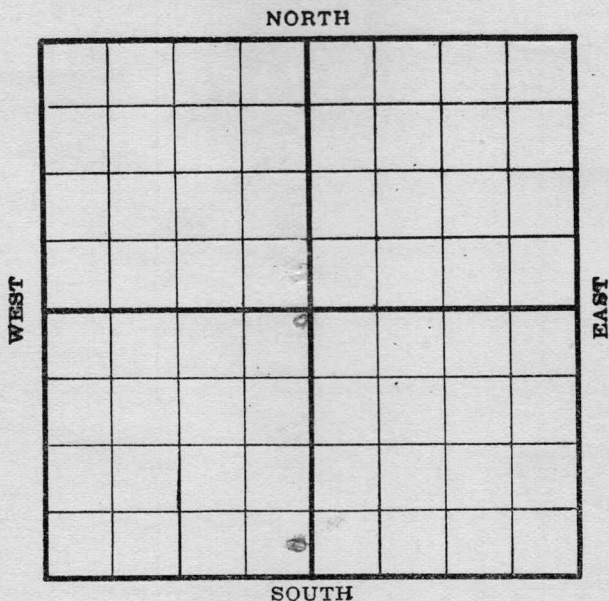

Location _____

Rig up _____

Drilling and remarks

1400 fr

RECORD

Cased _____ in. _____ Ft.

Sand _____

Gas _____

Oil _____

Total Depth _____

PRODUCTION

1st 24 hrs. Nat. _____

1st 24 hrs. after shot _____

Gas _____ Cu. Ft.

Dry Hole _____

Abandoned _____


Date

3/30, 1916, Kirkland Scout

Map No. _____ Sec. 3 Twp. 28 R. 4Well No. 2 J R Myers FarmBenedum & Sons Company

NORTH

WEST

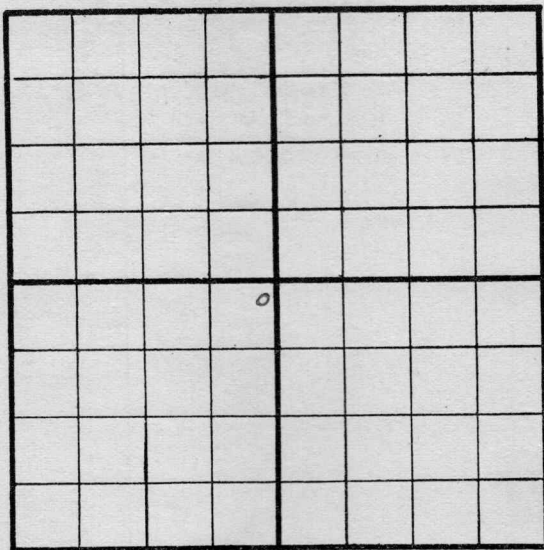

EAST

SOUTH

Location _____

Rig up _____

Drilling and remarks

2561 ft.
expect to drill
in to night or
in morning

RECORD

Cased _____ in. _____ Ft.

Sand _____

Gas _____

Oil _____

Total Depth _____

PRODUCTION

1st 24 hrs. Nat. _____

1st 24 hrs. after shot _____

Gas _____ Cu. Ft.

Dry Hole _____

Abandoned _____

Date

4/3


1916

Keweenaw Scout

Map No. _____ Sec. 3 Twp. 28 R. 4Well No. 2 J R Myers Farm _____Breadum & Trees Company _____

NORTH

WEST

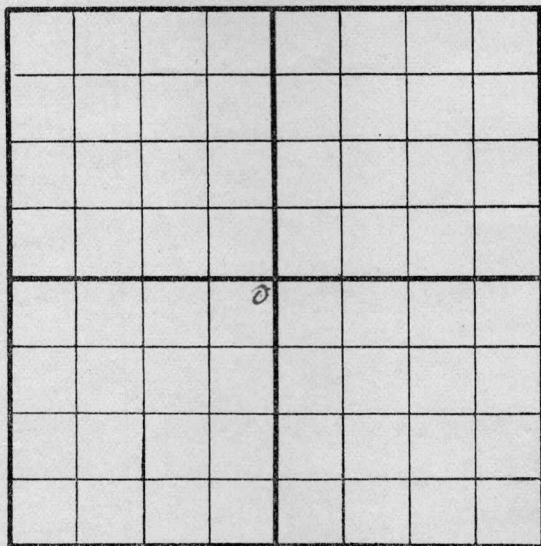

EAST

SOUTH

Location _____

Rig up _____

Drilling and remarks

2590 ft ~~77~~
Below where
sand was found
in #1

RECORD

Cased _____ in. _____ Ft.

Sand _____

Gas _____

Oil _____

Total Depth _____

PRODUCTION

1st 24 hrs. Nat. _____

1st 24 hrs. after shot _____

Gas _____ Cu. Ft.


Dry Hole _____

Abandoned _____

Date

4/4, 1916, Keckand Scout

Map No. _____ Sec. 3 Twp. 28 R. 4
 Well No. 2 GR Myers Farm _____
Benedum Bros Company

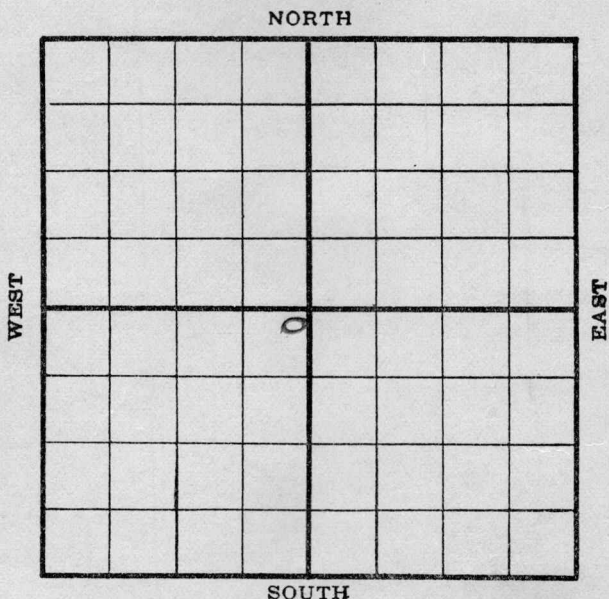

Location _____

Rig up _____

Drilling and remarks

2615 ft
No showing
missed sand

RECORD

Cased _____ in. _____ Ft.

Sand _____

Gas _____

Oil _____

Total Depth _____

PRODUCTION

1st 24 hrs. Nat. _____

1st 24 hrs. after shot _____

Gas _____ Cu. Ft.

Dry Hole _____

Abandoned _____

Date

4/5, 1916, Keweenaw Scout

K11 KANSAS SEC. 3 TWP. 28S R. 16
MAP NO.

WELL No. 2 Myers

Ohio Oil COMPANY

CONTRACTOR

SECTION PLAT

ABANDONED

_____ FT. FROM N. LINE

_____ FT. FROM S. LINE

_____ FT. FROM E. LINE

_____ FT. FROM W. LINE

LOCATION _____

RIG UP _____

DRILLING AND REMARKS:

RECORD

CASED _____ IN. _____ FT.

SAND _____

GAS _____

OIL _____

TOTAL DEPTH 2655

PRODUCTION

1ST 24 HRS. NAT. _____

1ST 24 HRS. AFTER SHOT _____

GAS _____ Cu. Ft.

DRY HOLE _____

ABANDONED _____

DATE

_____ 192 _____ SCOUT