


Map No. _____ Sec. 3 Twp. 28 R. 4Well No. 2 Beck. _____ Farm_____ Cooden _____ Company

NORTH

WEST

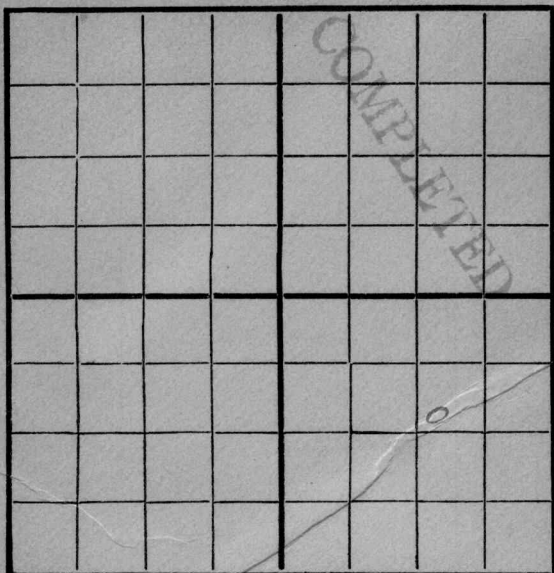

EAST

SOUTH

Location _____

Drilling Remarks

10/9 = Spudding.
 10/17 = 840
 10/24 = 14100
 11/9 = Collar paid cap.
 11/14 = 506
 11/27 = 2170
 12/4 = 2425
 12/14 = 2607

Rig Up 10/21/16

Drilling Remarks

RECORD

Cased _____ in. _____ Ft.

Sand _____

Gas _____

Oil _____

Total Depth _____

PRODUCTION

1st 24 hrs. Nat. _____

1st 24 hrs. after shot _____


Gas _____ Cu. Ft.

Dry Hole _____

Abandoned _____

Map No. _____ Sec. 3 Twp. 28 R. 4
 Well No. 2 Beek Farm _____
Coastline Company _____

NORTH

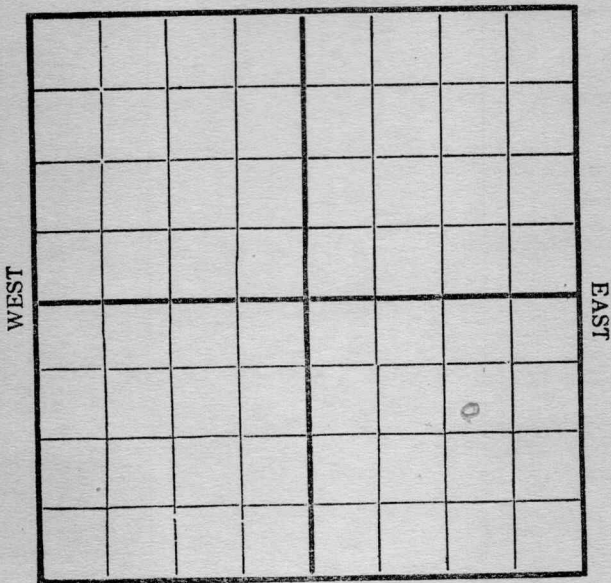

SOUTH

Location ✓
 Rig Up ✓
 Drilling and remarks _____

RECORD

Cased _____ in. _____ Ft.
 Sand _____
 Gas _____
 Oil _____
 Total Depth _____

PRODUCTION


1st 24 hrs. Nat. _____
 First 24 hrs. after shot _____
 Gas _____ Cu. Ft.
 Dry Hole _____
 Abandoned _____

Date

9/25-6 191 6 Coastline Scout _____

Map No. _____ Sec. 3 Twp. 28 R. 4
 Well No. 2 Beck Farm _____
Cosden Company _____

NORTH

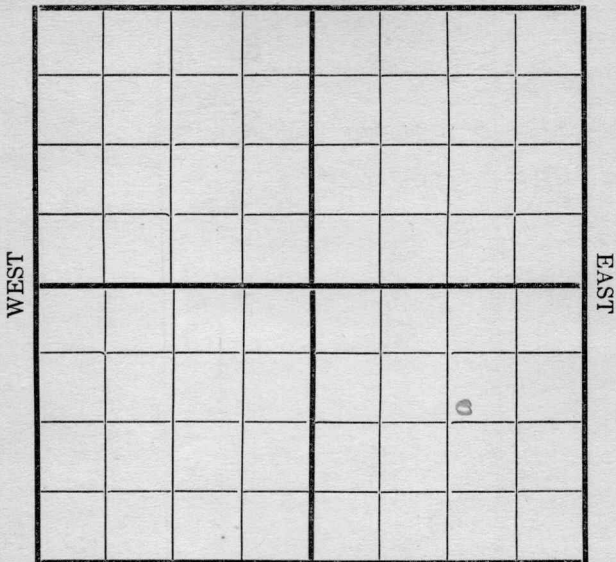

SOUTH

Location _____
 Rig Up ✓ _____
 Drilling and remarks _____

RECORD

Cased _____ in. _____ Ft.
 Sand _____
 Gas _____
 Oil _____
 Total Depth _____

PRODUCTION

1st 24 hrs. Nat. _____
 1st 24 hrs. after shot _____
 Gas _____ Cu. Ft.
 Dry Hole _____
 Abandoned _____

Date

10/2, 1916 Beck Scout

Map No. _____ Sec. 3 Twp. 28 R. 4Well No. 2 Beck Farm _____

_____ Company

NORTH

WEST

EAST

SOUTH

Location _____

Rig Up _____

Drilling and remarks

Spindling

RECORD

Cased _____ in. _____ Ft.

Sand _____

Gas _____

Oil _____

Total Depth _____

PRODUCTION

1st 24 hrs. Nat. _____

First 24 hrs. after shot _____

Gas _____ Cu. Ft.

Dry Hole _____


Abandoned _____

Date

4/9, 191 *6* *Scout*

Map No. _____ Sec. 3 Twp. 28 R. 4
 Well No. 2 Beck Farm _____
Cosby Company _____

NORTH

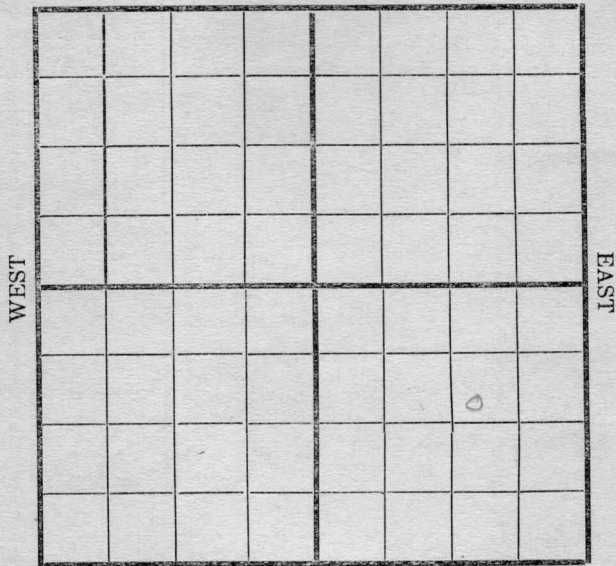


SOUTH

Location _____ Rig Up _____ Drilling and remarks <u>840</u>	RECORD
	Cased _____ in. _____ Ft.
	Sand _____
	Gas _____
	Oil _____
	Total Depth _____
	PRODUCTION
	1st 24 hrs. Nat. _____
	1st 24 hrs. after shot _____
	Gas _____ Cu. Ft.
	Dry Hole _____
	Abandoned _____

Date 10/17, 1916 6 H. C. C. J. Scout _____

Map No. _____ Sec. 3 Twp. 28 R. 4
 Well No. 2 Beck Farm _____
Cosden Company _____

NORTH

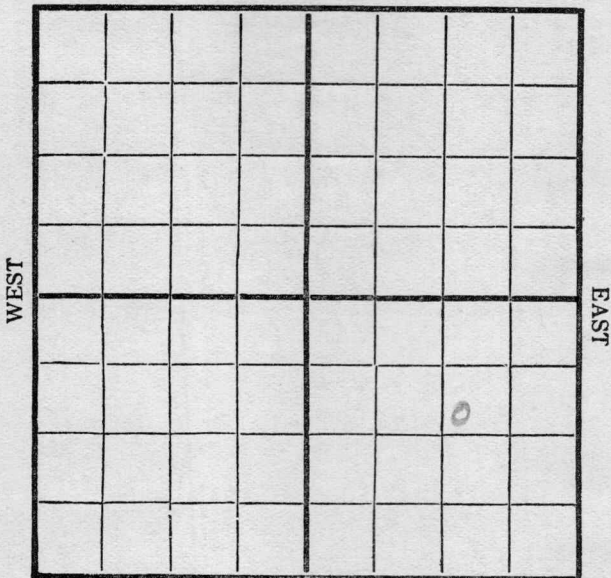

SOUTH

Location _____
 Rig Up _____
 Drilling and remarks

RECORD

Cased _____ in. _____ Ft.
 Sand _____
 Gas _____
 Oil _____
 Total Depth _____

PRODUCTION

1st 24 hrs. Nat. _____
 First 24 h.s. after shot _____
 Gas _____ Cu. Ft.
 Dry Hole _____
 Abandoned _____

Date


10/24/1916 Scout L. C. Carey

Map No. _____ Sec. 3 Twp. 28 R. 4
 Well No. Beck Farm _____
Cooker Company _____

NORTH

WEST

EAST

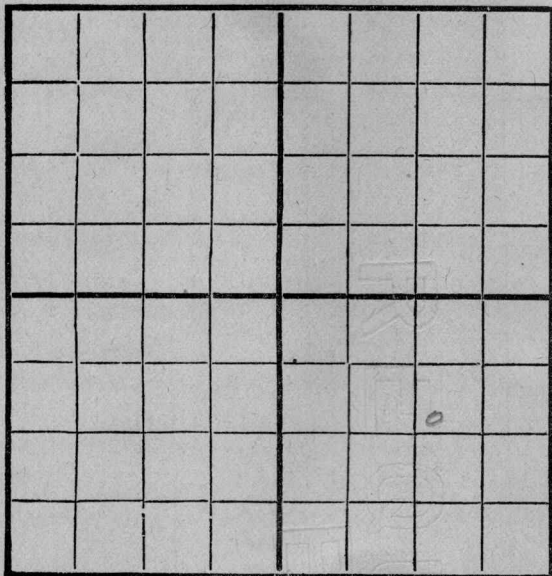

SOUTH

Location _____

Rig Up _____

Drilling and remarks

1400'
Casing Collapsed

RECORD

Cased _____ in. _____ Ft.

Sand _____

Gas _____

Oil _____

Total Depth _____

PRODUCTION

1st 24 hrs. Nat. _____

First 24 h. s. after shot _____

Gas _____ Cu. Ft.

Dry Hole _____

Abandoned _____


Date

10/30, 1916 Scout

Map No. _____ Sec. 3 Twp. 28 R. 4
 Well No. 2 B. C. C. Farm _____
C. C. C. Company _____

NORTH

WEST

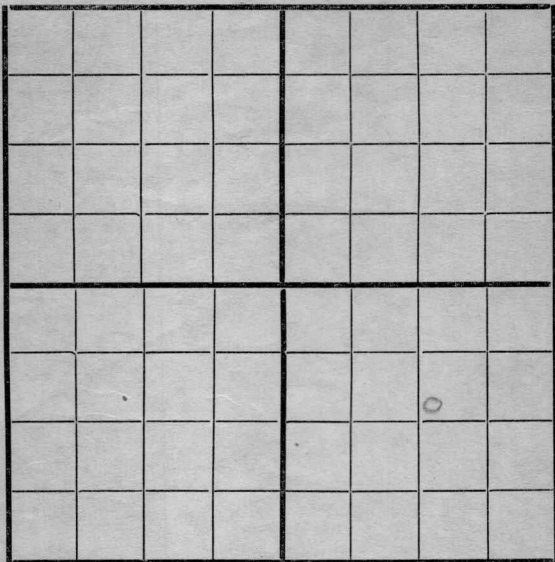

EAST

SOUTH

Location _____
 Rig Up _____
 Drilling and remarks _____

RECORD

Cased _____ in. _____ Ft.
 Sand _____
 Gas _____
 Oil _____
 Total Depth _____

PRODUCTION

1st 24 hrs. Nat. _____
 1st 24 hrs. after shot _____
 Gas _____ Cu. Ft.
 Dry Hole _____
 Abandoned _____


Collapsed
1400'
 Please state
 depth on each
 ticket.

Date

11/9, 1916 C. C. C. Scout

Map No. _____ Sec. 3 Twp. 28 R. 4
 Well No. 2136 Farm _____
Condon Company _____

NORTH

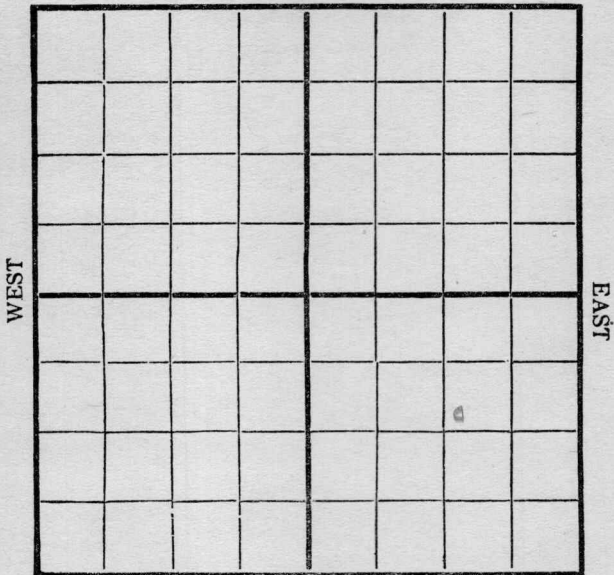

SOUTH

Location _____

Rig Up _____

Drilling and remarks

1570

RECORD

Cased _____ in. _____ Ft.

Sand _____

Gas _____

Oil _____

Total Depth _____

PRODUCTION

1st 24 hrs. Nat. _____

First 24 hrs. after shot _____

Gas _____ Cu. Ft.

Dry Hole _____

Abandoned _____


Date

11/14, 1916

Condon Scout

Map No. _____ Sec. 3 Twp. 28 R. 4
 Well No. 2 Beck Farm _____
Corden Company _____

NORTH

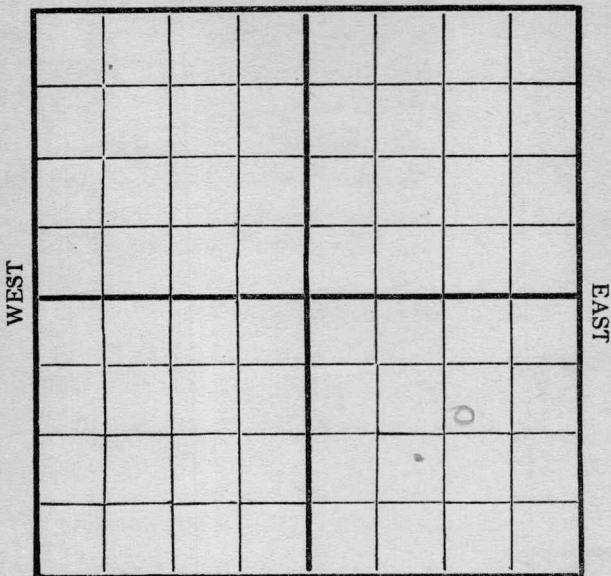

SOUTH

Location _____
 Rig Up _____
 Drilling and remarks

RECORD

Cased _____ in. _____ Ft.
 Sand _____
 Gas _____
 Oil _____
 Total Depth _____

PRODUCTION

1st 24 hrs. Nat. _____
 1st 24 hrs. after shot _____
 Gas _____ Cu. Ft.
 Dry Hole _____
 Abandoned _____

Date

11/20, 1916 Corden Scout

Map No. _____ Sec. 3 Twp. 28 R. 4Well No. 2 Beck _____ Farm _____Cooder _____ Company _____

NORTH

WEST

EAST

SOUTH

Location _____

Rig Up _____

Drilling and remarks

21.70'

RECORD

Cased _____ in. _____ Ft.

Sand _____

Gas _____

Oil _____

Total Depth _____

PRODUCTION

1st 24 hrs. Nat. _____

1st 24 hrs. after shot _____

Gas _____ Cu. Ft.

Dry Hole _____

Abandoned _____


Date

11/27, 1916. Cooder Scout

Map No. _____ Sec. 3 Twp. 28 R. 4
 Well No. 2 Beck Farm _____
Cosden Company _____

NORTH

WEST

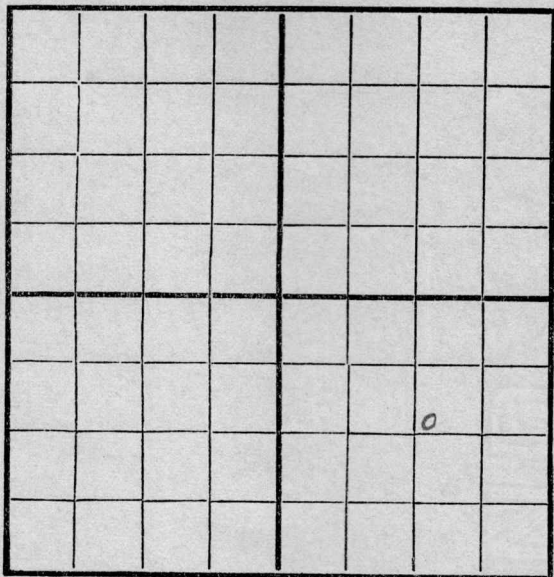

EAST

SOUTH

Location _____
 Rig Up _____
 Drilling and remarks _____

2425

RECORD

Cased _____ in. _____ Ft.
 Sand _____
 Gas _____
 Oil _____
 Total Depth _____

PRODUCTION

1st 24 hrs. Nat. _____
 1st 24 hrs. after shot _____
 Gas _____ Cu. Ft.
 Dry Hole _____
 Abandoned _____


Date

12/4, 191 6, Cosden Scout

Map No. _____ Sec. 3 Twp. 28 R. 4Well No. 2 Beck Farm _____
Cooden Company _____

NORTH

WEST

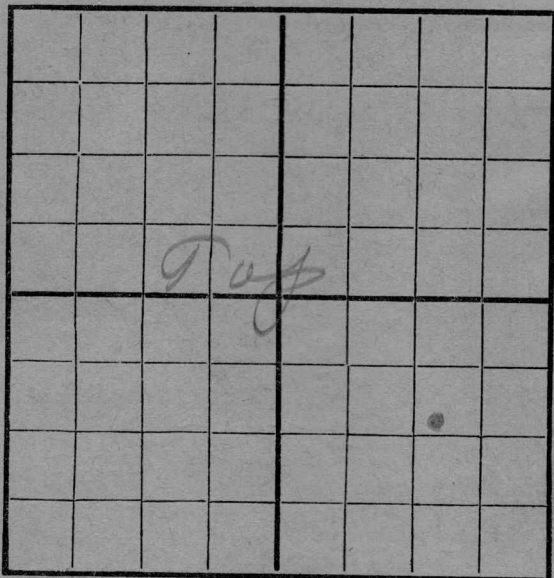

EAST

SOUTH

RECORD

Location _____

Cased _____ in. _____ Ft.

Rig Up _____

Sand 2607'-7"

Drilling and remarks

Gas _____

Oil _____

Total Depth _____

PRODUCTION

1st 24 hrs. Nat. _____

1st 24 hrs. after shot _____

Gas _____ Cu. Ft.

Dry Hole _____

Abandoned _____


Date

12/14, 1916, Cooden Scout

Map No. _____ Sec. 3 Twp. 38 R. 4Well No. 2 Beck Farm _____Cooper Company _____

NORTH

WEST

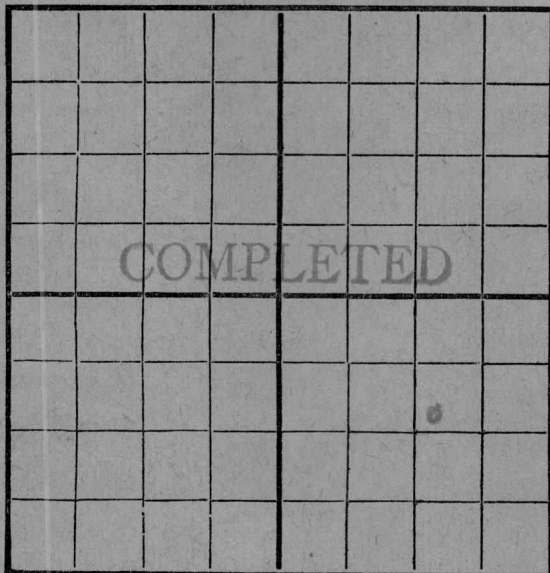

EAST

SOUTH

Location _____

Rig Up _____

Drilling and remarks

Estimated
2.50 Bbls

RECORD

Cased _____ in. _____ Ft.

Sand 2603-2619

Gas _____

Oil _____

Total Depth _____

PRODUCTION

1st 24 hrs. Nat. _____

1st 24 hrs. after shot _____

Gas _____ Cu. Ft.

Dry Hole _____


Abandoned _____

Date

12/18, 1916 Cooper Scout

Map No. _____ Sec. 3 Twp. 28 R. 4
 Well No. J. L. Beck Farm _____
C. O. & G. Co. Company _____

NORTH

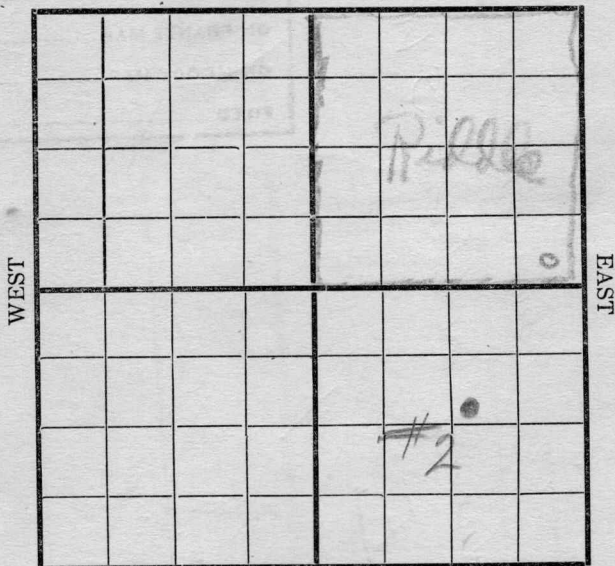

SOUTH

Location _____
 Rig Up _____
 Drilling and remarks _____

RECORD

Cased _____ in. _____ Ft.
 Sand _____
 Gas _____
 Oil _____
 Total Depth _____

PRODUCTION

1st 24 hrs. Nat. _____
 1st 24 hrs. after shot _____
 Gas _____ Cu. Ft.
 Dry Hole _____
 Abandoned _____

Date

_____, 191____. _____ Scout

No. 2 is shown on tracing as
a producing well in SW & NE
of S.E. 1/4

RECEIVED
Treasurer's Office
JUN 5 - 1911

Base sheet

RETURNED BY	_____
ON TRACING	Moyn
ON J. S. C. MAP	_____
ON FRANTZ MAP	_____
ON MOODY MAP	_____
FILED	_____