

KANSAS


FORM 51 5M 6-46 PETROL

Greenwood County

Section 14 Township 24 Range 12E

Well No. #16 Sullivan

Company Huston Okla. Oil

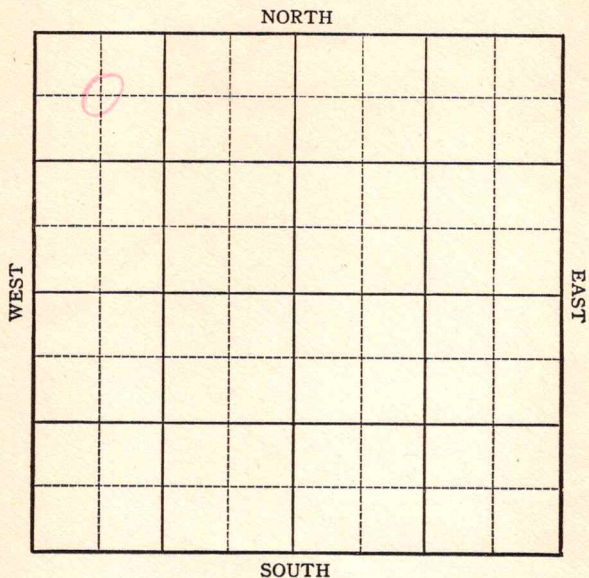

KANSAS

Greenwood County

Sec. 14 Twp. 24 R. 12E

Well No. #16 Sullivan Farm

Huston Okla. Oil Company

Virgil


700 Ft. from N. Line

Ft. from S. Line

Ft. from E. Line

650 Ft. from W. Line

C NW NW

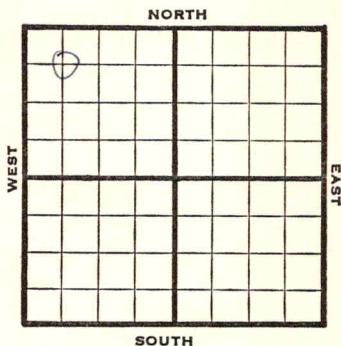

1946

REPORT

7/24 Machine.
7/30 400 Run 10"
8/6 10" @ 400'
Drlg 975'
8/13 8" @ 1133
Miss 1730'
6" @ 1630
Drlg 1745'
8/20 TD 1771
6" @ 1730
2000 acid
8/27 Miss 1730'
6" @ 1730'
TD 1771
2000 Acid
Pump 40 Pot
38 GRAV.

COMPLETED

KANSAS

Kansas Pool Name VirgilMap No. 16 Sec. 14 Twp. 24 R. 12EWell No. 16 SullivanHuston Okla. Oil

Company

FIRST REPORT

Contractor

C NW NW

SECTION PLAT

0			

700 Ft. from N. Line

Ft. from S. Line

Ft. from E. Line

650 Ft. from W. LineGreenwood County

Location

Rig up

Drilling and Remarks:

Machine

RECORD

Cased in., ft.

Sand

Gas

Oil

Total Depth

PRODUCTION

1st 24 hrs. Nat. 1st 24 hrs. after shot Gas Cu. Ft.Dry Hole Abandoned

Date

JUL 24 1946

19

S. J. LEWIS

Scout

KANSAS

Kansas

Pool Name Virgil PoolMap No. 16 Sec. 14 Twp. 24 R. 12EWell No. 16 Sullivan

Huston Okla. Oil

Company

COMPLETED

Contractor

C NW NW

SECTION PLAT

700	Ft. from N. Line				
	Ft. from S. Line				
	Ft. from E. Line				
650	Ft. from W. Line				

Greenwood County

Location

Rig up

Drilling and Remarks:

Miss 1730
6" @ 1730
2000 acid
Pump 40 B

382 lb

RECORD

Cased _____ in., _____ ft.

Sand _____

Gas _____

Oil _____

Total Depth 1771

PRODUCTION

1st 24 hrs. Nat. _____

1st 24 hrs. after shot _____

Gas _____ Cu. Ft.

Dry Hole _____

Abandoned _____

Date

AUG 28 1946 19

S. J. LEWIS

Scout