

WEST

EAST

Abandoned.....

Map No. Sec. Twp. R.

Well No. Farm


..... Company

.....Ft. from N. Line

.....Ft. from S. Line

.....Ft. from E. Line

.....Ft. from W. Line

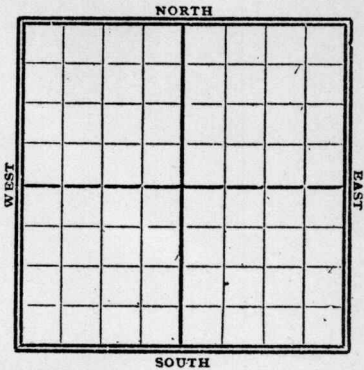

1916

Date

REPORT

Gypsy Records

2/15

Abd T.D. 2640'

MAP NO. K11 KANSAS SEC. 4 TWP. 28S R. 1E

WELL NO. 1 C. D. Horner

Infy Hor & COMPANY

CONTRACTOR

SECTION PLAT

ABANDONED

_____ FT. FROM N. LINE

_____ FT. FROM S. LINE

_____ FT. FROM E. LINE

_____ FT. FROM W. LINE

6			

RECORD

LOCATION _____

CASED _____ IN. _____ FT.

RIG UP _____

SAND _____

DRILLING AND REMARKS:

GAS _____

OIL _____

TOTAL DEPTH 7640

PRODUCTION

1ST 24 HRS. NAT. _____

1ST 24 HRS. AFTER SHOT _____

GAS _____ CU. FT.

DRY HOLE ☒

ABANDONED ☒

DATE

4-15 1924 SCOUT