


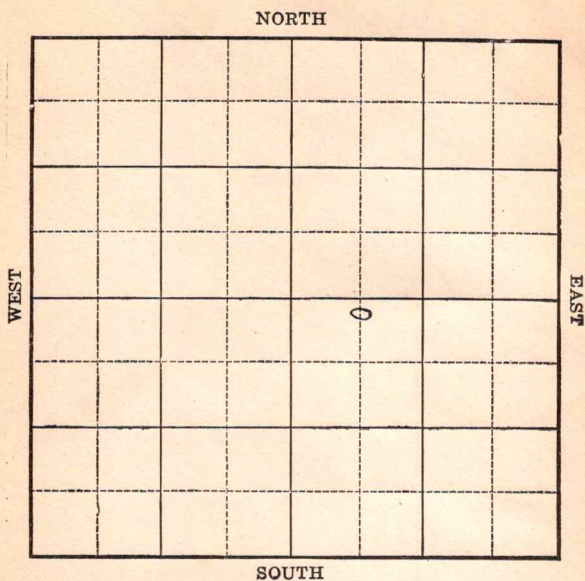

Drilling Remarks:

Drilling Remarks:

Cased _____ in. _____ ft.

Sand _____

Gas _____

Oil _____

Total Depth_____

1st 24 hrs Nat. _____

1st 24 hrs. after shot_____

Gas _____ cu. ft.

Dry Hole _____

Abandoned _____

Map No. _____ Sec. 11 Twp. 24 R. 12


Well No. 8 Dalton Farm
Ruth Oil Company

200 Ft. from N. Line

_____ Ft. from S. Line

Ft. from E. Line

760 Ft. from W. Line

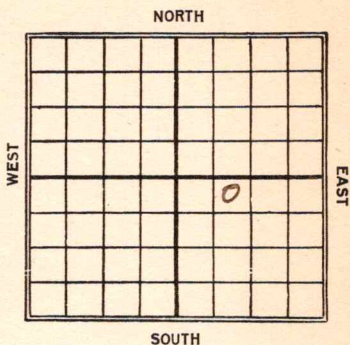

Date 1923

REPORT

4/7	Spud.
6/10	Gophers 1697 - Bay 1744 - 64 - shot 1000 ft. Truss.

Map No. **KANSAS** ¹⁶ Sec. ¹¹ Twp. ²⁴ R. ¹²Well No. *8 Dalton**Ruth oil* Company

Contractor

FIRST REPORT

SECTION PLAT

200 Ft. from N. Line

Ft. from S. Line

Ft. from E. Line

760 Ft. from W. Line

		○	

Location

Rig up

Drilling and Remarks:

Spud.

RECORD

Cased _____ in., _____ ft.

Sand _____

Gas _____

Oil _____

Total Depth _____

PRODUCTION

1st 24 hrs. Nat. _____

1st 24 hrs. after shot _____

Gas _____ Cu. Ft.

Dry Hole _____

Abandoned _____

Date

APR 7 1923

M. A. BENEAR

_____ 192_____

_____ Scout

Map No. ~~1152~~ 16 Sec. 11 Twp. 24 R. 12

Well No. 8 - Heaton

Ruth oil - Company

Contractor

COMPLETED SECTION PLAT

200 Ft. from N. Line

Ft. from S. Line

Ft. from E. Line

760 Ft. from W. Line

		o	

Location

Rig up

Drilling and Remarks:

Tap Line 1697
 Pay { 1744
 1764
 100/7 lbs.

RECORD

Cased _____ in., _____ ft.

Sand _____

Gas _____

Oil _____

Total Depth _____

PRODUCTION

1st 24 hrs. Nat. _____

1st 24 hrs. after shot _____

Gas _____ Cu. Ft.

Dry Hole _____

Abandoned _____

Date JUN 10 1923

M. A. BENEAR

192

Scou