

KANSAS

Butler

Section 5 Township 28 Range 4E

Well No. 1 Kemper


Company Penguin et al

Wildcat

NORTH

WEST

EAST

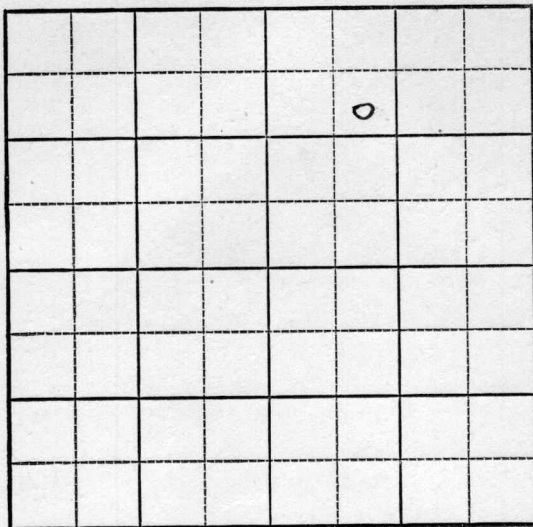

SOUTH

Sec. 5 Twp. 28 R. 4-E ✓

Well No. #1 Kemper Farm

Penguin etal.

Company

Wildcat

990

Ft. from N. Line


Ft. from S. Line

Ft. from E. Line

990

Ft. from W. Line

SE NW NE

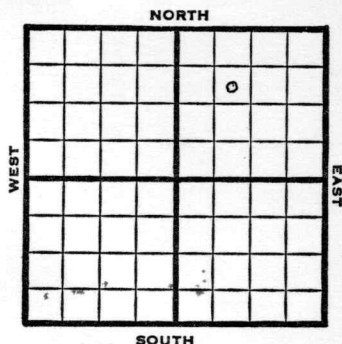

1949

Lev 1241' REPORT


1/26	Location
2/2	Spud
2/9	"
2/16	"
2/23	"
3/2	"
3/8	"
3/16	"
3/23	15" @ 80'
	rlg 510'
3/30	13" @ 730'
	Drlg. 1215'
4/6	Topeka 1500'
	Drlg. 1650'
4/12	KC 2140'
	TD 2277'
	7" @ 2277'
4/20	Miss 2614'
	Drlg. 2640'
4/27	TD 2896'
	Arb. 2876'
	Aband.

ABANDONED

Kansas

Map No. _____ Sec. 5 Twp. 28 R. 4EWell No. 1 KemperPenguin et al. Company**FIRST REPORT** Contractor

SE NW NE

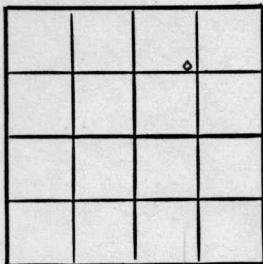SECTION PLAT990 Ft. from N. Line Ft. from S. Line Ft. from E. Line990 Ft. from W. LineButler CountyLocation XRig up

Drilling and Remarks:


RECORDCased in., ft.Sand Gas Oil Total Depth **PRODUCTION**1st 24 hrs. Nat. 1st 24 hrs. after shot Gas Cu. Ft.Dry Hole Abandoned

Date

JAN 26 1949 19S. J. LEWIS Scout

Map No. K11 Sec. 5 Twp. 28 R. 4EWell No. 1 KemperPenguin et al. CompanyABANDONEE Contractor

SE NW NE

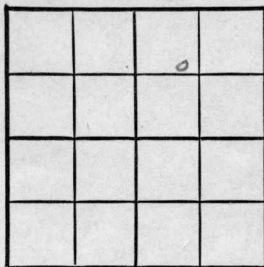E 1/2 41
SECTION PLAT990 Ft. from N. Line Ft. from S. Line Ft. from E. Line990 Ft. from W. Line

Butler County

Location Rig up Drilling and Remarks:
CE 2576

RECORD

Cased in., ft.Sand Gas Oil Total Depth 2896

PRODUCTION

1st 24 hrs. Nat. 1st 24 hrs. after shot Gas Cu. Ft.Dry Hole Abandoned

Date

APR 27 1949

19

S. J. LEWIS

Scout