


KANSAS Butler

Section 3 Township 28 Range 4E

Well No. #1 Riddle

Company H & M Drlg.
Miscellaneous

NORTH

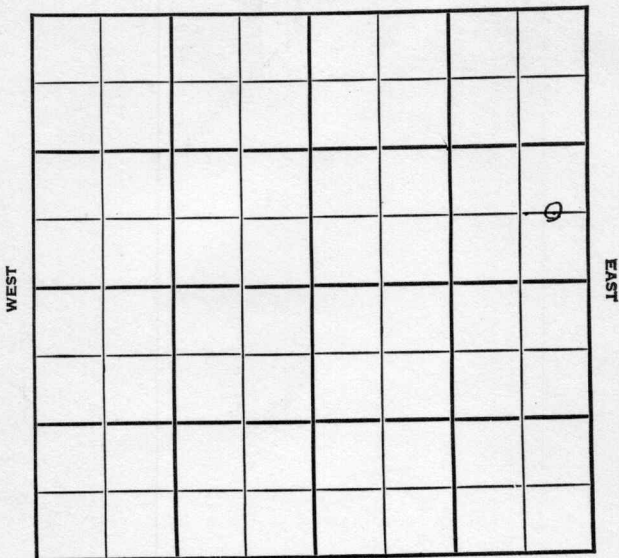

SOUTH

Sec. 3 Twp. 28 R. 4E

Well No. #1 Riddle Farm

H. & M. Drlg. Company

Misc.


Ft. from N. Line

660 Ft. from S. Line

330 Ft. from E. Line

Ft. from W. Line

C EL SE NE

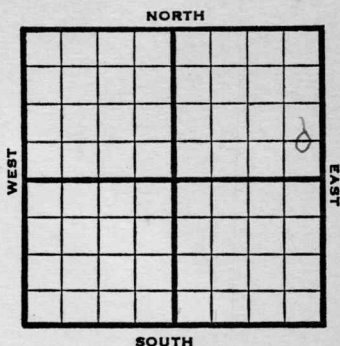

1948

Elev. 1271'

REPORT

All wells plugged.

4/14

Machine

4/21

"

4/28

Drlg. 810'

5/5

10" @ 760'

Drlg. 990'

5/12

8" @ 1508'

Lansing 1729'

Drlg. 1850'

5/19

KC 2040'

7" @ 2550'

Sand 2566'

Drlg. 2572'

6/1

Simp. 2598'

5" @ 2560'

Pump 30 oil & 6 W Pot.

Gr. 420

TD 2617'

COMPLETED

Map No. _____ Sec. 3 Twp. 28 R. 4E

Well No. 1 Riddle

H & M Drlg. Company

FIRST REPORT Contractor

C E L S E N E

SECTION PLAT

_____ Ft. from N. Line

660 Ft. from S. Line

330 Ft. from E. Line

_____ Ft. from W. Line

			6

Butler County

Location _____

Rig up _____

Drilling and Remarks:

Machine

All wells plugged

RECORD

Cased _____ in., _____ ft.

Sand _____

Gas _____

Oil _____

Total Depth _____

PRODUCTION

1st 24 hrs. Nat. _____

1st 24 hrs. after shot _____

Gas _____ Cu. Ft.

Dry Hole _____

Abandoned _____

Date

APR 14 1948 19 S. J. LEWIS Scout

Map No. 11 Sec. 3 Twp. 28 R. 4E

Well No. 1 Riddle

H. & M. Drlg. Company

COMPLETE

Contractor

C E L S E N E

E1, 1271

SECTION PLAT

			0

 Ft. from N. Line

660 Ft. from S. Line

330 Ft. from E. Line

 Ft. from W. Line

Butler County

Location

Rig up

Drilling and Remarks:

*Surf 2598.
5" C 2560*

*Pump 800 ft + 6 W
B&T*

42 2/3

RECORD

Cased in., ft.

Sand

Gas

Oil

Total Depth 2617

PRODUCTION

1st 24 hrs. Nat.

1st 24 hrs. after shot

Gas Cu. Ft.

Dry Hole

Abandoned

Date

JUN 1 1948 19 S. J. LEWIS Scout