


Section 14 Township 24 Range 12E
Well No. #18 Sullivan
Company Houston Oil

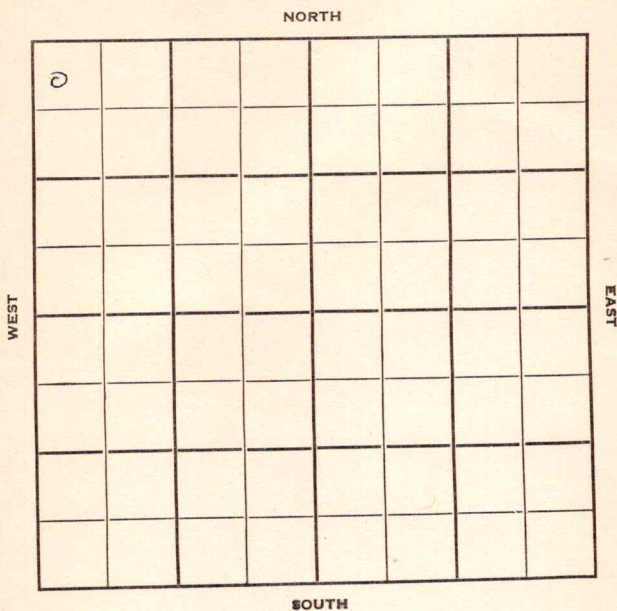

Greenwood

KANSAS

Sec. 14 Twp. 24 R. 12E

Well No. #18 Sullivan Farm

Houston Oil Company

Virgil Pool Contractor


330' Ft. from N. Line

_____ Ft. from S. Line

_____ Ft. from E. Line

200' Ft. from W. Line

NW NW NW

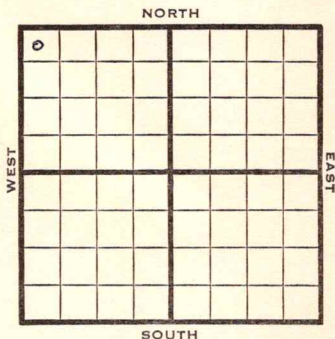

1950

REPORT

4/19

Spud 2-18-50
Miss Chat 1739'
Miss Lime 1741
SO 1751-56
Fill up 70' oil in 8 hrs.
Broken Sd 1759-65
6" @ 1741'
Acid 2000
Comp. 25 BOPD
TD 1765'

FIRST REPORT
&
COMPLETED

Map No. _____ Sec. 14 Twp. 24 R. 12EWell No. 18 Sullivan_____
Houston Oil _____ Company_____
Contractor

NW NW NW

SECTION PLAT

330 _____ Ft. from N. Line

_____ Ft. from S. Line

_____ Ft. from E. Line

200 _____ Ft. from W. Line

Greenwood County

Location _____

Rig up _____

Drilling and Remarks:

Spud 2-18-50

Miss. chat 1739

Miss. lime 1741

SO 1751-56

Fill up 70' oil in
8 hrs.Broken sd. 1759-65
6" @ 1741

RECORD

Cased _____ in., _____ ft.

Sand _____

Gas _____

Oil _____

Total Depth 1765

PRODUCTION

1st 24 hrs. Nat. _____

1st 24 hrs. after shot _____

Gas _____ Cu. Ft.

Dry Hole _____

Abandoned _____

2000 acid

Date Comp. 25 bopd

APR 19 1950 19

J. E. TYRA

Scout