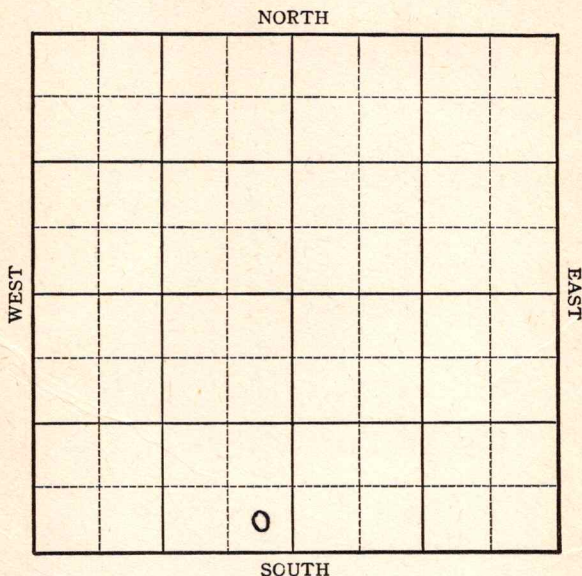


Section 14 Township 24 Range 12EWell No. #20 D.J. SullivanCompany Mid-Continent Petroleum Corp

Sec. 14 Twp. 24-S R. 12-E

Well No. #20 D. J. Sullivan Farm

Mid-Continent Petr. Corp. Company


Virgil

Ft. from N. Line

330 Ft. from S. Line

330 Ft. from E. Line

Ft. from W. Line

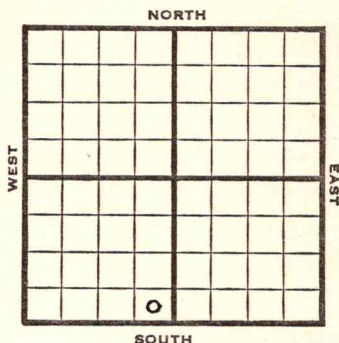

SE SE SW

1946

REPORT

3/26	Location notice only.	
5/9	Drilling 1630'	(Tel)
5/8	Location by ticket	
5/11	Miss. 1745'	
	7" set 1749'	
	Total Depth 1750'	
	Waiting on tools.	"
5/13	Waiting on drilling in machine.	(P.R)
5/14	" " "	"
5/15	" " "	"
5/16	Waiting on tools.	(Tel)
5/20	Waiting on cement.	(P.R)
5/21	" "	"
5/22	Waiting on drilling in machine.	"
5/23	Moving in tools. 1750'	"
5/24	Bailing mud	"
5/27	Small show oil. Will acidize with 2000 gallons.	"
5/28	Will acidize.	"
5/29	Acidizing 1775'	"
5/31	Acidized with 2000 gallons.	
	Pumped 3 days. Did not recover load.	
6/3	Pulling tubing & rods to test for disposal well.	"
6/4	" " " "	"

OVER

1946

6/5	Will drill few feet deeper & convert to input well. 1775'	(P.R)
6/6	Waiting for motor to deepen.	"
6/7	" " "	"
6/10	" " "	"
6/11	" " "	"
6/12	" " "	"
6/13	" " "	"
6/14	" " "	"
6/17	Motor installed -ready to drill ahead	"
6/18	Drilling 1779'	"
6/19	Drilling 1784' very hard.	"
6/20	Completed 6-19-46 Water disposal well.	"
	T.D. 1738'	
6/26	Miss. 1745 7" @ 1749 TD 1788' SWD	

ABANDONED

Kansas Pool Name Virgil**KANSAS**Map No. _____ Sec. 14 Twp. 24 R. 12EWell No. #20 D. J. SullivanMid-Continent Petroleum Corp. CompanyFIRST REPORT

Contractor

SE SW

SECTION PLAT

_____ Ft. from N. Line

330 Ft. from S. Line330 Ft. from E. Line

_____ Ft. from W. Line

Greenwood County

Location _____

Rig up _____

Drilling and Remarks:

RECORD

Cased _____ in., _____ ft.

Sand _____

Gas _____

Oil _____

Total Depth _____

PRODUCTION

1st 24 hrs. Nat. _____

1st 24 hrs. after shot _____

Gas _____ Cu. Ft.

Dry Hole _____

Abandoned _____

Date

MAY 8 1946 19S. J. LEWIS Scout

KANSAS

Kansas

Pool Name Virgil PoolMap No. 16 Sec. 14 Twp. 24 R. 12EWell No. 20 D. J. SullivanMid-Continent Petroleum

Company

ABANDONED

Contractor

SE SW

SECTION PLAT

_____ Ft. from N. Line

330 Ft. from S. Line330 Ft. from E. Line

_____ Ft. from W. Line

Greenwood County

Location _____

Rig up _____

Drilling and Remarks:

Miss 17457" @ 1749SW 25

RECORD

Cased _____ in., _____ ft.

Sand _____

Gas _____

Oil _____

Total Depth 1788

PRODUCTION

1st 24 hrs. Nat. _____

1st 24 hrs. after shot _____

Gas _____ Cu. Ft.

Dry Hole _____

Abandoned _____

Date

JUN 26 1946 19S. J. LEWIS

Scout