


Map No. _____ Sec. 11 Twp. 24 R. 12
 Well No. 9 Walton Farm _____
Larch Company _____

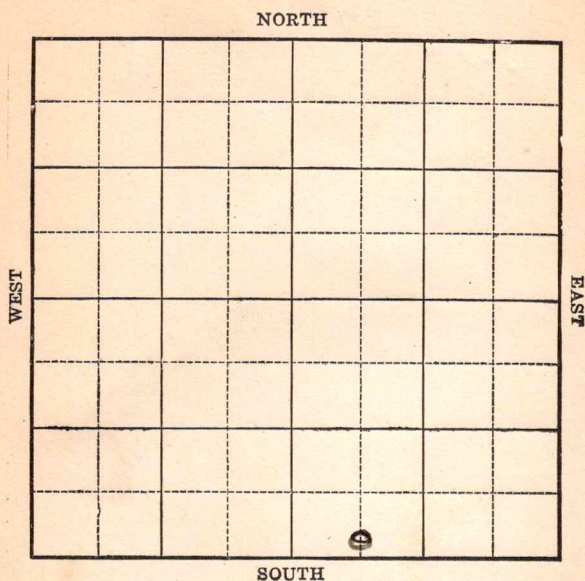

Location _____

Rig up _____

Drilling Remarks:

Drilling Remarks:

RECORD

PRODUCTION

Cased _____ in. _____ ft.

1st 24 hrs Nat. _____

Sand _____

1st 24 hrs. after shot _____

Gas _____

Gas _____ cu. ft.

Oil _____

Dry Hole _____

Total Depth _____


Abandoned _____

Map No. _____ Sec. 11 Twp. 24 R. 12Well No. 9 Dalton Farm _____
Louch Company _____

_____ Ft. from N. Line

200 Ft. from S. Line

_____ Ft. from E. Line

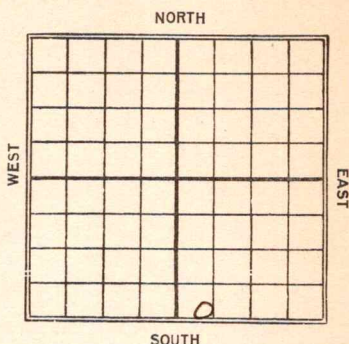648 Ft. from W. Line

Date

REPORT

19234/206/10Spud.20 p line 1701. Pay
1725-62. shot 80 gts.
150 lbs. 1st. 24 hrs. I.D.
1766'

Map No. **KANSAS** ¹⁶ Sec. **11** Twp. **24** R. **13**

Well No. **9 - 20 Alton**

Larch

Company

Contractor

FIRST REPORT

SECTION PLAT

Ft. from N. Line

200 Ft. from S. Line

Ft. from E. Line

648 Ft. from W. Line

Location

Rig up

Drilling and Remarks:

Spud

RECORD

Cased _____ in., _____ ft.

Sand _____

Gas _____

Oil _____

Total Depth _____

PRODUCTION

1st 24 hrs. Nat. _____

1st 24 hrs. after shot _____

Gas _____ Cu. Ft.

Dry Hole _____

Abandoned _____

Date

APR 20 1923

191

Scout

Map No. 11346 16 Sec. 11 Twp. 24 R. 12Well No. 9 WaltonLauck Int Company

Contractor

COMPLETED SECTION PLAT
COMPLETED

Ft. from N. Line

200 Ft. from S. Line

Ft. from E. Line

648 Ft. from W. Line

		0	

Location

Rig up

Drilling and Remarks:

Tap Line 1701Pay { 1725
176220.1766'70/15. 1st 24 hrs**RECORD**

Cased _____ in., _____ ft.

Sand _____

Gas _____

Oil _____

Total Depth _____

PRODUCTION

1st 24 hrs. Nat. _____

1st 24 hrs. after shot _____

Gas _____ Cu. Ft.

Dry Hole _____

Abandoned _____

Date

JUN 10 1923

192

M. A. BENEAR

Scout