


Map No. _____ Sec 7 Twp. 28 R. 4
 Well No. 1 Morris Farm _____
Hoyt Oil Co Company _____

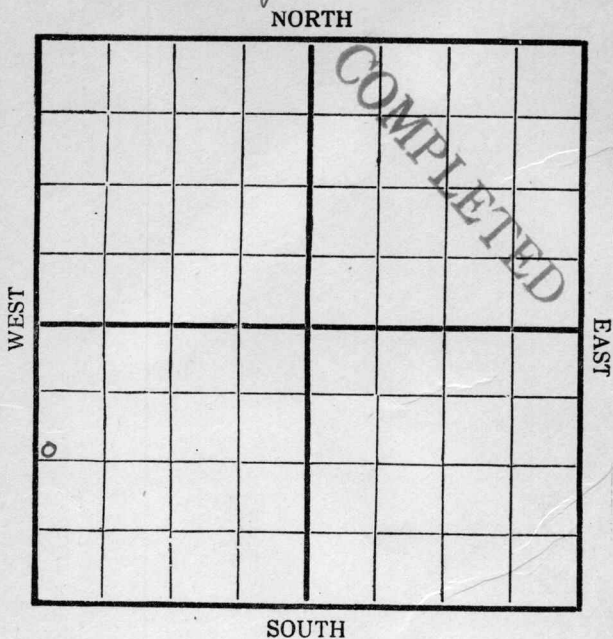

Location _____

Rig Up 4/1 _____

Drilling Remarks:

Drilling Remarks:

5/1 - 250 ft
7/26 Plugged
260 ft

RECORD

PRODUCTION


Cased _____ in _____ Ft.
 Sand _____
 Gas _____
 Oil _____
 Total Depth _____

1st 24 hrs. Nat. _____
 1st 24 hrs. after shot _____
 Gas _____ Cu. Ft.
 Dry Hole _____
 Abandoned _____

Map No. _____ Sec. 7 Twp. 28 R. 4Well No. I Morris Farm _____Hoyt & Co. Company _____

NORTH

WEST

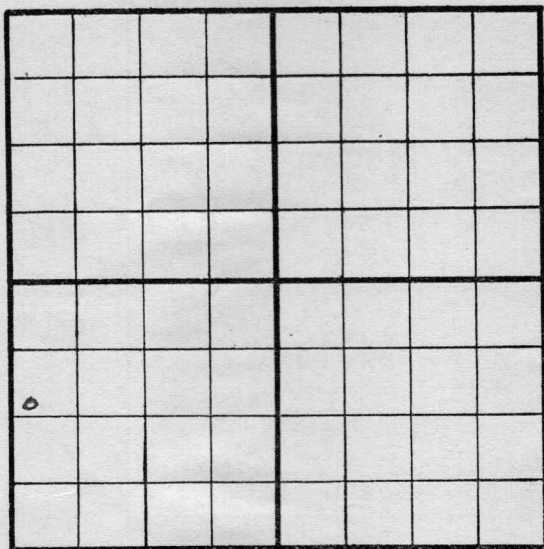

EAST

SOUTH

Location _____

Rig up _____

Drilling and remarks _____

RECORD

Cased _____ in. _____ Ft.

Sand _____

Gas _____

Oil _____

Total Depth _____

PRODUCTION

1st 24 hrs. Nat. _____

1st 24 hrs. after shot _____

Gas _____ Cu. Ft.

Dry Hole _____

Abandoned _____

Date


4/1, 1916, Kirkland Scout

Map No. _____ Sec. 7 Twp. 28 R. 4Well No. 1 W. S. Morris Farm _____Hoyt et al Company _____

NORTH

WEST

EAST

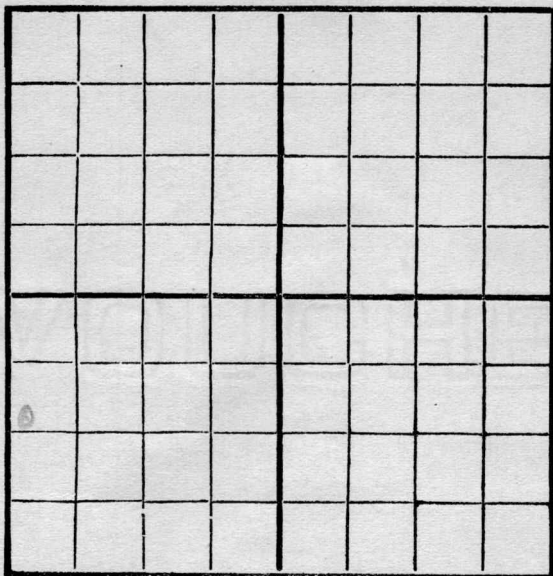

SOUTH

Location _____

Rig Up _____

Drilling and remarks

250 ft

RECORD

Cased _____ in. _____ Ft.

Sand _____

Gas _____

Oil _____

Total Depth _____

PRODUCTION

1st 24 hrs. Nat. _____

1st 24 hrs. after shot _____

Gas _____ Cu. Ft.

Dry Hole _____

Abandoned _____

Date

May, 1916 L. P. Morris Scout


Map No. _____ Sec. 7 Twp. 28 R. 4Well No. 1 Morris Farm _____

_____ Company _____

NORTH

WEST

EAST

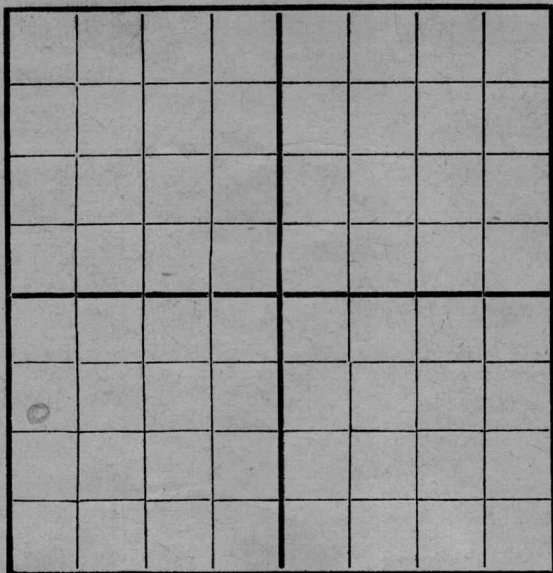

SOUTH

Location _____

Rig Up _____

Drilling and remarks

2350'

RECORD

Cased _____ in. _____ Ft.

Sand _____

Gas _____

Oil _____

Total Depth _____

PRODUCTION

1st 24 hrs. Nat. _____

1st 24 hrs. after shot _____

Gas _____ Cu. Ft.

Dry Hole _____

Abandoned _____


Date

6/13, 1916. L.C. Boyd Scout

Map No. _____ Sec. 7 Twp. 28 R. 4Well No. 1 Morris- Farm _____Huyt et al Company _____

NORTH

WEST

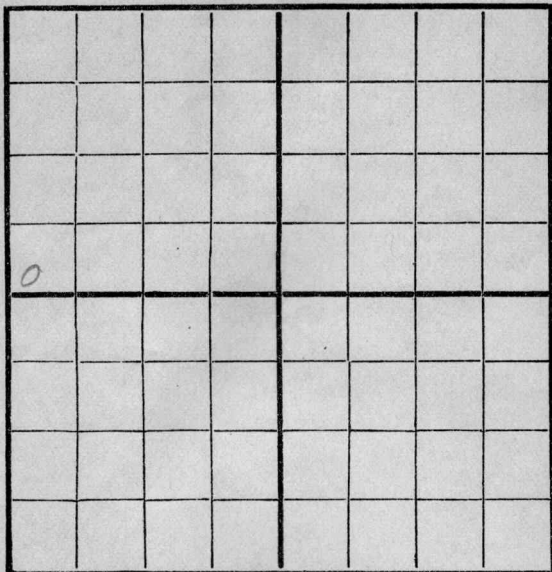

EAST

SOUTH

Location _____

Rig Up _____

Drilling and remarks

2330Slight Shiver

RECORD

Cased _____ in. _____ Ft.

Sand _____

Gas _____

Oil _____

Total Depth _____

PRODUCTION

1st 24 hrs. Nat. _____

1st 24 hrs. after shot _____

Gas _____ Cu. Ft.

Dry Hole _____

Abandoned _____

Date

6/17,1916Scout


Scout

Map No. _____ Sec. 7 Twp. 28 R 4
 Well No. 1 Morris Farm _____
Dayt et al Company _____

NORTH

WEST

EAST

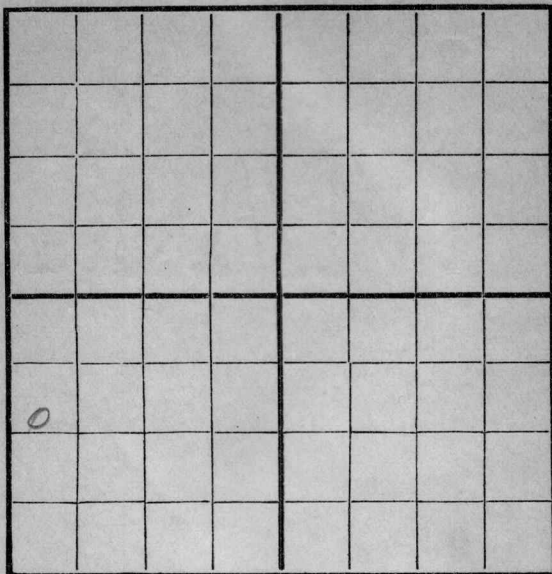

SOUTH

Location _____

Rig Up _____

Drilling and remarks _____

2590 Coming

RECORD

Cased _____ in. _____ Ft.

Sand _____

Gas _____

Oil _____

Total Depth _____

PRODUCTION

1st 24 hrs. Nat. _____

1st 24 hrs. after shot _____

Gas _____ Cu. Ft.


Dry Hole _____

Abandoned _____

Date

7/24, 1916 Scout

Map No. _____ Sec. 7 Twp. 28 R. 4
 Well No. 1 Morris Farm _____
Haystack Company _____
 NORTH

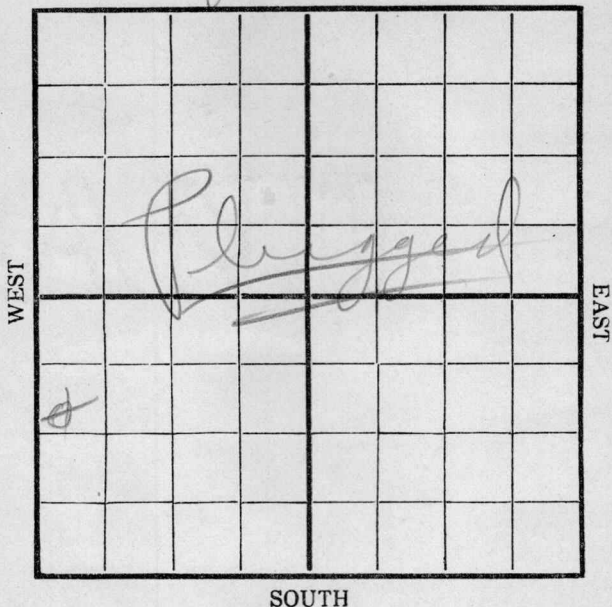

SOUTH

Location _____
 Rig Up _____
 Drilling and remarks _____

Plugged at
2601'

RECORD

Cased _____ in. _____ Ft.
 Sand _____
 Gas _____
 Oil _____
 Total Depth _____

PRODUCTION

1st 24 hrs. Nat. _____
 1st 24 hrs. after shot _____
 Gas _____ Cu. Ft.
 Dry Hole _____
 Abandoned _____

Date

7/26, 1916 LCCordis Scout

K11 **KANSAS** SEC. 7 TWP. 28S 4E

WELL NO. 1 Morris

Hoyt et al COMPANY

CONTRACTOR

SECTION PLAT

ABANDONED

_____ FT. FROM N. LINE

_____ FT. FROM S. LINE

_____ FT. FROM E. LINE

_____ FT. FROM W. LINE

RECORD

LOCATION _____

CASED _____ IN. _____ FT.

RIG UP _____

SAND _____

DRILLING AND REMARKS:

GAS _____

OIL _____

TOTAL DEPTH 7601

PRODUCTION

1ST 24 HRS. NAT. _____

1ST 24 HRS. AFTER SHOT _____

GAS _____ CU. FT.

DRY HOLE ☒

ABANDONED ☒

DATE

8/16 1924 SCOUT