


Map No. _____ Sec. 8 Twp. 28 R. ✓Well No. 1 Church Lot Farm _____

Company _____

NORTH

WEST

EAST

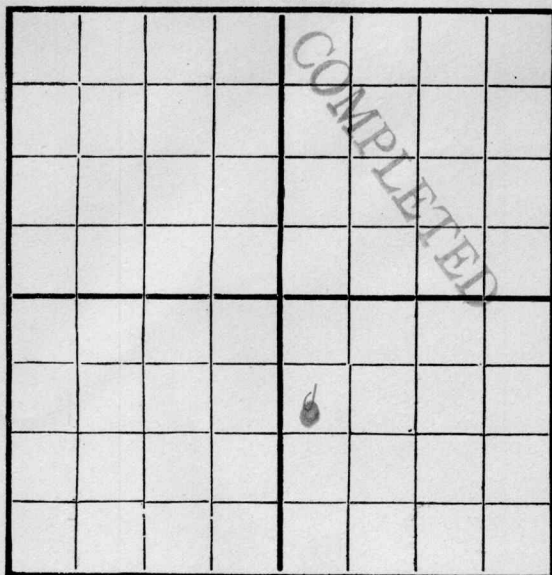

SOUTH

Location _____

Rig Up _____

Drilling Remarks:

Drilling Remarks:

3/31 2160

RECORD

Cased _____ in _____ Ft.

Sand _____

Gas _____

Oil _____

Total Depth _____

PRODUCTION

1st 24 hrs. Nat. _____

1st 24 hrs. after shot _____

Gas _____ Cu. Ft.

Dry Hole _____


Abandoned _____

Map No. _____ Sec. 8 Twp. 28 R. 4Well No. 1 Church well Farm _____Holf & Stat Company _____

NORTH

WEST

EAST

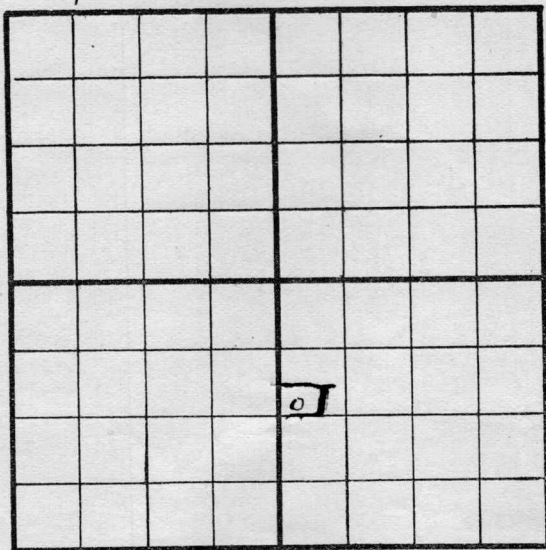

SOUTH

Location _____

Rig up _____

Drilling and remarks

2160 ft
Hole full water

RECORD

Cased _____ in. _____ Ft.

Sand _____

Gas _____

Oil _____

Total Depth _____

PRODUCTION

1st 24 hrs. Nat. _____

1st 24 hrs. after shot _____

Gas _____ Cu. Ft.

Dry Hole _____

Abandoned _____

Date

3/31, 1916, Kirkland Scout