


Map No. _____ Sec. 8 Twp. 28 R. 4
 Well No. 3 E C Warner Farm
Cont'd 08 5 Company

NORTH

WEST

EAST

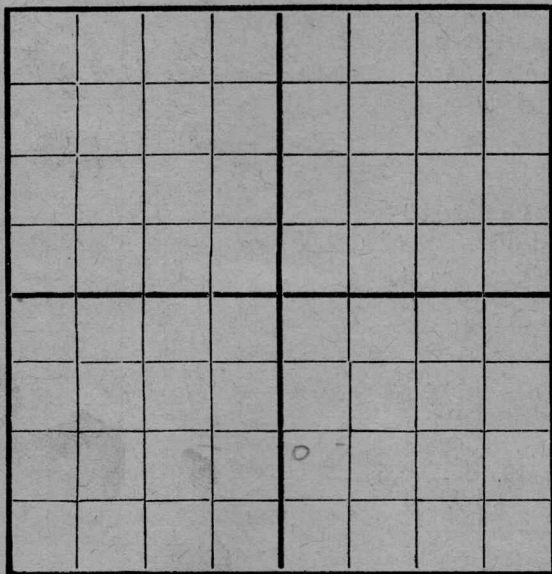

SOUTH

Location _____

Rig Up _____

Drilling and remarks

900'

RECORD

Cased _____ in. _____ Ft.

Sand _____

Gas _____

Oil _____

Total Depth _____

PRODUCTION

1st 24 hrs. Nat. _____

1st 24 hrs. after shot _____

Gas _____ Cu. Ft.

Dry Hole _____

Abandoned _____

Date

6/131916Scout

Scout

Map No. _____ Sec. 8 Twp. 28 R. 4Well No. 380 Warner Farm _____

Company _____

NORTH

WEST

EAST

SOUTH

Location _____

Rig Up _____

Drilling and remarks

1600' and
a lot of gas

RECORD

Cased _____ in. _____ Ft.

Sand _____

Gas _____

Oil _____

Total Depth _____

PRODUCTION

1st 24 hrs. Nat. _____

1st 24 hrs. after shot _____

Gas _____ Cu. Ft.

Dry Hole _____

Abandoned _____

Date


7/3, 1916 W. C. Cloud Scout

Map No. _____ Sec. 8 Twp. 28 R. 4
 Well No. 3 EC Tram Farm _____
 _____ Company Company _____

NORTH

WEST

EAST

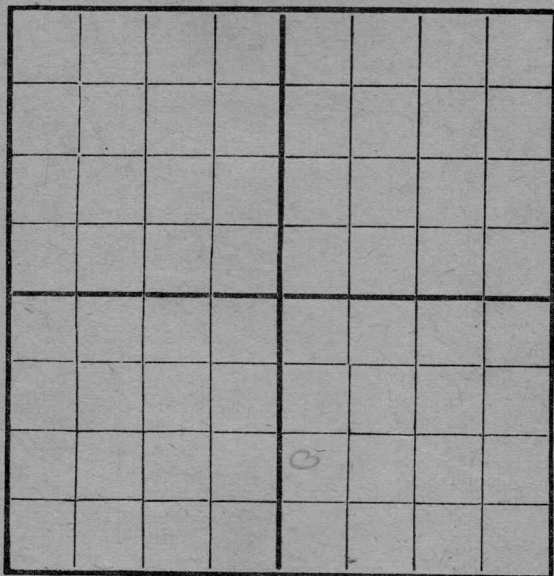

SOUTH

Location _____
 Rig Up _____
 Drilling and remarks _____

2030

RECORD

Cased _____ in. _____ Ft.
 Sand _____
 Gas _____
 Oil _____
 Total Depth _____

PRODUCTION

1st 24 hrs. Nat. _____
 1st 24 hrs. after shot _____
 Gas _____ Cu. Ft.
 Dry Hole _____
 Abandoned _____

Date

7/1, 1916 Scout

Map No. _____ Sec. 8 Twp. 28 R. 4Well No. 3 E C Varner Farm _____

Company _____

NORTH

WEST

EAST

SOUTH

Location _____

Rig Up _____

Drilling and remarks

2408 = M
top of sand

RECORD

Cased _____ in. _____ Ft.

Sand _____

Gas _____

Oil _____

Total Depth _____

PRODUCTION

1st 24 hrs. Nat. _____

1st 24 hrs. after shot _____

Gas _____ Cu. Ft.

Dry Hole _____

Abandoned _____

Date

7/21, 1916 L. C. Varner Scout

Map No. _____ Sec. 8 Twp. 38 R. 4
 Well No. 3 E C Vanner Farm _____
Company Company _____

NORTH

WEST

EAST

SOUTH

Location _____

Rig Up _____

Drilling and remarks _____

*Hole full
oil
Closed down*

RECORD

Cased _____ in. _____ Ft.

Sand 2408-2456

Gas _____

Oil _____

Total Depth _____

PRODUCTION

1st 24 hrs. Nat. _____

1st 24 hrs. after shot _____

Gas _____ Cu. Ft.

Dry Hole _____

Abandoned _____

Date

7/25, 1916 Scout Scout

(Location of Well #6 same as
Well No 3. F.S.)