

Map No. _____ Sec. 8 Twp. 28 R. 4
 Well No. H. Church Lot Farm _____
Walf et al. Company _____

NORTH

WEST



EAST

SOUTH

Location _____

Rig Up 1-15-17

Drilling Remarks:

Drilling Remarks:

RECORD

Cased _____ in _____ Ft.
 Sand _____
 Gas _____
 Oil _____
 Total Depth _____

PRODUCTION

1st 24 hrs. Nat. _____
 1st 24 hrs. after shot _____
 Gas _____ Cu. Ft.
 Dry Hole _____
 Abandoned _____

Map No. K11 Sec. 8 Twp. 38 R. 4
 Well No. 4 Church St Farm
Wolfe St Company

NORTH

WEST

EAST

SOUTH

Location ✓
 Rig Up ✓
 Drilling and remarks

RECORD

Cased _____ in. _____ Ft.
 Sand _____
 Gas _____
 Oil _____
 Total Depth _____

PRODUCTION


1st 24 hrs. Nat. _____
 1st 24 hrs. after shot _____
 Gas _____ Cu. Ft.
 Dry Hole _____
 Abandoned _____

Date

1/15, 1917 Cond Scout

Map No. _____ Sec. 8 Twp. 28 R. 4
 Well No. 40 burial lot Farm _____
Wolfe et al Company _____

NORTH

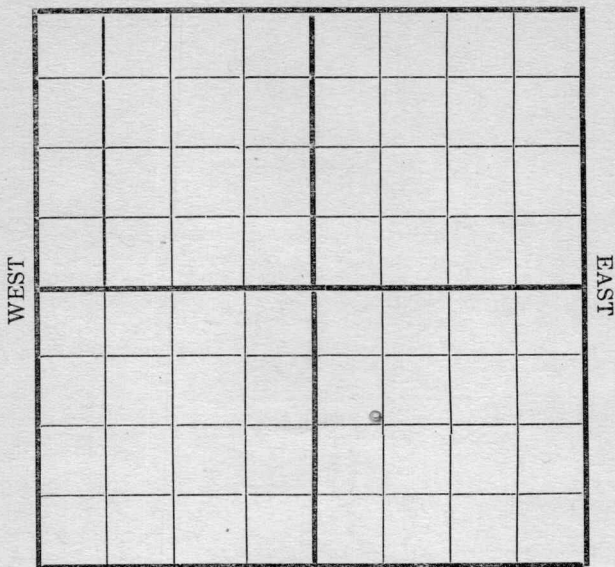

SOUTH

Location _____

Rig Up ☒ _____

Drilling and remarks _____

RECORD

Cased _____ in. _____ Ft.

Sand _____

Gas _____

Oil _____

Total Depth _____

PRODUCTION

1st 24 hrs. Nat. _____

1st 24 hrs. after shot _____

Gas _____ Cu. Ft.

Dry Hole _____


Abandoned _____

Date

1/22, 1917 Wolfe et al Scout

Map No. _____ Sec. 8 Twp. 28 R. 4
 Well No. 4 C Hursh Lot Farm _____
Wolfe et al Company _____

NORTH

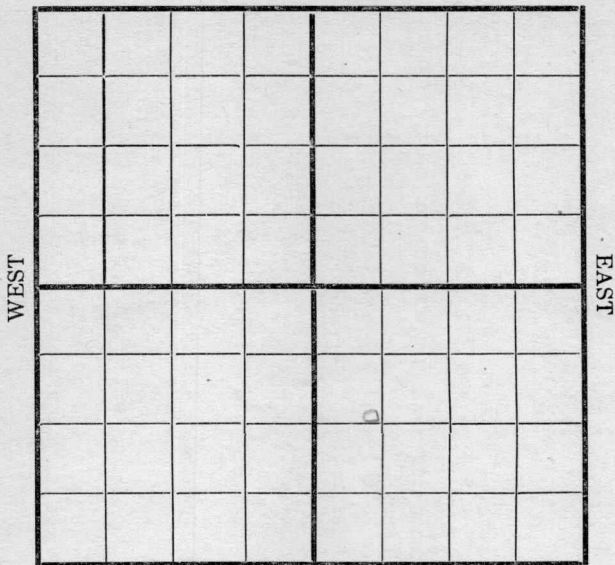

SOUTH

Location _____
 Rig Up _____
 Drilling and remarks _____

Spending

RECORD

Cased _____ in. _____ Ft.
 Sand _____
 Gas _____
 Oil _____
 Total Depth _____

PRODUCTION

1st 24 hrs. Nat. _____
 1st 24 hrs. after shot _____
 Gas _____ Cu. Ft.
 Dry Hole _____
 Abandoned _____

Date

1/29, 1917 Cordiff Scout

Map No. _____ Sec. 8 Twp. 28 R. 4
 Well No. 4 Church Sat Farm _____
Wolf et al Company _____

NORTH

WEST

EAST

SOUTH

Location _____
 Rig Up _____
 Drilling and remarks _____

Spaulding

RECORD

Cased _____ in. _____ Ft.
 Sand _____
 Gas _____
 Oil _____
 Total Depth _____

PRODUCTION


1st 24 hrs. Nat. _____
 1st 24 hrs. after shot _____
 Gas _____ Cu. Ft.
 Dry Hole _____
 Abandoned _____

Date

2/5, 1917 *Conley* Scout

Map No. _____ Sec. 8 Twp. 28 R. 4
 Well No. 4 Church Lat Farm _____
Wolfe et al Company _____

NORTH

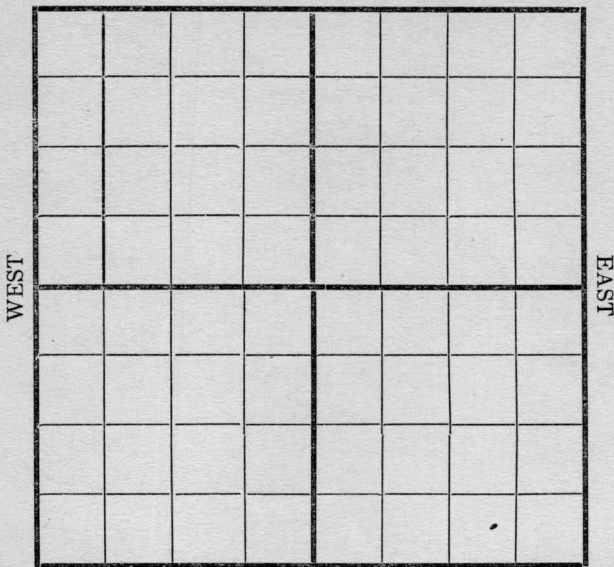

SOUTH

Location _____	RECORD
Rig Up _____	Cased _____ in. _____ Ft.
Drilling and remarks	Sand _____
<i>Spudded</i>	Gas _____
<i>in and</i>	Oil _____
<i>Shut Down</i>	Total Depth _____
	PRODUCTION
	1st 24 hrs. Nat. _____
	1st 24 hrs. after shot _____
	Gas _____ Cu. Ft.
	Dry Hole _____
	Abandoned _____


Date 2/12 1917 C. D. J. Scout

Map No. _____ Sec. 8 Twp. 28 R. 4
 Well No. 4 Church St Farm _____
Wolfe et al Company _____

NORTH

WEST

EAST

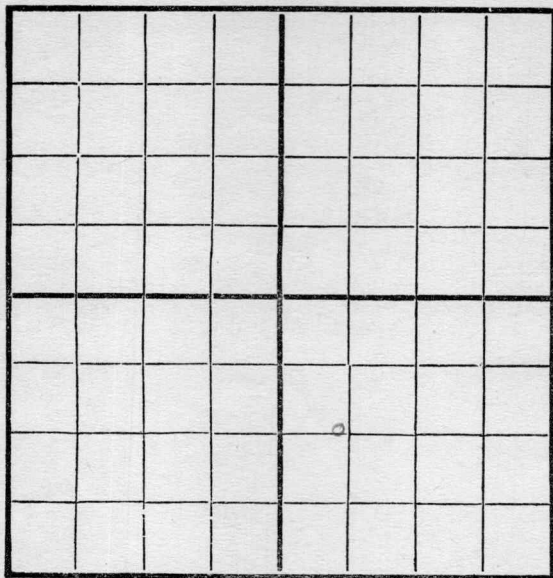

SOUTH

Location _____

Rig Up _____

Drilling and remarks

280

RECORD

Cased _____ in. _____ Ft.

Sand _____

Gas _____

Oil _____

Total Depth _____

PRODUCTION

1st 24 hrs. Nat. _____

First 24 hrs. after shot _____

Gas _____ Cu. Ft.

Dry Hole _____


Abandoned _____

Date

2/9, 1912 Wolfe et al Scout

Map No. _____ Sec. 8 Twp. 28 R. 4
 Well No. 4 Church Pot Farm _____
Wright Company

NORTH

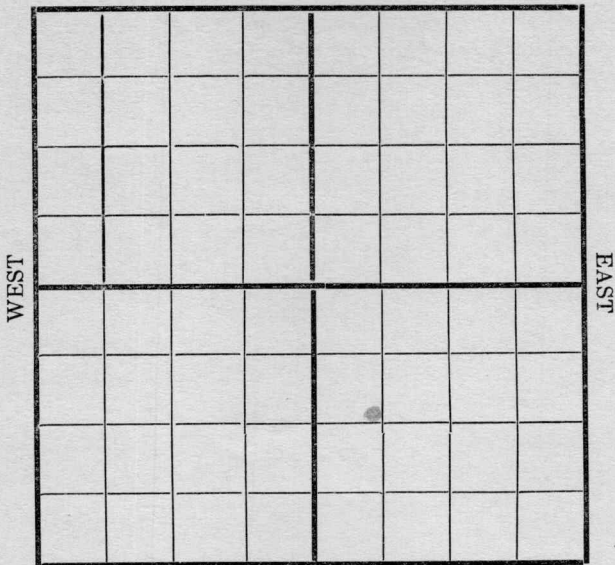

SOUTH

Location _____
 Rig Up _____
 Drilling and remarks _____

740'

RECORD

Cased _____ in. _____ Ft.
 Sand _____
 Gas _____
 Oil _____
 Total Depth _____

PRODUCTION

1st 24 hrs. Nat. _____
 1st 24 hrs. after shot _____
 Gas _____ Cu. Ft.
 Dry Hole _____
 Abandoned _____

Date

3/2, 1912 Cardi Scout

Map No. _____ Sec. 8 Twp. 28 R. 4Well No. 4 Church Lot FarmWolfe et al Company

NORTH

WEST

EAST

SOUTH

REMARKS:

1325

Date

3/5/7, 1917Carly


Scout

Map No. _____ Sec. 8 Twp. 28 R. 4Well No. 4 Church Lot Farm __________
Wolfe et al Company _____

NORTH

WEST

EAST

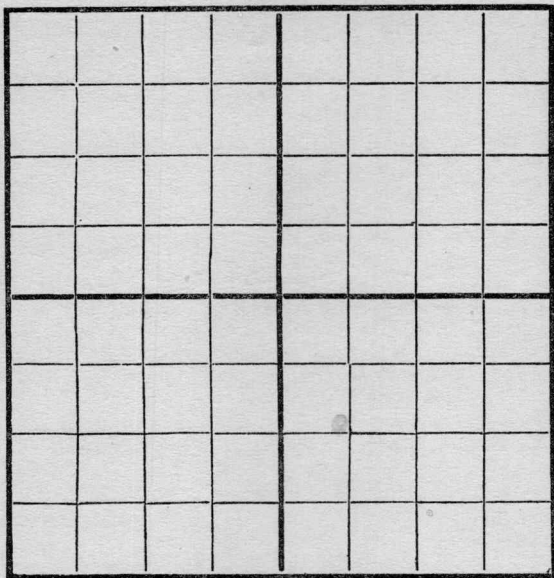

SOUTH

Location _____

Rig Up _____

Drilling and remarks

1780

RECORD

Cased _____ in. _____ Ft.

Sand _____

Gas _____

Oil _____

Total Depth _____

PRODUCTION

1st 24 hrs. Nat. _____

1st 24 hrs. after shot _____

Gas _____ Cu. Ft.

Dry Hole _____

Abandoned _____


Date

3/12, 191 7 C. Wolfe Scout

Map No. _____ Sec. 8 Twp. 28 R. 4
 Well No. 4 @ Clumma Lot Farm _____
Wolfe et al Company _____

NORTH

WEST

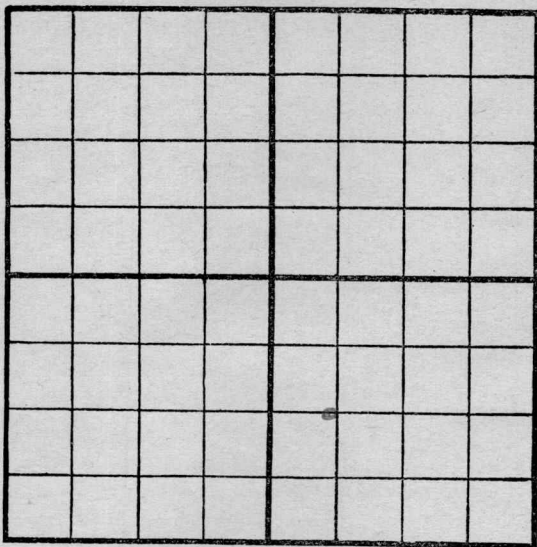

EAST

SOUTH

Location _____
 Rig Up _____
 Drilling and remarks

3000'

RECORD

Cased _____ in. _____ Ft.
 Sand _____
 Gas _____
 Oil _____
 Total Depth _____

PRODUCTION

1st 24 hrs. Nat. _____
 1st 24 hrs. after shot _____
 Gas _____ Cu. Ft.
 Dry Hole _____
 Abandoned _____

Date

3/9, 1917 C. Wolfe Scout

Map No. _____ Sec. 8 Twp. 28 R. 4Well No. 40 Church Lot Farm __________Wolfe et al Company _____

NORTH

WEST

EAST

SOUTH

Location _____

Rig Up _____

Drilling and remarks

2130

RECORD

Cased _____ in. _____ Ft.

Sand _____

Gas _____

Oil _____

Total Depth _____

PRODUCTION

1st 24 hrs. Nat. _____

1st 24 hrs. after shot _____

Gas _____ Cu. Ft.

Dry Hole _____


Abandoned _____

Date

3/26 1917 C. D. Wolfe Scout

Map No. _____ Sec. 8 Twp. 28 R. 4
 Well No. 4 Church Lot Farm _____
Wolfe Chap Company _____

NORTH

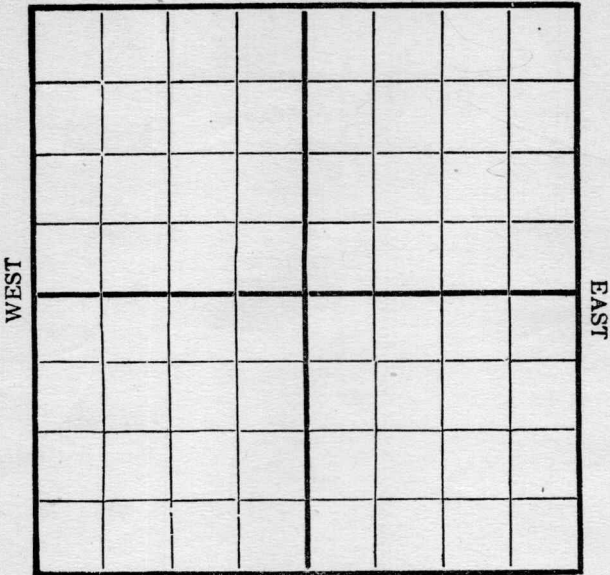

SOUTH

Location _____
 Rig Up _____
 Drilling and remarks _____

Tap sand
2421'

RECORD

Cased _____ in. _____ Ft.
 Sand _____
 Gas _____
 Oil _____
 Total Depth _____

PRODUCTION

1st 24 hrs. Nat. _____
 First 24 hrs. after shot _____
 Gas _____ Cu. Ft.
 Dry Hole _____
 Abandoned _____


Date 4/4, 1917 W. Wolfe Scout

Map No. 114 Sec. 8 Twp. 28 R. 4Well No. H. Church loc.Waffle oval Company

Contractor

NORTH

WEST

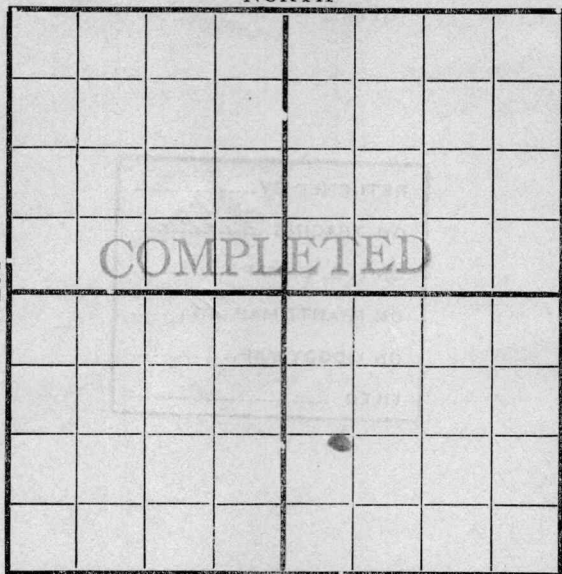

EAST

SOUTH

Location _____

Rig up _____

Drilling and Remarks:

Top sand
2421 ft
Est at 150
300
4/10/1917

RECORD

Cased _____ in., _____ ft.

Sand 2421-2461

Gas _____

Oil _____

Total Depth _____

PRODUCTION

1st 24 hrs. Nat. _____

1st 24 hrs. after shot _____

Gas _____ Cu. Ft.

Dry Hole _____

Abandoned _____

Date

191

Scout