


Map No. _____ Sec. 8 Twp. 28 R. 4Well No. #4 Drinton Farm
Leonard Cornelius & Haines Company

NORTH

WEST

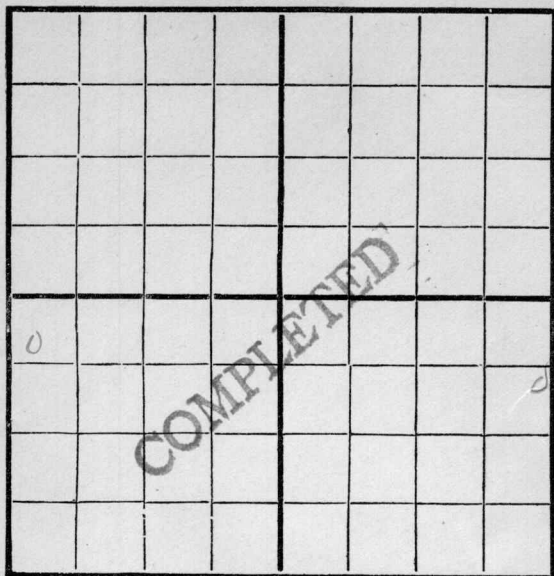

EAST

SOUTH

Location _____

Drilling Remarks:

4/6 1710
5/18 2350

Rig Up _____

Drilling Remarks:

RECORD

Cased _____ in _____ Ft.

Sand _____

Gas _____

Oil _____

Total Depth _____

PRODUCTION

1st 24 hrs. Nat. _____

1st 24 hrs. after shot _____

Gas _____ Cu. Ft.

Dry Hole _____


Abandoned _____

Map No. _____ Sec. 8 Twp. 28 R. 4

Well No. 4 Denison Farm _____
Leonard Cornelius Thunes Company

NORTH

WEST

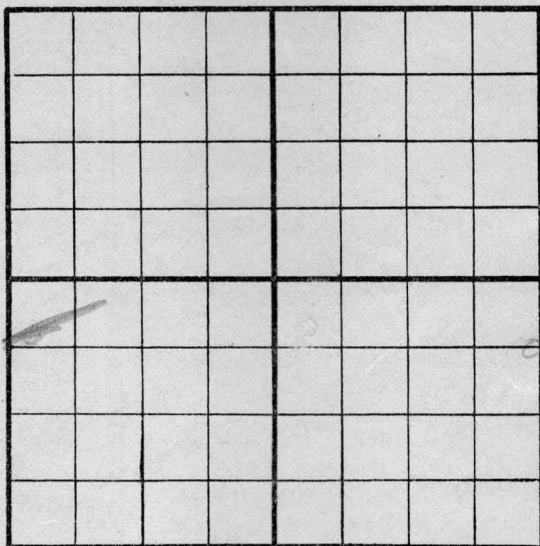

EAST

SOUTH

Location _____

Rig up _____

Drilling and remarks

1710 ft

RECORD

Cased _____ in. _____ Ft.

Sand _____

Gas _____

Oil _____

Total Depth _____

PRODUCTION

1st 24 hrs. Nat. _____

1st 24 hrs. after shot _____

Gas _____ Cu. Ft.

Dry Hole _____

Abandoned _____

Date


4/6, 1916, Kennel _____ Score _____

Map No. _____ Sec. 4 Twp. 28 R. 4
 Well No. 4 53 Denison Farm _____
Leonard et al Company _____

NORTH

WEST

EAST

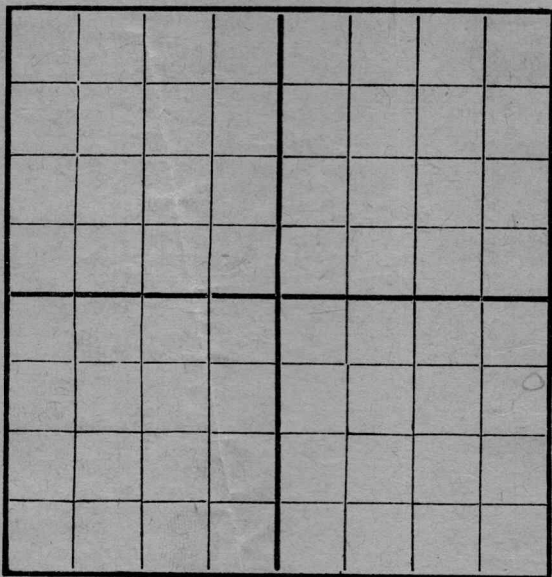

SOUTH

Location _____
 Rig Up _____
 Drilling and remarks _____

RECORD
 Cased _____ in. _____ Ft.
 Sand _____
 Gas _____
 Oil _____
 Total Depth _____

PRODUCTION
 1st 24 hrs. Nat. _____
 1st 24 hrs. after shot _____
 Gas _____ Cu. Ft.
 Dry Hole _____
 Abandoned _____

Date


Apr 2, 1916 S. C. Clendinning Scout

Location & Farm do
not agree

Map No. _____ Sec. 8 Twp. 38 R. 4Well No. H S W Denton Farm _____Leonard Stal Company _____

NORTH

WEST

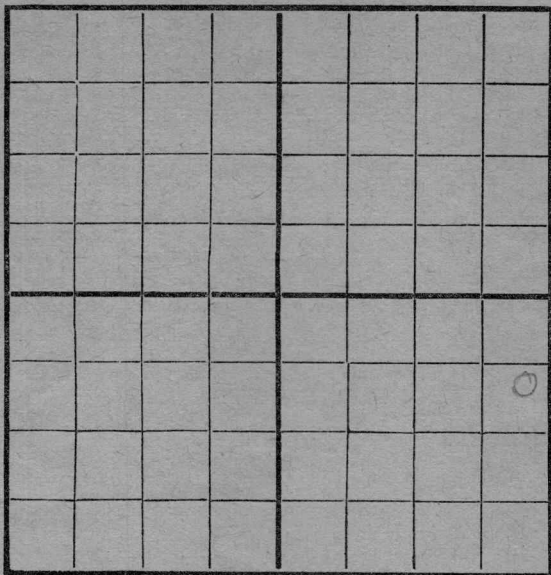

EAST

SOUTH

Location _____

Rig Up _____

Drilling and remarks

2370'

RECORD

Cased _____ in. _____ Ft.

Sand _____

Gas _____

Oil _____

Total Depth _____

PRODUCTION

1st 24 hrs. Nat. _____

1st 24 hrs. after shot _____

Gas _____ Cu. Ft.

Dry Hole _____

Abandoned _____

Date

6/30, 1916 Leonard Stal Scout

Map No. 1002 K 11 Sec. 8 Twp. 28 R. 4

Well No. 4 H. W. Denton

Leonard & Co. Company

Contractor

NORTH

WEST

EAST



SOUTH

Location _____

Rig up _____

Drilling and Remarks:

*2 3/4 to 4 ft
fishing
Estimated at
600 lbs*

RECORD

Cased _____ in., _____ ft.

Sand 2425-2500

Gas _____

Oil _____

Total Depth _____

PRODUCTION

1st 24 hrs. Nat. _____

1st 24 hrs. after shot _____

Gas _____ Cu. Ft.

Dry Hole _____

Abandoned _____

Date

6/12/16
1916

Scout