


Map No. _____ Sec. 8 Twp. 28 R. 4Well No. 5 Dinton Denton FarmLeonard Cornelius & Henry Company

NORTH

WEST

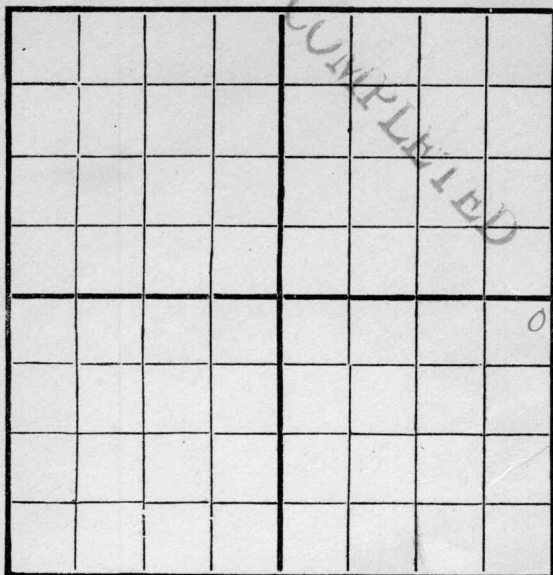

EAST

SOUTH

Location _____

Drilling Remarks:

46 2250
5/29 - 600 Hbl

Rig Up _____

Drilling Remarks:

RECORD

Cased _____ in _____ Ft.

Sand _____

Gas _____

Oil _____

Total Depth _____

PRODUCTION

1st 24 hrs. Nat. _____

1st 24 hrs. after shot _____

Gas _____ Cu. Ft.

Dry Hole _____

Abandoned _____


Map No. _____ Sec. 879 Twp. 28 R. 4

Well No. 45 Benton Farm _____

Leonard Leonard & Son Company

NORTH

WEST

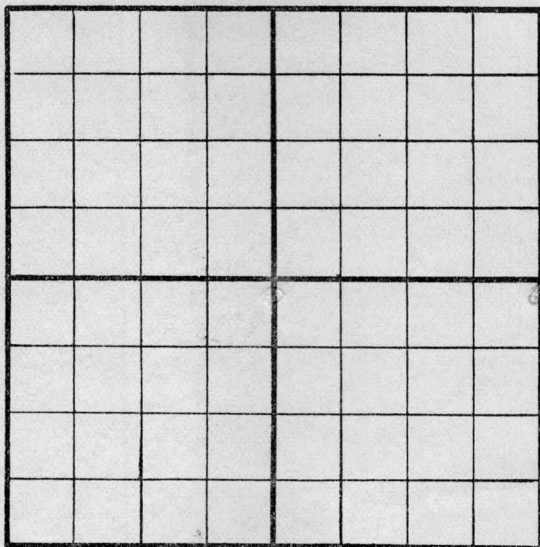

EAST

SOUTH

Location _____

Rig up _____

Drilling and remarks

2250 ft
driller run
6" casing

RECORD

Cased _____ in. _____ Ft.

Sand _____

Gas _____

Oil _____

Total Depth _____

PRODUCTION

1st 24 hrs. Nat. _____

1st 24 hrs. after shot _____

Gas _____ Cu. Ft.

Dry Hole _____


Abandoned _____

Date

4/6, 1916, Kirkland Scout

Map No. _____ Sec. 8 Twp. 28 R. 4
 Well No. 5 Denton Farm _____
Leonard et al Company _____

NORTH

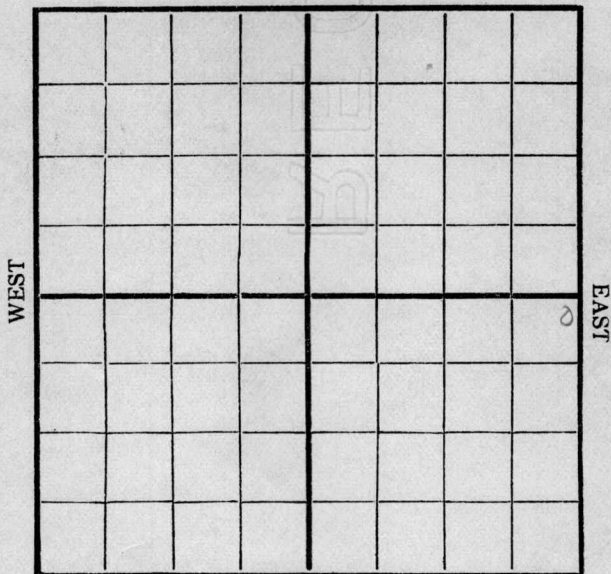

SOUTH

Location _____
 Rig Up _____
 Drilling and remarks _____

RECORD

Cased _____ in. _____ Ft.
 Sand 2501 - 2532
 Gas _____
 Oil _____
 Total Depth _____

PRODUCTION

1st 24 hrs. Nat. _____
 1st 24 hrs. after shot _____
 Gas _____ Cu. Ft.
 Dry Hole _____
 Abandoned _____


Date

July 29, 1916 Leonard Scout

Map No. _____ Sec. 8 Twp. 28 R. 4
 Well No. 5 Denton Farm _____
L. C. & Thomas Company _____

NORTH

WEST

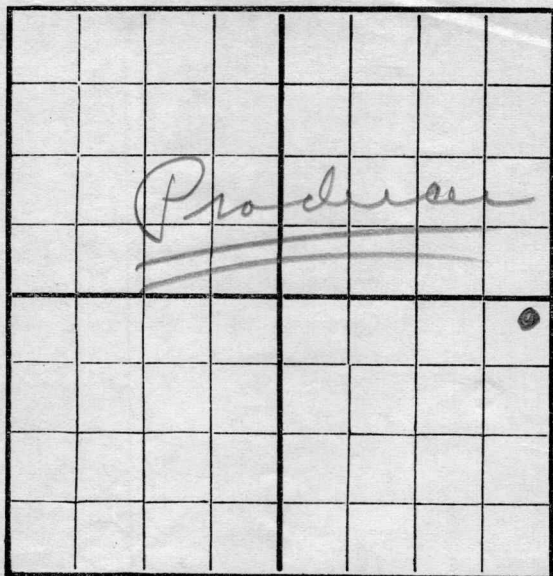

EAST

SOUTH

Location _____
 Rig Up _____
 Drilling and remarks _____

about 400
bbls

RECORD

Cased _____ in. _____ Ft.
 Sand 2501-2530 1/2
 Gas _____
 Oil _____
 Total Depth _____

PRODUCTION

1st 24 hrs. Nat. _____
 1st 24 hrs. after shot _____
 Gas _____ Cu. Ft.
 Dry Hole _____
 Abandoned _____

Date

7/12, 1916 L. C. & Thomas Scout