


Map No. 7 Sec. 8 Twp. 28 R. 4Well No. 5 Denlin FarmPurless Petroleum Company

NORTH

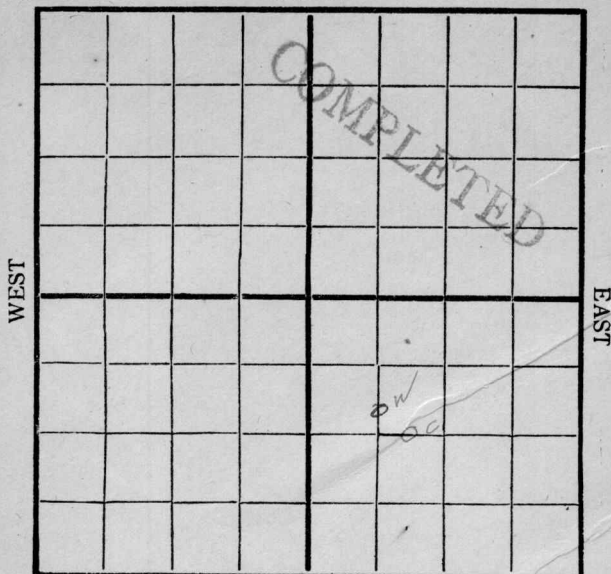

SOUTH

Location _____

Rig Up 10-30-16

Drilling Remarks:

Drilling Remarks:

800 = 11/9 =1200 = 11/141540 = 11/271850 = 12/42030 = 12/112180 = 12/182230 = 12/28

RECORD

PRODUCTION

Cased _____ in _____ Ft.

1st 24 hrs. Nat. _____

Sand _____

1st 24 hrs. after shot _____

Gas _____

Gas _____ Cu. Ft.

Oil _____

Dry Hole _____

Total Depth _____


Abandoned _____

Map No. _____ Sec. 8 Twp. 28 R. 4
 Well No. 52 Denton Farm _____
Peoples Petro Company

NORTH

WEST

EAST

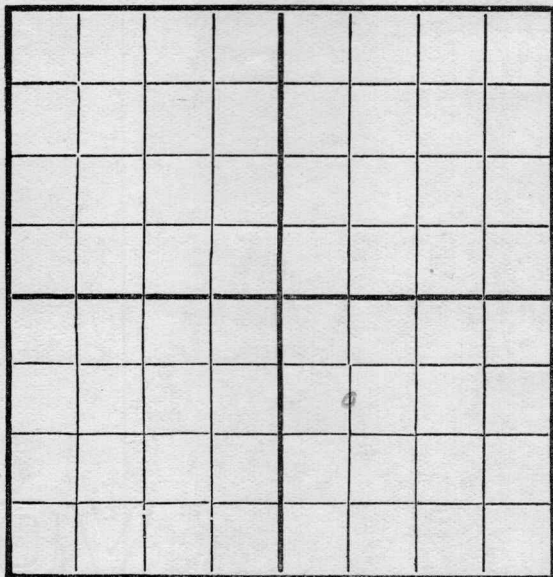

SOUTH

Location _____
 Rig Up ☒ _____
 Drilling and remarks _____

RECORD

Cased _____ in. _____ Ft.
 Sand _____
 Gas _____
 Oil _____
 Total Depth _____

PRODUCTION


1st 24 hrs. Nat. _____
 First 24 h. s. after shot _____
 Gas _____ Cu. Ft.
 Dry Hole _____
 Abandoned _____

Date

10/30, 1916 G. S. Peck Scout

Map No. _____ Sec. 8 Twp. 28 R. 4
 Well No. 5 Denton Farm _____
Peerless Petro Company

NORTH

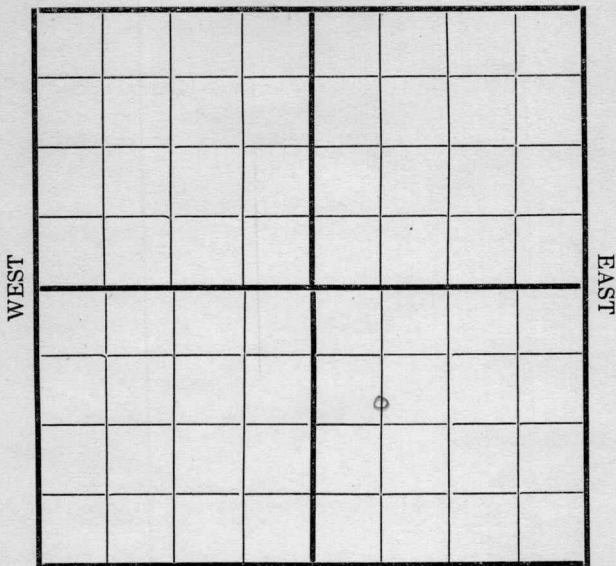

SOUTH

Location ✓
 Rig Up ✓
 Drilling and remarks

800

RECORD

Cased _____ in. _____ Ft.
 Sand _____
 Gas _____
 Oil _____
 Total Depth _____

PRODUCTION


1st 24 hrs. Nat. _____
 1st 24 hrs. after shot _____
 Gas _____ Cu. Ft.
 Dry Hole _____
 Abandoned _____

Date

11/9, 191 6 J. Hardy Scout

Map No. _____ Sec. 8 Twp. 28 R. 4
 Well No. 5 Denton Farm
Pearless Peto Company

NORTH

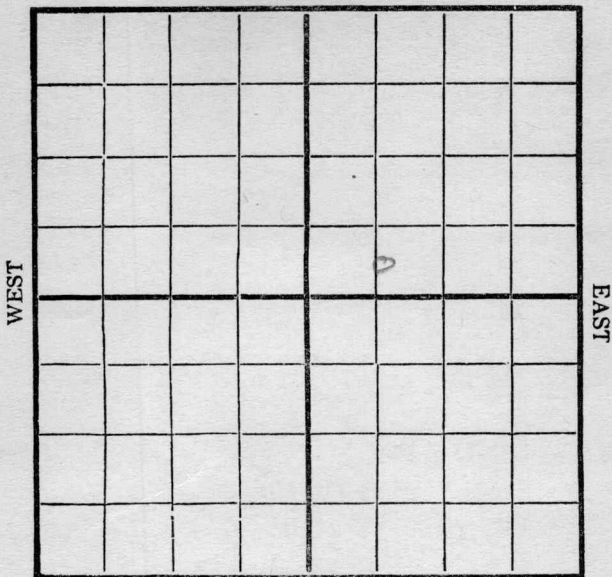

SOUTH

Location _____
 Rig Up _____
 Drilling and remarks _____

1200

RECORD

Cased _____ in. _____ Ft.
 Sand _____
 Gas _____
 Oil _____
 Total Depth _____

PRODUCTION


1st 24 hrs. Nat. _____
 First 24 hrs. after shot _____
 Gas _____ Cu. Ft.
 Dry Hole _____
 Abandoned _____

Date

11/14, 1916 Carney Scout

Map No. _____ Sec. 8 Twp. 28 R. 4
Well No. 5 Denton Farm _____
Pearl & Peter Company _____

NORTH

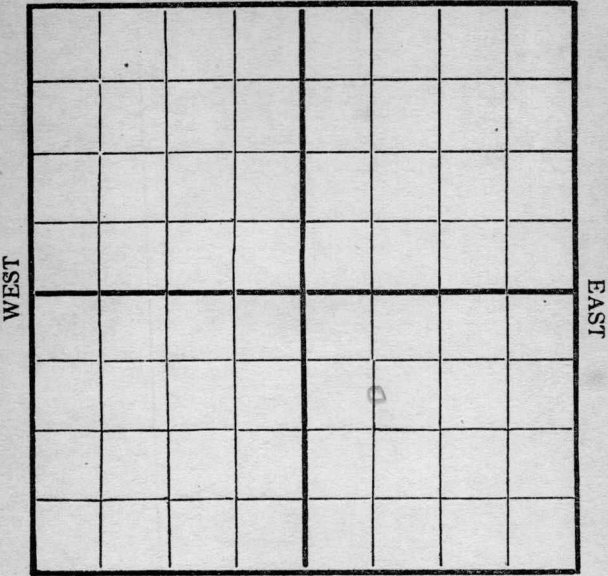

SOUTH

Location _____
Rig Up _____
Drilling and remarks _____

*Shut Down
at 1200*

RECORD

Cased _____ in. _____ Ft.
Sand _____
Gas _____
Oil _____
Total Depth _____

PRODUCTION

1st 24 hrs. Nat. _____
1st 24 hrs. after shot _____
Gas _____ Cu. Ft.
Dry Hole _____
Abandoned _____


Date 11/20 1916 C. A. Dyer Scout _____

Map No. _____ Sec. 8 Twp. 38 R. 4Well No. 5 Denton Farm _____Peoples Petroleum Company _____

NORTH

WEST

EAST

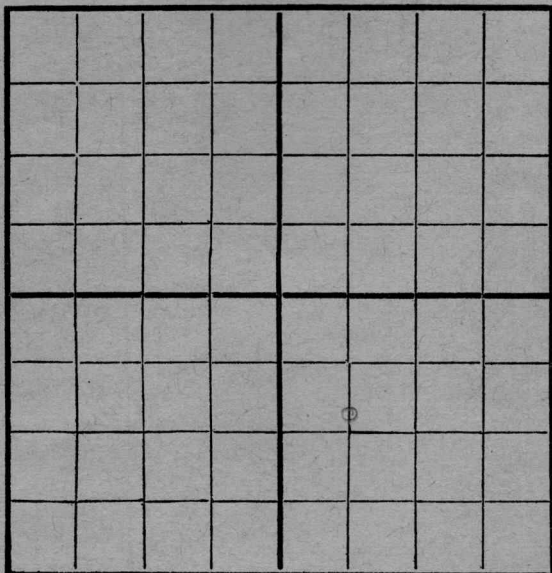

SOUTH

Location _____

Rig Up _____

Drilling and remarks

1540

RECORD

Cased _____ in. _____ Ft.

Sand _____

Gas _____

Oil _____

Total Depth _____

PRODUCTION

1st 24 hrs. Nat. _____

1st 24 hrs. after shot _____

Gas _____ Cu. Ft.

Dry Hole _____

Abandoned _____

Date


11/27, 1916, Candiff Scout

Map No. _____ Sec. 8 Twp. 28 R. 4Well No. 57 Denton Farm _____Company Peoples Petro

NORTH

WEST

EAST

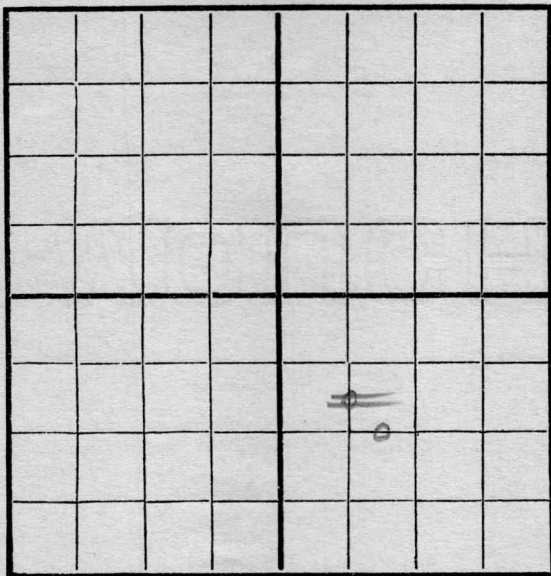

SOUTH

Location _____

Rig Up _____

Drilling and remarks

*Changed
Location and
#5 to #7*

RECORD

Cased _____ in. _____ Ft.

Sand _____

Gas _____

Oil _____

Total Depth _____

PRODUCTION

1st 24 hrs. Nat. _____

1st 24 hrs. after shot _____

Gas _____ Cu. Ft.

Dry Hole _____

Abandoned _____


Date

12/2, 1916, Candiff Scout

Map No. _____ Sec. 8 Twp. 28 R. 4
 Well No. 7 Denton Farm _____
Peerless Petro Company _____

NORTH

WEST

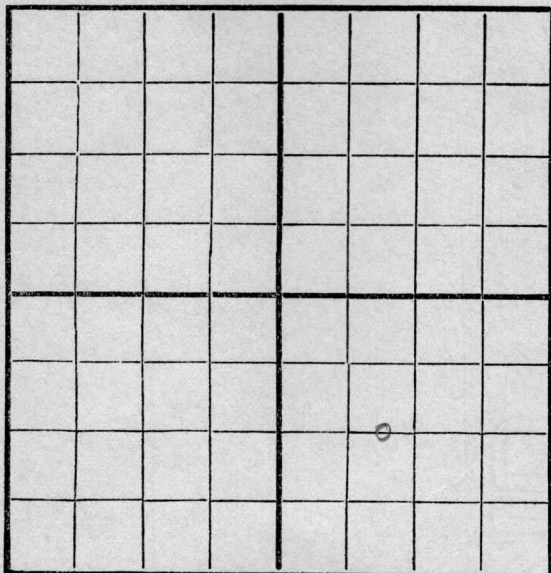

EAST

SOUTH

Location _____
 Rig Up _____
 Drilling and remarks _____

1850'

RECORD

Cased _____ in. _____ Ft.
 Sand _____
 Gas _____
 Oil _____
 Total Depth _____

PRODUCTION

1st 24 hrs. Nat. _____
 1st 24 hrs. after shot _____
 Gas _____ Cu. Ft.
 Dry Hole _____
 Abandoned _____

Date


12/4, 1916, Cordex Scout

Map No. _____ Sec. 8 Twp. 28 R. 4Well No. 7 Denton Farm __________Peebles Petro Company

NORTH

WEST

EAST

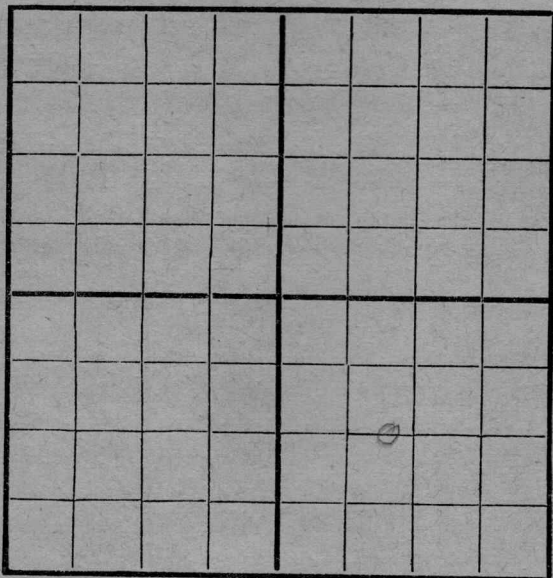

SOUTH

Location _____

Rig Up _____

Drilling and remarks

2030

RECORD

Cased _____ in. _____ Ft.

Sand _____

Gas _____

Oil _____

Total Depth _____

PRODUCTION

1st 24 hrs. Nat. _____

1st 24 hrs. after shot _____

Gas _____ Cu. Ft.

Dry Hole _____

Abandoned _____


Date

10/11, 1916 Cordell Scout

Map No. _____ Sec. 8 Twp. 28 R. 4Well No. 7 _____ Farm _____Pearless Petroleum Company

NORTH

WEST

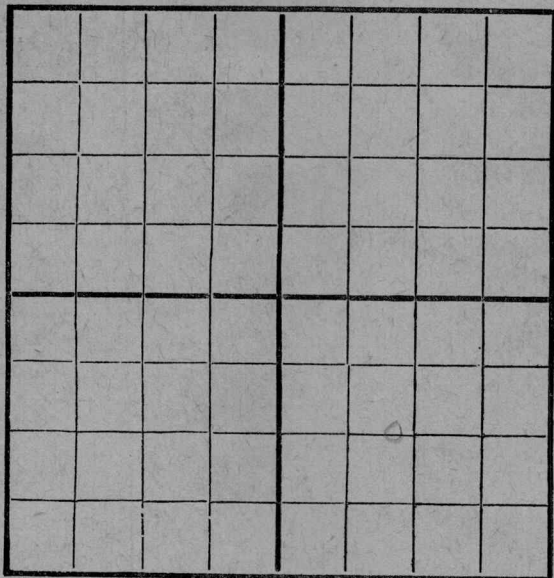

EAST

SOUTH

Location _____

Rig Up _____

Drilling and remarks

2180'

RECORD

Cased _____ in. _____ Ft.

Sand _____

Gas _____

Oil _____

Total Depth _____

PRODUCTION

1st 24 hrs. Nat. _____

1st 24 hrs. after shot _____

Gas _____ Cu. Ft.

Dry Hole _____

Abandoned _____

Date


10/28/1916 _____ Scout

Map No. _____ Sec. 8 Twp. 28 R. 4Well No. 79 Farm _____Peelias Petro Company _____

NORTH

WEST

EAST

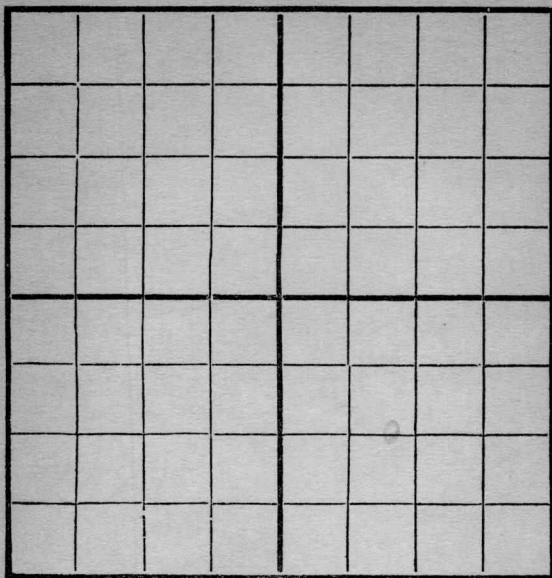

SOUTH

Location _____

Rig Up _____

Drilling and remarks

2230

RECORD

Cased _____ in. _____ Ft.

Sand _____

Gas _____

Oil _____

Total Depth _____

PRODUCTION

1st 24 hrs. Nat. _____

First 24 hrs. after shot _____

Gas _____ Cu. Ft.

Dry Hole _____

Abandoned _____

Date



Map No. _____ Sec. 8 Twp. 28 R. 4

Well No. 72 Denton Farm _____

Pearles Petro Company _____

NORTH

WEST

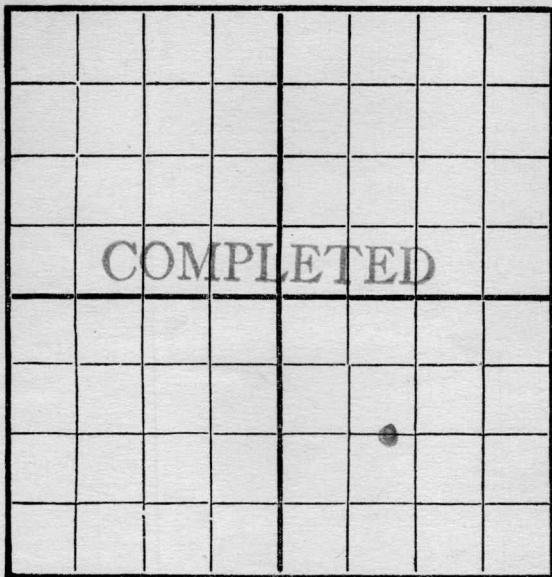

EAST

SOUTH

Location _____

Rig Up _____

Drilling and remarks

Est at
250
Bbls

RECORD

Cased _____ in. _____ Ft.

Sand 2409 - 2434

Gas _____

Oil _____

Total Depth _____

PRODUCTION

1st 24 hrs. Nat. _____

First 24 hrs. after shot _____

Gas _____ Cu. Ft.

Dry Hole _____

Abandoned _____

Date

1/1, 1912 Cord Scout