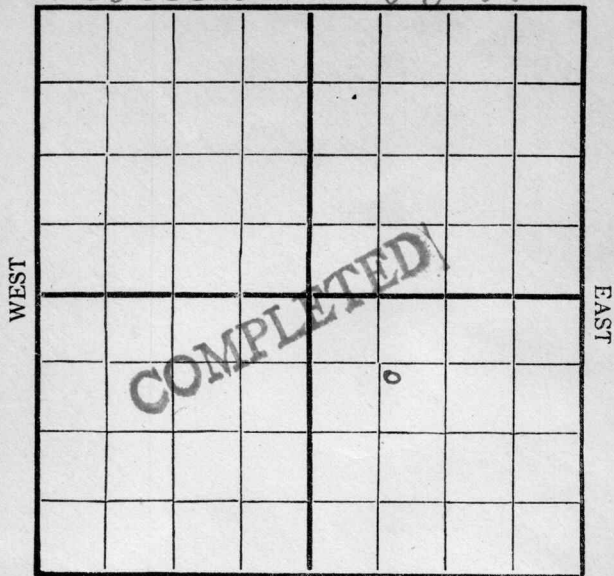


Map No. _____ Sec. 8 Twp. 28 R. 4Well No. 7 Denton _____ Farm~~Producers~~
Harrison NORTH 089 Company

SOUTH

Location _____

Rig Up _____

Drilling Remarks:

Drilling Remarks:

RECORD

Cased _____ in _____ Ft.

Sand _____

Gas _____

Oil _____

Total Depth _____

PRODUCTION

1st 24 hrs. Nat. _____

1st 24 hrs. after shot _____


Gas _____ Cu. Ft.

Dry Hole _____

Abandoned _____

Map No. _____ Sec. 8 Twp. 28 R. 4
 Well No. 92 Denton Farm _____
Producers Company _____

NORTH

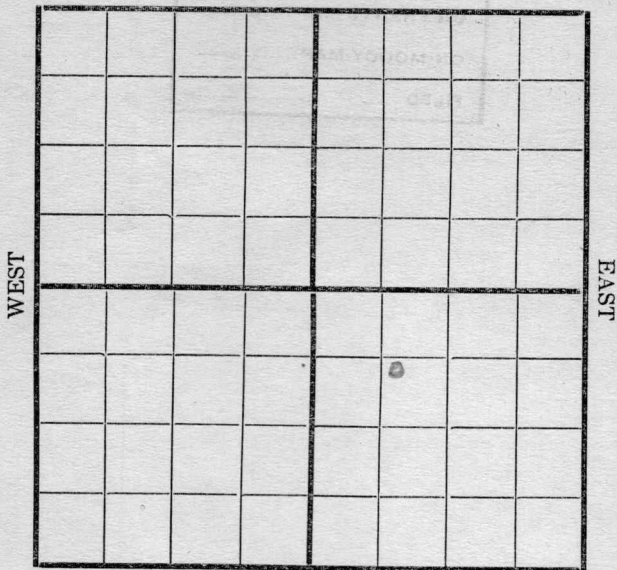

SOUTH

Location _____
 Rig Up ☒ _____
 Drilling and remarks _____

First Report

RECORD

Cased _____ in. _____ Ft.
 Sand _____
 Gas _____
 Oil _____
 Total Depth _____

PRODUCTION

1st 24 hrs. Nat. _____
 1st 24 hrs. after shot _____
 Gas _____ Cu. Ft.
 Dry Hole _____
 Abandoned _____

Date 5/3, 1917 Candis Scout

Map No. K11 Sec. 8 Twp. 28 R. 4Well No. 9 Denton FarmProducers Company

NORTH

WEST

EAST

SOUTH

Location ✓Rig Up ✓

Drilling and remarks

RECORD

Cased _____ in. _____ Ft.

Sand _____

Gas _____

Oil _____

Total Depth _____

PRODUCTION

1st 24 hrs. Nat. _____

1st 24 hrs. after shot _____

Gas _____ Cu. Ft.

Dry Hole _____

Abandoned _____

Date


5/8, 191 7 Cordell Scout

Map No. _____ Sec. 8 Twp. 28 R. 4
 Well No. 9 Denton Farm _____
Producers Company _____

NORTH

WEST

EAST

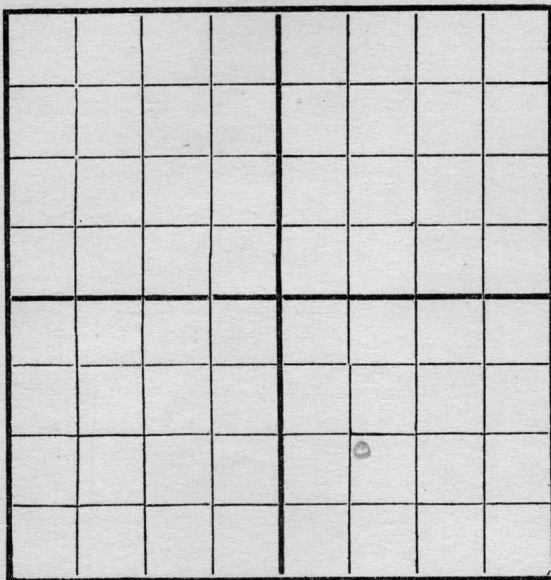

SOUTH

Location _____
 Rig Up _____
 Drilling and remarks _____

*Spudding
 300'*

RECORD

Cased _____ in. _____ Ft.
 Sand _____
 Gas _____
 Oil _____
 Total Depth _____

PRODUCTION

1st 24 hrs. Nat. _____
 1st 24 hrs. after shot _____
 Gas _____ Cu. Ft.
 Dry Hole _____
 Abandoned _____

Date


5/25, 191 7 *Rankin* Scout

Map No. _____ Sec. 8 Twp. 28 R. 4
Well No. 9 Denton Farm _____
Producers Company _____

NORTH

WEST

EAST

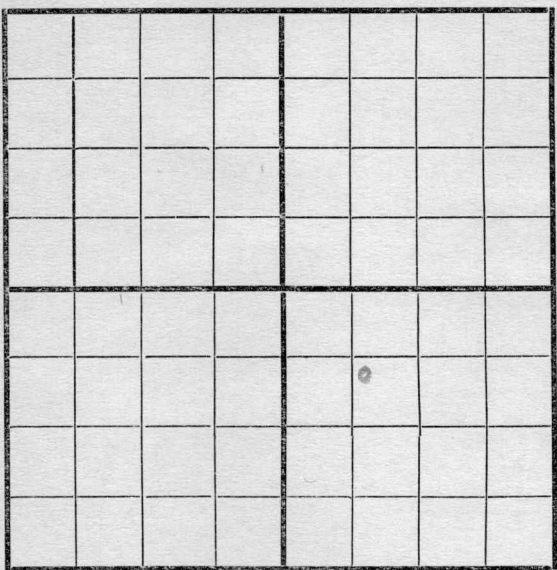

SOUTH

	RECORD
Location _____	Cased _____ in. _____ Ft.
Rig Up _____	Sand _____
Drilling and remarks <u>725</u>	Gas _____
	Oil _____
	Total Depth _____
	PRODUCTION
	1st 24 hrs. Nat. _____
	1st 24 hrs. after shot _____
	Gas _____ Cu. Ft.
	Dry Hole _____
	Abandoned _____


Date 5/09, 1917 C. A. Duff Scout

Map No. _____ Sec. 8 Twp. 28 R. 4
Well No. 92 Denton Farm _____
Producers Company _____

NORTH

WEST

EAST

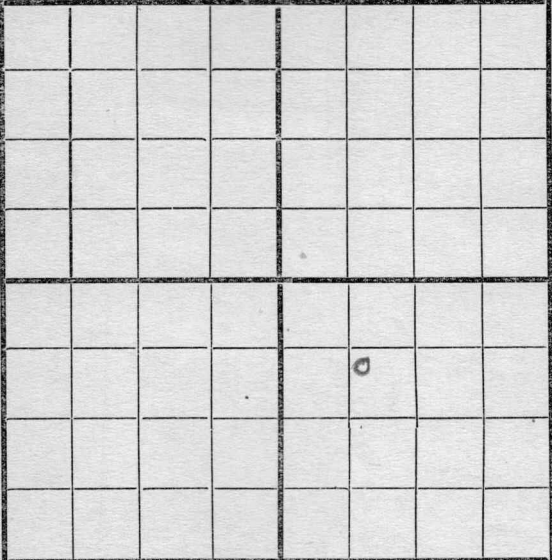

SOUTH

Location _____
Rig Up _____
Drilling and remarks _____

980

RECORD

Cased _____ in. _____ Ft.
Sand _____
Gas _____
Oil _____
Total Depth _____

PRODUCTION


1st 24 hrs. Nat. _____
1st 24 hrs. after shot _____
Gas _____ Cu. Ft.
Dry Hole _____
Abandoned _____

Date 658, 191 7 Candiff Scout

Map No. _____ Sec. 8 Twp. 28 R. 4
 Well No. 9 Denton Farm _____
Producers Company _____

NORTH

WEST

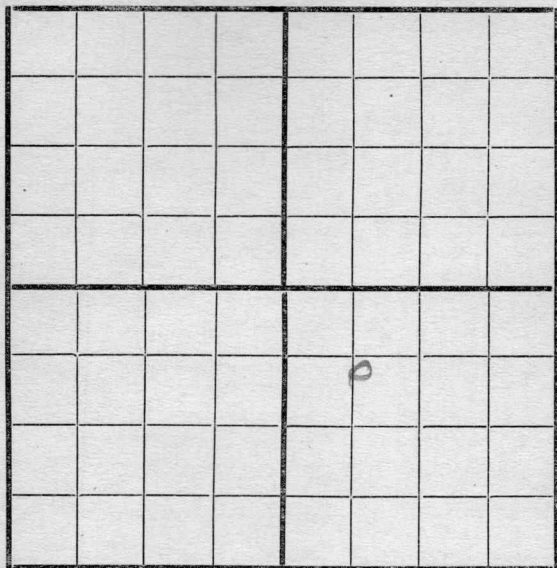

EAST

SOUTH

Location _____

Rig Up _____

Drilling and remarks

RECORD

Cased _____ in. _____ Ft.

Sand _____

Gas _____

Oil _____

Total Depth _____

PRODUCTION

1st 24 hrs. Nat. _____

1st 24 hrs. after shot _____

Gas _____ Cu. Ft.

Dry Hole _____

Abandoned _____

Date


6/12 191 7 Conley Scout

Map No. _____ Sec. 8 Twp. 28 R. 4Well No. 9 Sutton Farm _____Producers Company _____

NORTH

WEST

EAST

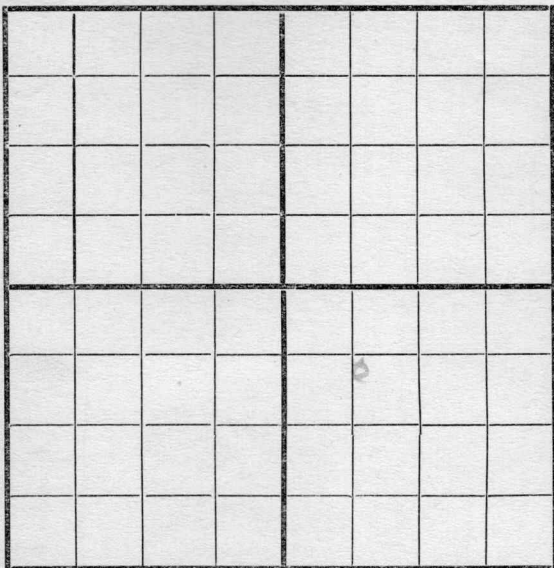

SOUTH

Location _____

Rig Up _____

Drilling and remarks

1400

RECORD

Cased _____ in. _____ Ft.

Sand _____

Gas _____

Oil _____

Total Depth _____

PRODUCTION

1st 24 hrs. Nat. _____

1st 24 hrs. after shot _____

Gas _____ Cu. Ft.

Dry Hole _____

Abandoned _____


Date

1917Cordell

Scout

Map No. _____ Sec. 8 Twp. 28 R. 4
 Well No. 92 Denton Farm _____
Producers Company _____

NORTH

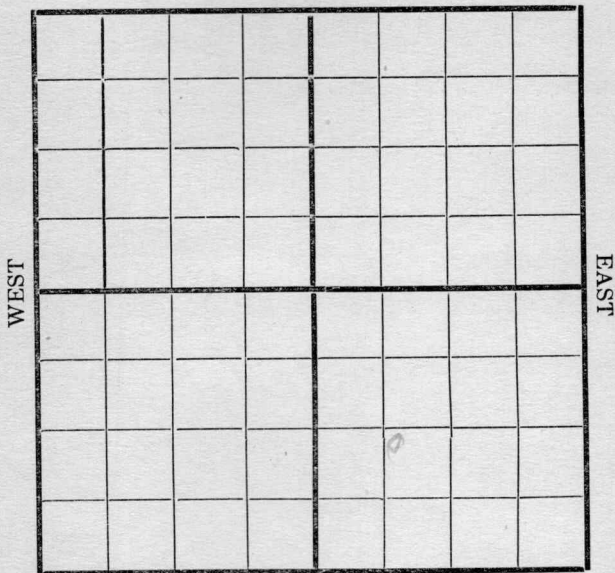

SOUTH

Location _____

Rig Up _____

Drilling and remarks

Shut Down
14.00
Rig Pulled
in

RECORD

Cased _____ in. _____ Ft.

Sand _____

Gas _____

Oil _____

Total Depth _____

PRODUCTION

1st 24 hrs. Nat. _____

1st 24 hrs. after shot _____

Gas _____ Cu. Ft.

Dry Hole _____

Abandoned _____

Date


6/27, 191 *7* *Cooley* Scout

Map No. _____ Sec. 8 Twp. 28 R. 4Well No. 92 Euton Farm _____Producers Company _____

NORTH

WEST

EAST

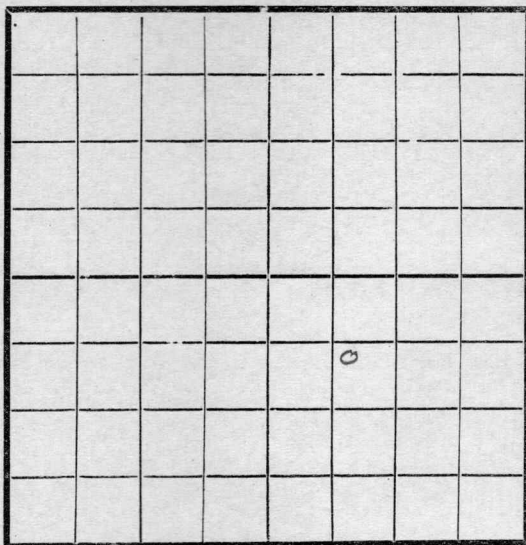

SOUTH

Location _____

Rig Up _____

Drilling and remarks

Rig Rebuilt
 Trying to pull
 10' at
 1400'

RECORD

Cased _____ in _____ Ft.

Sand _____

Gas _____

Oil _____

Total Depth _____

PRODUCTION

1st 24 hrs. Nat. _____

1st 24 hrs. after shot _____

Gas _____ Cu. Ft.

Dry Hole _____

Abandoned _____


Date

7/6, 1912 Conley Scout

Map No. _____ Sec. 8 Twp. 28 R. 4
 Well No. 9 Denton Farm _____
Producers Company _____

NORTH

WEST

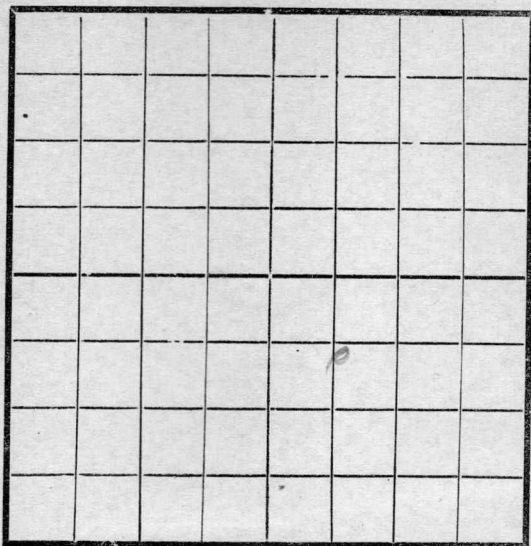

EAST

SOUTH

Location _____
 Rig Up _____
 Drilling and remarks

1565

RECORD

Cased _____ in. _____ Ft.
 Sand _____
 Gas _____
 Oil _____
 Total Depth _____

PRODUCTION

1st 24 hrs. Nat. _____
 1st 24 hrs. after shot _____
 Gas _____ Cu. Ft.
 Dry Hole _____
 Abandoned _____


Date

7/12, 1912 Cordiff Scout

Map No. _____ Sec. 8 Twp. 28 R. 4Well No. 9. Denton Farm
Producers Company

NORTH

WEST

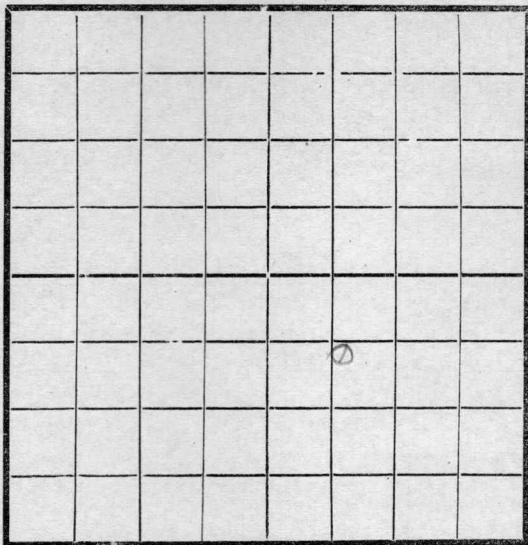

EAST

SOUTH

Location _____

Rig Up _____

Drilling and remarks

Fishing at
1575.

RECORD

Cased _____ in. _____ Ft.

Sand _____

Gas _____

Oil _____

Total Depth _____

PRODUCTION

1st 24 hrs. Nat. _____

1st 24 hrs. after shot _____

Gas _____ Cu. Ft.

Dry Hole _____

Abandoned _____

Date


8-20, 191*7* *Lang* Scout

Map No. _____ Sec. 8 Twp. 28 R. 4

Well No. 98-1-1 Farm _____
Producers Company

NORTH

WEST

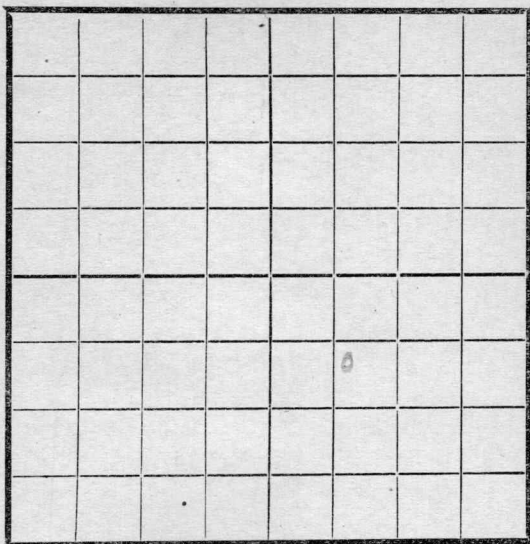

EAST

SOUTH

Location _____

Rig Up _____

Drilling and remarks

*Skipped
rig*

RECORD

Cased _____ in _____ Ft.
 Sand _____
 Gas _____
 Oil _____
 Total Depth _____

PRODUCTION

1st 24 hrs. Nat. _____
 1st 24 hrs. after shot _____
 Gas _____ Cu. Ft.
 Dry Hole _____
 Abandoned _____


Date

10/9, 1917 Early Scout

Map No. _____ Sec. 8 Twp. 28 R. 4
 Well No. 92 Denton Farm _____
Producers Company _____

NORTH

WEST

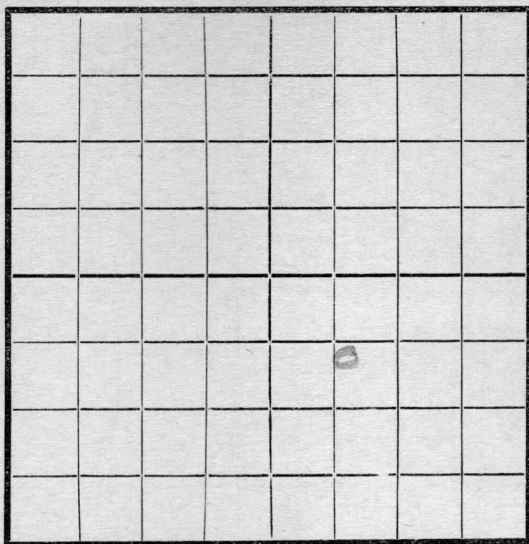

EAST

SOUTH

Location _____
 Rig Up ☒ _____
 Drilling and remarks _____

RECORD

Cased _____ in. _____ Ft.
 Sand _____
 Gas _____
 Oil _____
 Total Depth _____

PRODUCTION

1st 24 hrs. Nat. _____
 1st 24 hrs. after shot _____
 Gas _____ Cu. Ft.
 Dry Hole _____
 Abandoned _____


Date

10/17, 1917 Condy Scout

Map No. _____ Sec. 8 Twp. 28 R. 4Well No. 9 Denton Farm _____
Producers Company

NORTH

WEST

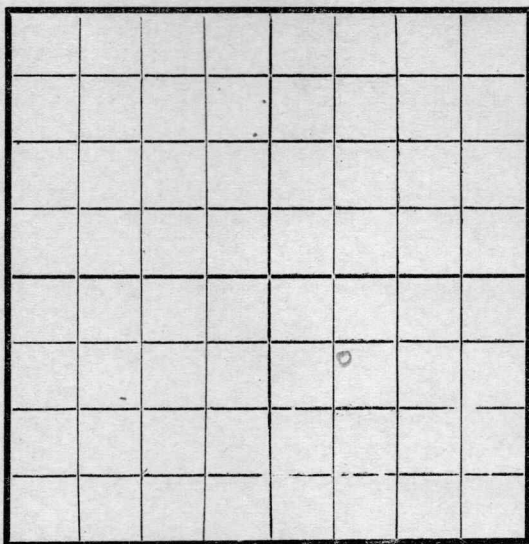

EAST

SOUTH

Location _____

Rig Up ☒ _____

Drilling and remarks _____

RECORD

Cased _____ in. _____ Ft.

Sand _____

Gas _____

Oil _____

Total Depth _____

PRODUCTION

1st 24 hrs. Nat. _____

1st 24 hrs. after shot _____

Gas _____ Cu. Ft.

Dry Hole _____

Abandoned _____


Date

10/31, 1912 C. S. D. Scout

Map No. _____ Sec. 8 Twp. 28 R. 4
Well No. 92 Denton Farm _____
Producers Company _____

NORTH

WEST

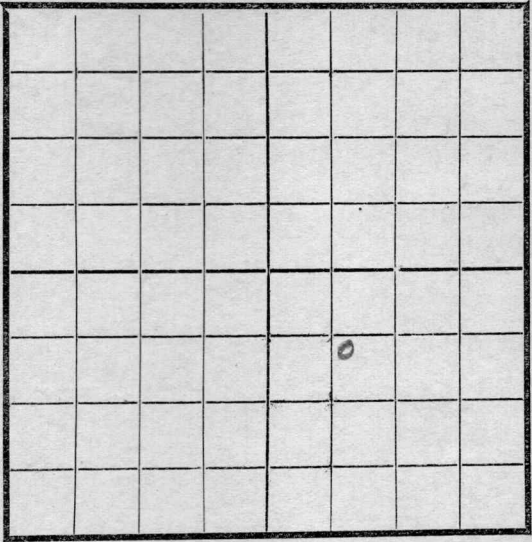

EAST

SOUTH

RECORD

Location _____
Rig Up _____
Drilling and remarks _____

Cased _____ in _____ Ft.
Sand _____
Gas _____
Oil _____
Total Depth _____

PRODUCTION

1st 24 hrs. Nat. _____
1st 24 hrs. after shot _____
Gas _____ Cu. Ft.
Dry Hole _____
Abandoned _____


Date

11-7, 1917 Condy Scout

Map No. _____ Sec. 8 Twp. 28 R. 4
 Well No. 92 Clinton Farm _____
Producers Company

NORTH

WEST

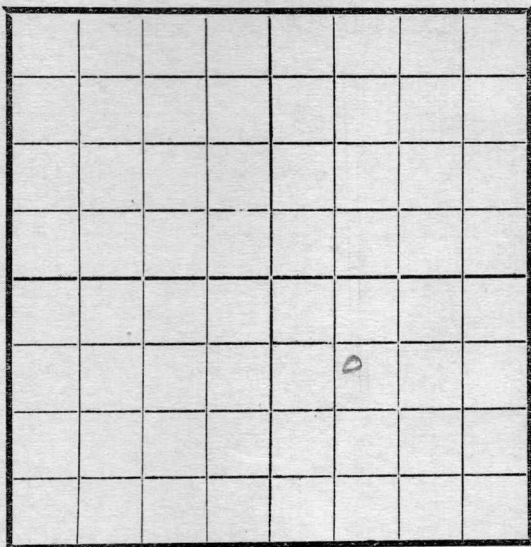

EAST

SOUTH

Location _____
 Rig Up _____
 Drilling and remarks _____

RECORD

Cased _____ in _____ Ft.
 Sand _____
 Gas _____
 Oil _____
 Total Depth _____

PRODUCTION

1st 24 hrs. Nat. _____
 1st 24 hrs. after shot _____
 Gas _____ Cu. Ft.
 Dry Hole _____
 Abandoned _____


Date

11/14, 1917 7 Cardy Scout

Map No. _____ Sec. 8 Twp. 28 R. 4Well No. 9 Denton Farm
Producers Company

NORTH

WEST

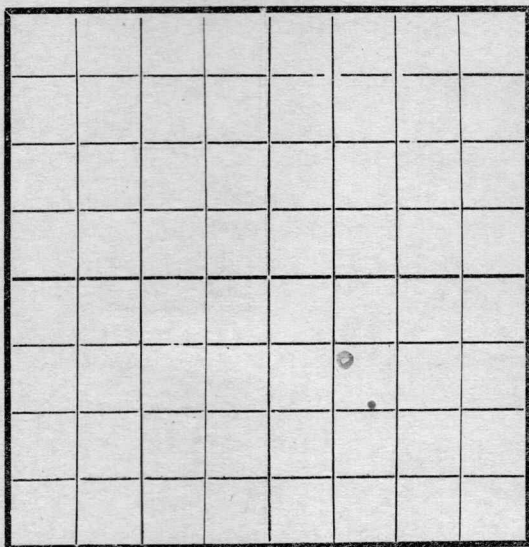

EAST

SOUTH

Location ✓Rig Up ✓

Drilling and remarks

RECORD

Cased _____ in. _____ Ft.

Sand _____

Gas _____

Oil _____

Total Depth _____

PRODUCTION

1st 24 hrs. Nat. _____

1st 24 hrs. after shot _____

Gas _____ Cu. Ft.

Dry Hole _____

Abandoned _____


Date

11/21, 1917 C. C. C. Scout

Map No. _____ Sec. 8 Twp. 28 R. 4Well No. 9 Deaton Farm _____Producers Company _____

NORTH

WEST

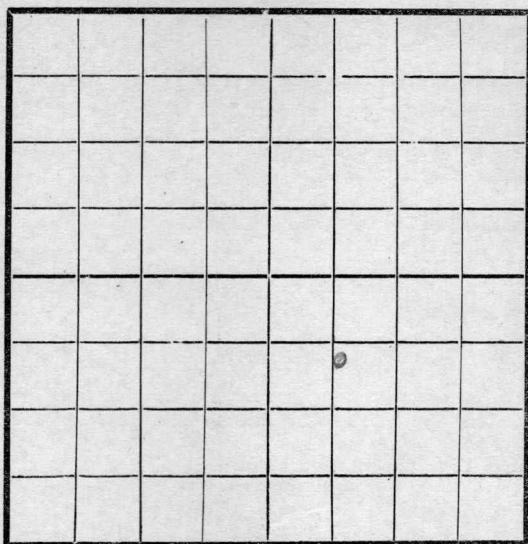

EAST

SOUTH

Location _____

Rig Up _____

Drilling and remarks _____

RECORD

Cased _____ in _____ Ft.

Sand _____

Gas _____

Oil _____

Total Depth _____

PRODUCTION

1st 24 hrs. Nat. _____

1st 24 hrs. after shot _____

Gas _____ Cu. Ft.

Dry Hole _____

Abandoned _____


Date

11/28, 1917 C. Cardiff Scout

Map No. _____ Sec. 8 Twp. 28 R. 4Well No. 9 Denton Farm _____Producers Company

NORTH

WEST

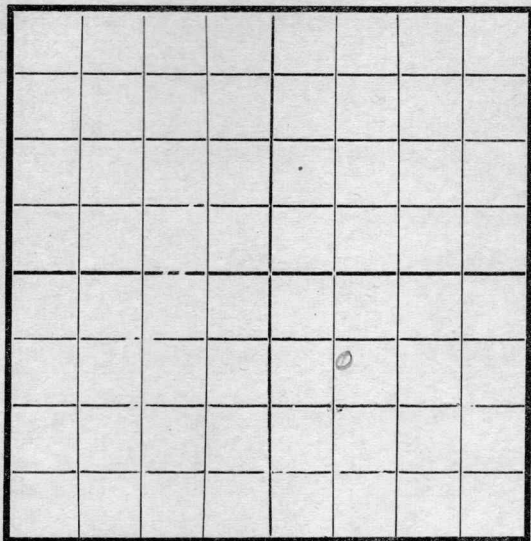

EAST

SOUTH

Location _____

Rig Up _____

Drilling and remarks _____

RECORD

Cased _____ in. _____ Ft.

Sand _____

Gas _____

Oil _____

Total Depth _____

PRODUCTION

1st 24 hrs. Nat. _____

1st 24 hrs. after shot _____

Gas _____ Cu. Ft.

Dry Hole _____

Abandoned _____


Date

12/5, 1912 C. C. Coffey Scout

Map No. _____ Sec. 8 Twp. 28 R. 4Well No. 92 Denton FarmProducers Company

NORTH

WEST

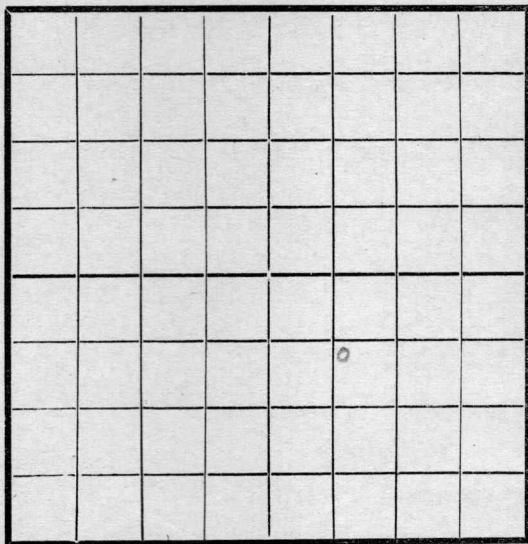

EAST

SOUTH

Location _____

Rig Up ☒ _____

Drilling and remarks _____

RECORD

Cased _____ in. _____ Ft.

Sand _____

Gas _____

Oil _____

Total Depth _____

PRODUCTION

1st 24 hrs. Nat. _____

1st 24 hrs. after shot _____

Gas _____ Cu. Ft.

Dry Hole _____

Abandoned _____


Date

12/12, 1912 Conley Scout

Map No. _____ Sec. 8 Twp. 28 R. 4Well No. 9 Denton FarmPrudhoe Company

NORTH

WEST

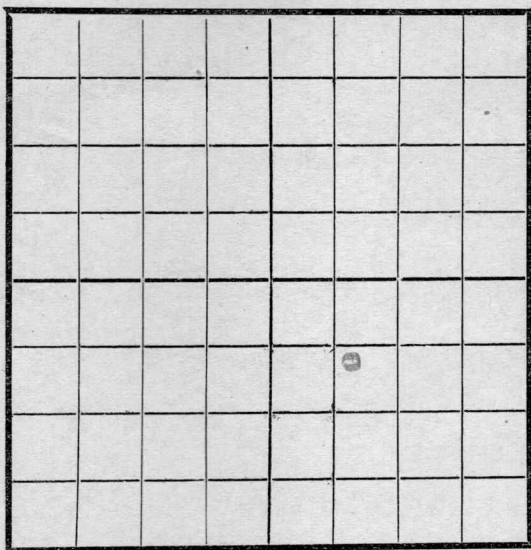

EAST

SOUTH

Location _____

Rig Up ✓ _____

Drilling and remarks _____

RECORD

Cased _____ in. _____ Ft.

Sand _____

Gas _____

Oil _____

Total Depth _____

PRODUCTION

1st 24 hrs. Nat. _____

1st 24 hrs. after shot _____

Gas _____ Cu. Ft.

Dry Hole _____

Abandoned _____


Date

12/19, 1917 Carley Scout

Map No. _____ Sec. 8 Twp. 28 R. 4
 Well No. 92 Denton Farm _____
Producers Company _____

NORTH

WEST

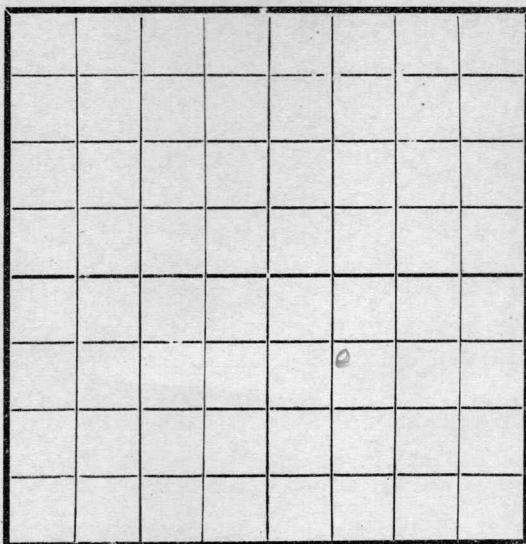

EAST

SOUTH

Location _____
 Rig Up ☒ _____
 Drilling and remarks _____

RECORD

Cased _____ in. _____ Ft.
 Sand _____
 Gas _____
 Oil _____
 Total Depth _____

PRODUCTION

1st 24 hrs. Nat. _____
 1st 24 hrs. after shot _____
 Gas _____ Cu. Ft.
 Dry Hole _____
 Abandoned _____


Date

1/2, 1918 Cardiff Scout

Map No. _____ Sec. 8 Twp. 38 R. 4Well No. 98 Section Farm _____Producers Company _____

NORTH

WEST

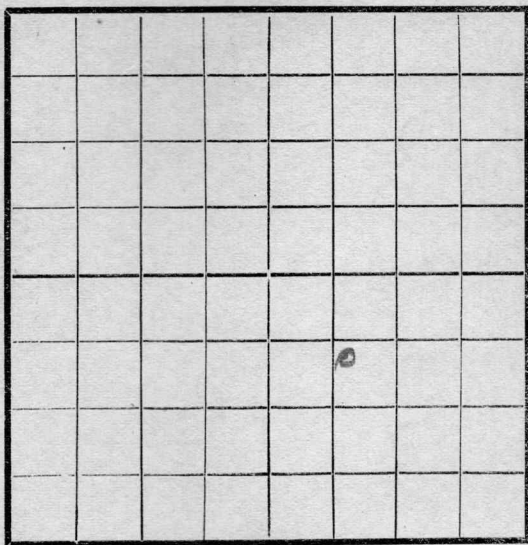

EAST

SOUTH

Location ✓

Rig Up _____

Drilling and remarks _____

RECORD

Cased _____ in. _____ Ft.

Sand _____

Gas _____

Oil _____

Total Depth _____

PRODUCTION

1st 24 hrs. Nat. _____

1st 24 hrs. after shot _____

Gas _____ Cu. Ft.

Dry Hole _____

Abandoned _____


Date

1/16, 1918 Candey Scout

Map No. _____ Sec. 8 Twp 38 R. 4Well No. 92 Clinton Farm _____
Producers Company

NORTH

WEST

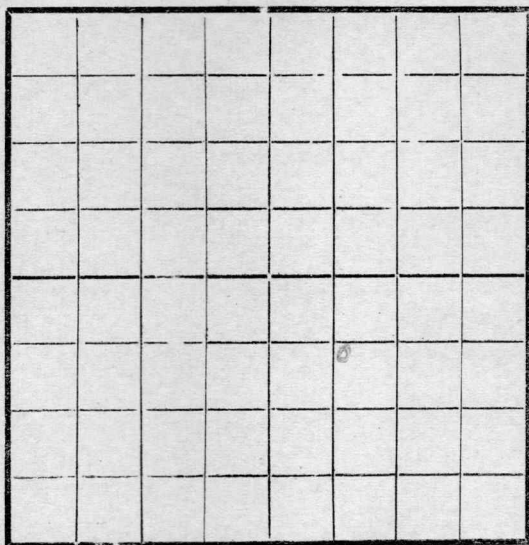

EAST

SOUTH

Location _____

Rig Up _____

Drilling and remarks

Spudding

RECORD

Cased _____ in. _____ Ft.

Sand _____

Gas _____

Oil _____

Total Depth _____

PRODUCTION

1st 24 hrs. Nat. _____

1st 24 hrs. after shot _____

Gas _____ Cu. Ft.

Dry Hole _____


Abandoned _____

Date

1/30, 1918 C. Condiff Scout

Map No. _____ Sec. 8 Twp. 28 R. 4Well No. 9 Denton Farm
Fairview 240 CompanyProducers NORTH

WEST

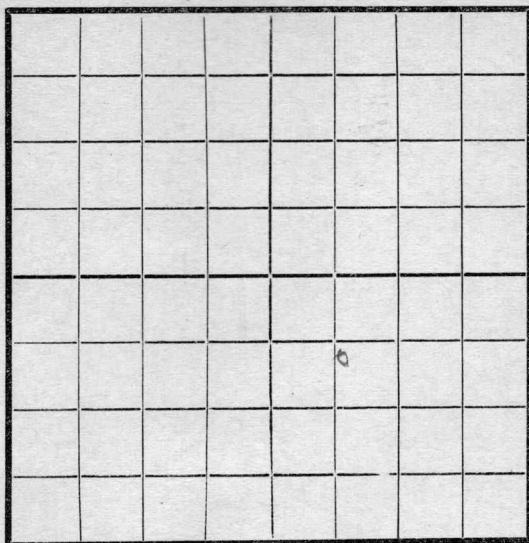

EAST

SOUTH

Location _____

Rig Up _____

Drilling and remarks

22 100'

RECORD

Cased _____ in. _____ Ft.

Sand _____

Gas _____

Oil _____

Total Depth _____

PRODUCTION

1st 24 hrs. Nat. _____

1st 24 hrs. after shot _____

Gas _____ Cu. Ft.

Dry Hole _____

Abandoned _____


Date

2/13, 1918 Cordiff Scout

Map No. _____ Sec. 8 Twp. 28 R. 4Well No. 9 Denton Farm _____
Fairview 0915 Company _____

NORTH

WEST

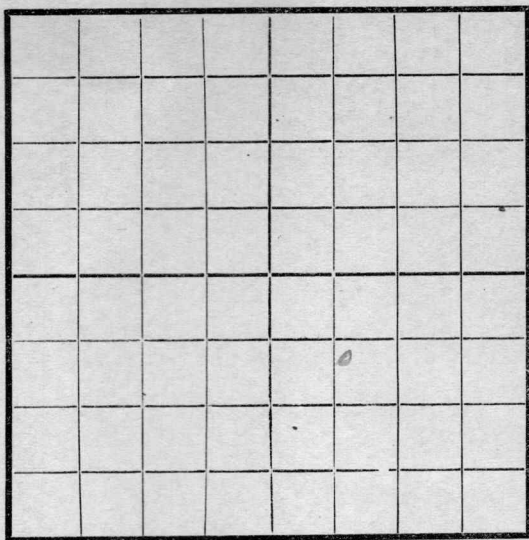

EAST

SOUTH

Location _____

Rig Up _____

Drilling and remarks

*Graded
in*

RECORD

Cased _____ in. _____ Ft.

Sand _____

Gas _____

Oil _____

Total Depth _____

PRODUCTION

1st 24 hrs. Nat. _____

1st 24 hrs. after shot _____

Gas _____ Cu. Ft.

Dry Hole _____

Abandoned _____

Date

3/20, 1918 Scout

Map No. _____ Sec. 8 Twp. 28 R. 4


Well No. 9 Deer Run Farm

Fairview Oil Co Company

NORTH

WEST

EAST

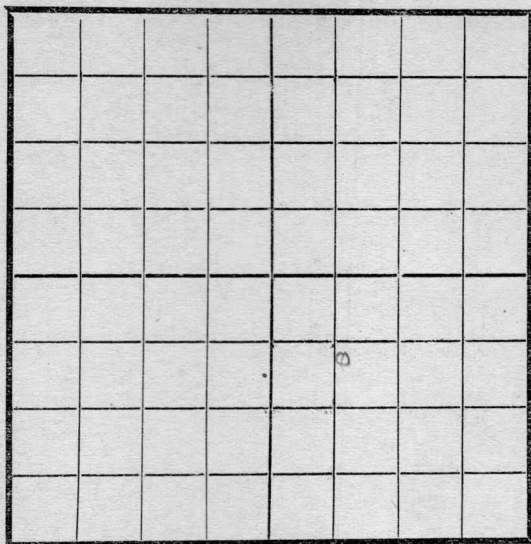

SOUTH

Location _____

Rig Up _____

Drilling and remarks

RECORD

Cased _____ in. _____ Ft.

Sand _____

Gas _____

Oil _____

Total Depth _____

PRODUCTION

1st 24 hrs. Nat. _____

1st 24 hrs. after shot _____

Gas _____ Cu. Ft.

Dry Hole _____

Abandoned _____


Date

3/27, 1918 Scout

Map No. _____ Sec. 8 Twp. 28 R. 4Well No. 9 Denton Farm
Fairview 093 Company

NORTH

WEST

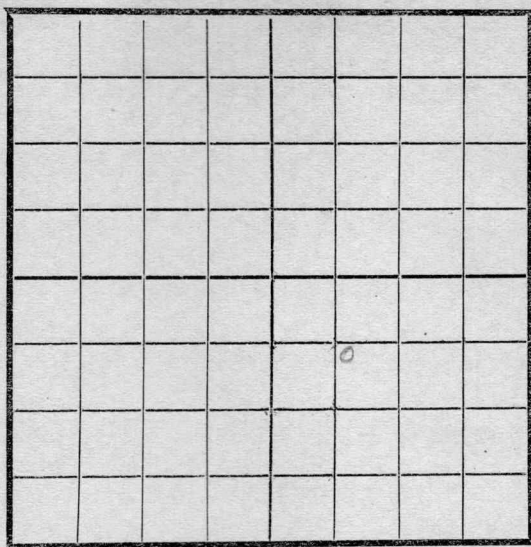

EAST

SOUTH

Location _____

Rig Up _____

Drilling and remarks

22150

RECORD

Cased _____ in. _____ Ft.

Sand _____

Gas _____

Oil _____

Total Depth _____

PRODUCTION

1st 24 hrs. Nat. _____

1st 24 hrs. after shot _____

Gas _____ Cu. Ft.

Dry Hole _____

Abandoned _____


Date

3/6, 1918 Scout

Map No. _____ Sec. 8 Twp. 28 R. 4Well No. 92 Centon Farm _____
Fairview O & S Company

NORTH

WEST

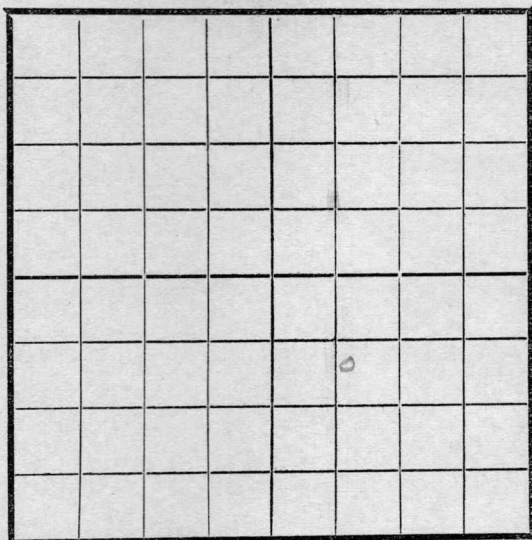

EAST

SOUTH

Location _____

Rig Up _____

Drilling and remarks

12150

RECORD

Cased _____ in. _____ Ft.

Sand _____

Gas _____

Oil _____

Total Depth _____

PRODUCTION

1st 24 hrs. Nat. _____

1st 24 hrs. after shot _____

Gas _____ Cu. Ft.

Dry Hole _____

Abandoned _____


Date

3/20, 1918 C. C. C. C. Scout

Map No. _____ Sec. 8 Twp. 28 R. 4Well No. 92411111 Farm _____Fairview Company _____

NORTH

WEST

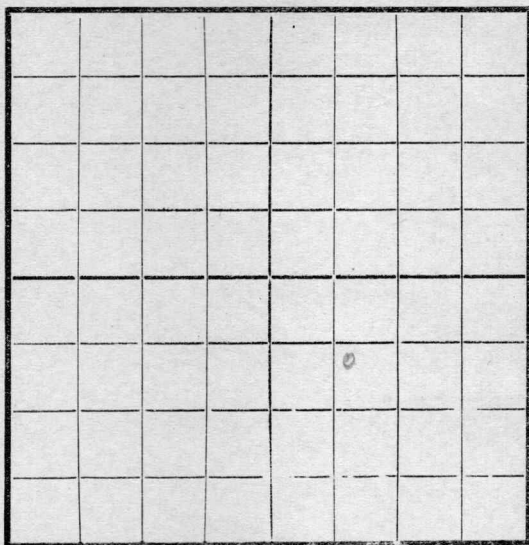

EAST

SOUTH

Location _____

Rig Up _____

Drilling and remarks

22 150

RECORD

Cased _____ in. _____ Ft.

Sand _____

Gas _____

Oil _____

Total Depth _____

PRODUCTION

1st 24 hrs. Nat. _____

1st 24 hrs. after shot _____

Gas _____ Cu. Ft.

Dry Hole _____

Abandoned _____

Date

APR 3 1918


, 191

Candry Scout

Map No. _____ Sec. 8 Twp. 28 R. 4Well No. 92 Clinton Farm _____Fairview Oil Company _____

NORTH

WEST

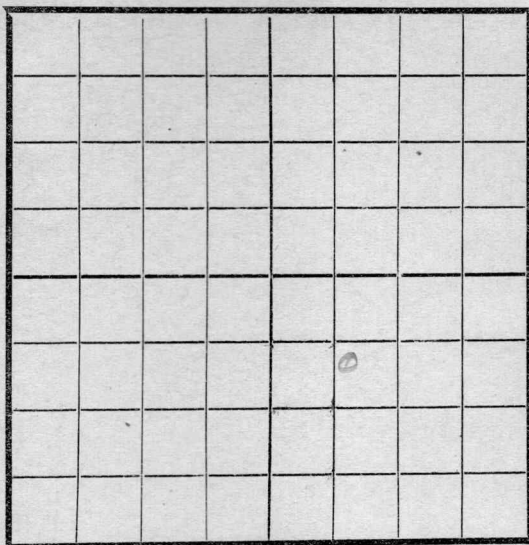

EAST

SOUTH

Location _____

Rig Up _____

Drilling and remarks

22 150

RECORD

Cased _____ in. _____ Ft.

Sand _____

Gas _____

Oil _____

Total Depth _____

PRODUCTION

1st 24 hrs. Nat. _____

1st 24 hrs. after shot _____

Gas _____ Cu. Ft.

Dry Hole _____

Abandoned _____


Date

4/17, 1918 C. C. C. Co. Scout _____

Map No. _____ Sec. 8 Twp. 28 R. 4Well No. 9 Denton FarmLaurie Oil & Gas Company

NORTH

WEST

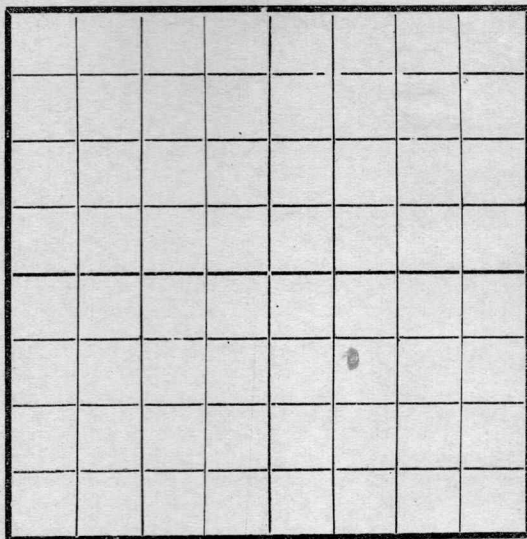

EAST

SOUTH

Location _____

Rig Up _____

Drilling and remarks

450Buffalo Drill
Co
August 1911

RECORD

Cased _____ in. _____ Ft.

Sand _____

Gas _____

Oil _____

Total Depth _____

PRODUCTION

1st 24 hrs. Nat. _____

1st 24 hrs. after shot _____

Gas _____ Cu. Ft.

Dry Hole _____

Abandoned _____


Date

57, 1911 S. C. Candy Scout

Map No. _____ Sec. 8 Twp. 28 R. 4
 Well No. 9 Denton Farm _____
Fairview Oil & Gas Company

NORTH

WEST

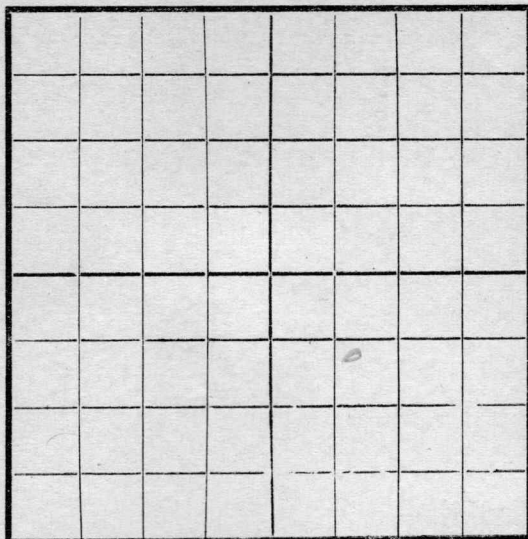

EAST

SOUTH

Location _____
 Rig Up _____
 Drilling and remarks

760

Buffalo Drilling
Co

RECORD

Cased _____ in. _____ Ft.
 Sand _____
 Gas _____
 Oil _____
 Total Depth _____

PRODUCTION

1st 24 hrs. Nat. _____
 1st 24 hrs. after shot _____
 Gas _____ Cu. Ft.
 Dry Hole _____
 Abandoned _____


Date

78, 191 S. C. C. Co. Scout

Map No. _____ Sec. 8 Twp 28 R. 4Well No. 9 Denton Farm _____
Fairview Company

NORTH

WEST

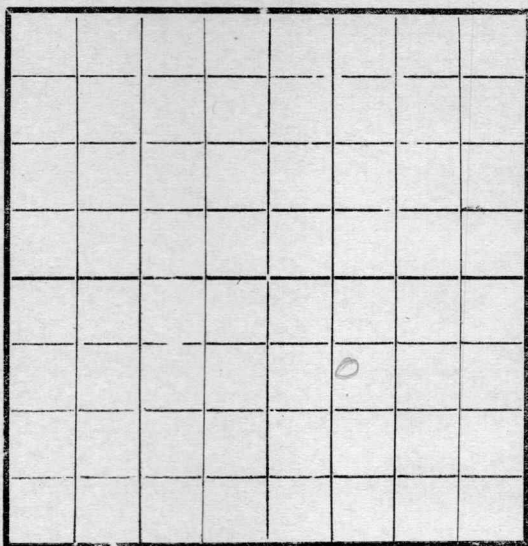

EAST

SOUTH

Location _____

Rig Up _____

Drilling and remarks

900

RECORD

Cased _____ in. _____ Ft.

Sand _____

Gas _____

Oil _____

Total Depth _____

PRODUCTION

1st 24 hrs. Nat. _____

1st 24 hrs. after shot _____

Gas _____ Cu. Ft.

Dry Hole _____

Abandoned _____


Date

5/15, 1918 Scout

Map No. _____ Sec. 8 Twp. 38 R. 4Well No. 92 section Farm _____Company Fairview Oils

NORTH

WEST

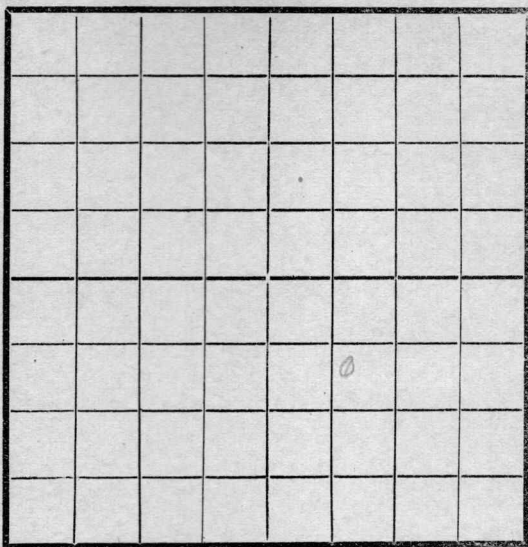

EAST

SOUTH

Location _____

Rig Up _____

Drilling and remarks

1450

RECORD

Cased _____ in. _____ Ft.

Sand _____

Gas _____

Oil _____

Total Depth _____

PRODUCTION

1st 24 hrs. Nat. _____

1st 24 hrs. after shot _____

Gas _____ Cu. Ft.

Dry Hole _____

Abandoned _____

Date

5/22, 1918 Candiff Scout


Map No. _____ Sec. 8 Twp. 28 R. 4

Well No. 92 Deer Run Farm
Facinier Bros Company

NORTH

WEST

EAST

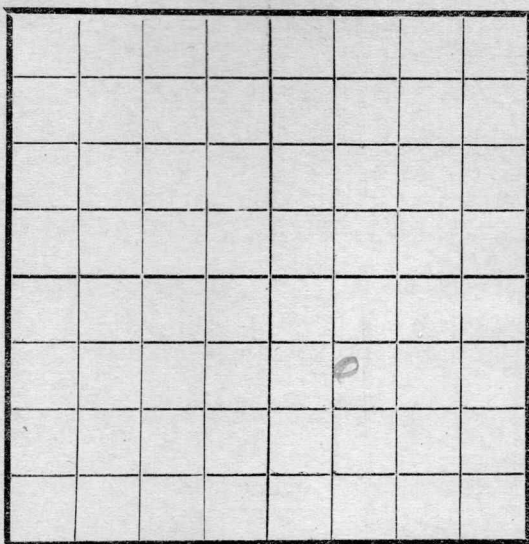

SOUTH

Location _____

Rig Up _____

Drilling and remarks

RECORD

Cased _____ in. _____ Ft.

Sand _____

Gas _____

Oil _____

Total Depth _____

PRODUCTION

1st 24 hrs. Nat. _____

1st 24 hrs. after shot _____

Gas _____ Cu. Ft.

Dry Hole _____

Abandoned _____

Date


5/29, 1918 S. Conroy Scout

Map No. _____ Sec. 8 Twp. 38 R. 4

Well No. 9 Denton Farm
Fairview 292 Company

NORTH

WEST

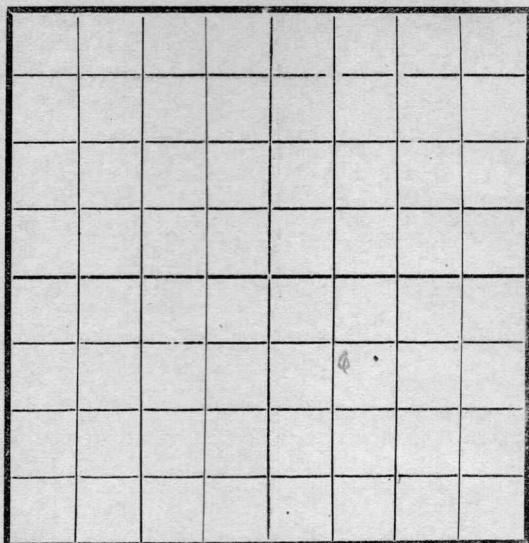

EAST

SOUTH

Location _____

Rig Up _____

Drilling and remarks

1980

RECORD

Cased _____ in. _____ Ft.

Sand _____

Gas _____

Oil _____

Total Depth _____

PRODUCTION

1st 24 hrs. Nat. _____

1st 24 hrs. after shot _____

Gas _____ Cu. Ft.

Dry Hole _____

Abandoned _____

Date

6/5

, 191

J. C. Caudy

Scout

Map No. _____ Sec. 8 Twp. 38 R. 4Well No. 9 DentonFairview 885 Company _____

Contractor _____

NORTH

WEST

EAST

SOUTH

Location _____

Rig up _____

Drilling and Remarks:

2250

RECORD

Cased _____ in., _____ ft.

Sand _____

Gas _____

Oil _____

Total Depth _____

PRODUCTION

1st 24 hrs. Nat. _____

1st 24 hrs. after shot _____

Gas _____ Cu. Ft.

Dry Hole _____

Abandoned _____


Date

6/12 191 8 Cradley Scout

Map No. _____ Sec. 8 Twp. 28 R. 4Well No. 92 Section
Fairview 095 Company _____

Contractor _____

NORTH

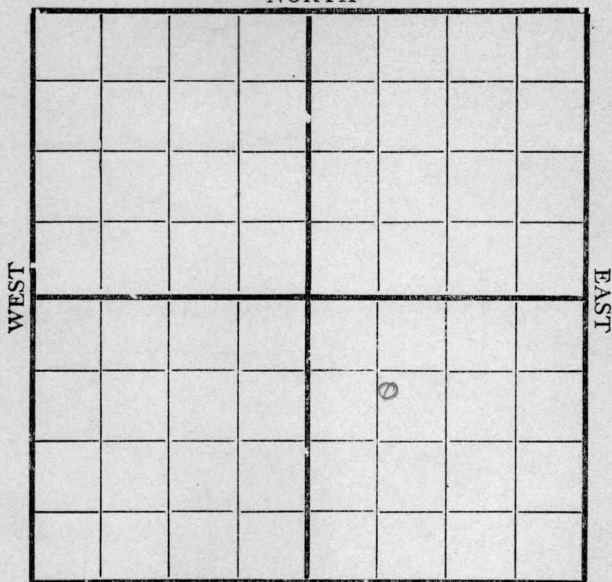

SOUTH

Location _____

Rig up _____

Drilling and Remarks:

2426

RECORD

Cased _____ in., _____ ft.

Sand _____

Gas _____

Oil _____

Total Depth _____

PRODUCTION

1st 24 hrs. Nat. _____

1st 24 hrs. after shot _____

Gas _____ Cu. Ft.

Dry Hole _____

Abandoned _____

Date

6/19 1918 Conley Scout

Map No. _____ Sec. 8 Twp. 28 R. 4Well No. 92 DentonFairview Oil Co. Company

Contractor _____

NORTH

WEST

EAST

SOUTH

Location _____

Rig up _____

Drilling and Remarks:

2437

RECORD

Cased _____ in., _____ ft.

Sand _____

Gas _____

Oil _____

Total Depth _____

PRODUCTION

1st 24 hrs. Nat. _____

1st 24 hrs. after shot _____

Gas _____ Cu. Ft.

Dry Hole _____

Abandoned _____

Date

4/27 1918 C. C. C. C. Scout

1002 K 11 8 28 4
 Map No. _____ Sec. _____ Twp. _____ R. _____


Well No. 92 enton _____

Fairview Oil Co. _____ Company

Buffalo Drilling Co. _____ Contractor

Augusta NORTH 750

WEST

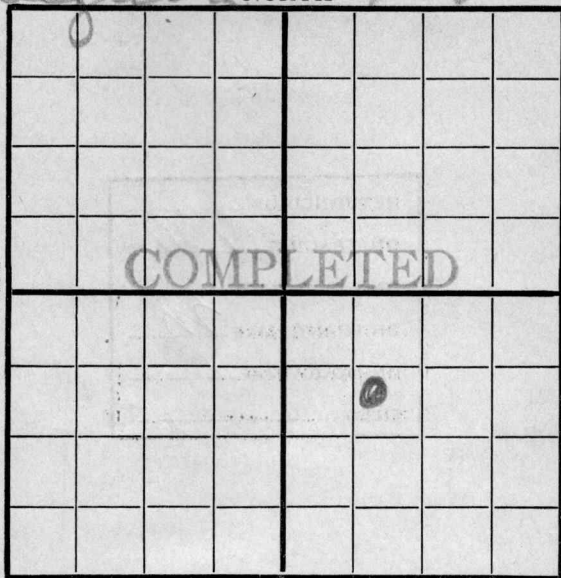

EAST

SOUTH

Location _____

Rig up _____

Drilling and Remarks:

Est at 10 bbls
 Drilled to 2437
 Plugged back
 to 2424

RECORD

Cased _____ in., _____ ft.

Sand 2412-2416

Gas _____

Oil _____

Total Depth 2437

PRODUCTION

1st 24 hrs. Nat. _____

1st 24 hrs. after shot _____

Gas _____ Cu. Ft.

Dry Hole _____

Abandoned _____

Date

7/2 1918 Condy Scout