


Section 8 Township 28 Range 4E

Well No. 3 Haines

Company Dunn & Strait

Misc.  
NORTH

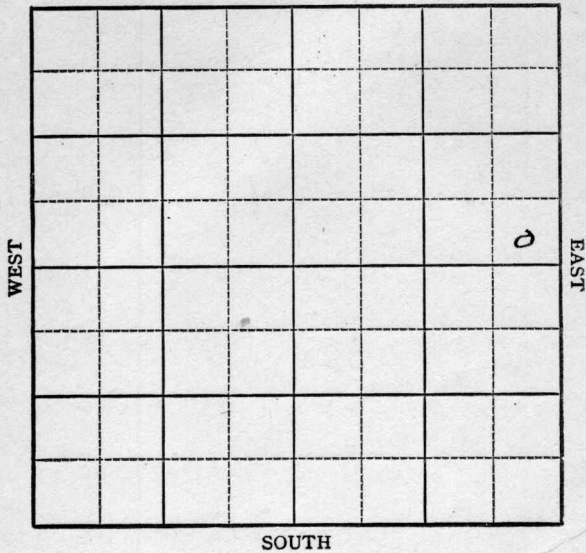

KANSAS


Butler

Sec. 8 Twp. 28 R. 4E ✓

Well No. #3 Haines Farm  
Dunn & Strait Company

Miscellaneous

\_\_\_\_\_ Ft. from N. Line  
330' Ft. from S. Line  
330' Ft. from E. Line  
\_\_\_\_\_ Ft. from W. Line

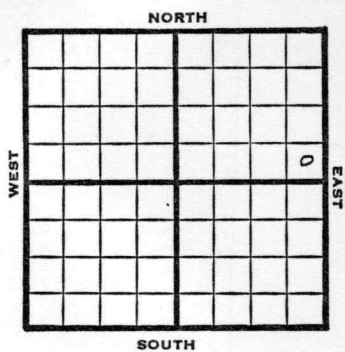

SE NE

1949 Elev 1208' REPORT

1/12 8" @ 80'  
Drlg. 940'  
1/19 TD 2110'  
1/26 TD 2400 SD  
2/2 "  
2/9 Arbuckle 2500-05'  
TD 2505'  
5" @ 2495'  
2/16 "  
2/23 "  
3/2 "  
3/8 "  
3/16 "  
3/23 "  
3/30 "  
4/6 "  
4/12 "  
4/20 "  
4/27 "  
5/4 TD 2612'  
300 oil 12 hrs.  
5/11 TD 2514 (Corrected)  
Arb. 2500'  
5" @ 2495'  
Pump 25 Oil Pot  
38° Gr,  
Comp

COMPLETED

Map No. \_\_\_\_\_ Sec. 8 Twp. 28 R. 4E

Well No. 3 Haines

Dunn & Strait Company

FIRST REPORT Contractor

SE NE

SECTION PLAT

\_\_\_\_\_ Ft. from N. Line

330 Ft. from S. Line

330 Ft. from E. Line

\_\_\_\_\_ Ft. from W. Line

			o

Butler County

Location \_\_\_\_\_

Rig up \_\_\_\_\_

Drilling and Remarks:

8" @ 80'

drlg. 940

RECORD

Cased \_\_\_\_\_ in., \_\_\_\_\_ ft.

Sand \_\_\_\_\_

Gas \_\_\_\_\_

Oil \_\_\_\_\_

Total Depth \_\_\_\_\_

PRODUCTION

1st 24 hrs. Nat. \_\_\_\_\_

1st 24 hrs. after shot \_\_\_\_\_

Gas \_\_\_\_\_ Cu. Ft.

Dry Hole \_\_\_\_\_

Abandoned \_\_\_\_\_

Date

JAN 12 1949

19

S. J. LEWIS

Scout

