


Greenwood
 Map No. **KANSAS** Sec. 11 Twp. 24 R. 12^E
 Well No. 2 - Hunt Farm
 Houston - Okla Oil Company

NORTH

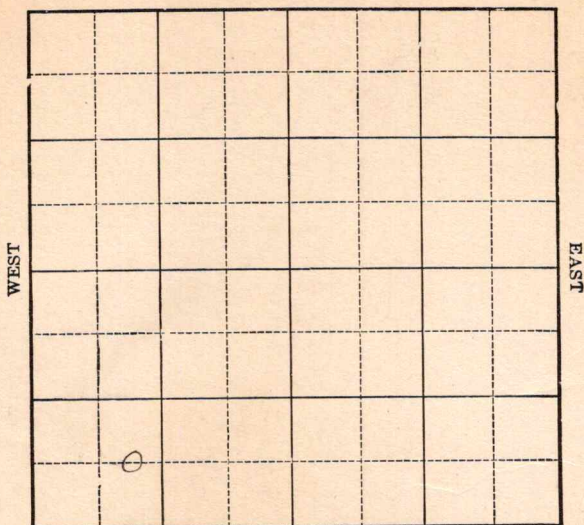

SOUTH

Location _____

Drilling Remarks

Rig Up _____

Drilling Remarks

RECORD

Cased _____ in. _____ ft.

Sand _____

Gas _____

Oil _____

Total Depth _____

PRODUCTION

1st 24 hrs. Nat. _____

1st 24 hrs. after shot _____

Gas _____ cu. ft.

Dry Hole _____


Abandoned _____

Map No. **KANSAS** Sec. 11 Twp. 24 R. 12^E

Well No. 2 Hout Farm

Houston - Okla. Oil Company

NORTH

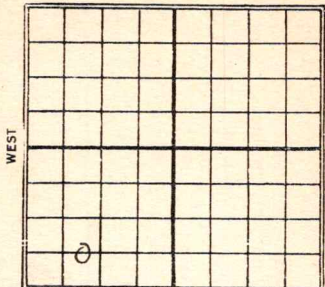

_____ Ft. from N. Line

660 Ft. from S. Line

250 Ft. from E. Line

_____ Ft. from W. Line

SOUTH

1929

Date

REPORT

10/23	Drill 1270'
10/30	" 1535'
11/6	Top line 1694'
	Pay 1720-31'
	T.D. 1731'
	shot 40 gts
	70 bbls oil
	comp.

16 **KANSAS** Sec. 11 Twp. 24 R. 12^E

Well No. 2 Hunt
Houston - Okla Oil Co Company

Contractor

FIRST REPORTS

SECTION PLAT

.....Ft. from N. Line

660 Ft. from S. Line

750 Ft. from E. Line

.....Ft. from W. Line

0			

Location.....

Rig up.....

Drilling and Remarks:

dy 1270'

RECORD

Cased.....in.,ft.

Sand.....

Gas.....

Oil.....

Total Depth.....

PRODUCTION

1st 24 hrs. Nat.....

1st 24 hrs. after shot.....

Gas.....Cu. Ft.

Dry Hole.....

Abandoned.....

Date

OCT 23 1929

CHAS. L. SHERWOOD

192.....Scout

Barnwood

 16
 Map No. **KANSAS** Sec. 11 Twp. 24 R. 12

Well No. 2 Hunt

Houston-Okl Oil Co Company

Contractor

COMPLETE**SECTION PLAT**

Ft. from N. Line

648 Ft. from S. Line

700 Ft. from E. Line

Ft. from W. Line

Location

Rig up

Drilling and Remarks:

Top line 1694

40/70 Bbs.

RECORD

Cased in., ft.

Sand 1720-1731

Gas

Oil

Total Depth 1731

PRODUCTION

1st 24 hrs. Nat.

1st 24 hrs. after shot

Gas Cu. Ft.

Dry Hole

Abandoned

Date

NOV 6 1929

192

CHAS. L. SHERWOOD

Scout