


Butler

KANSAS

SECTION 8 TOWNSHIP 28 RANGE 4E

WELL NO. #3 West Haines


COMPANY Strait Drlg.

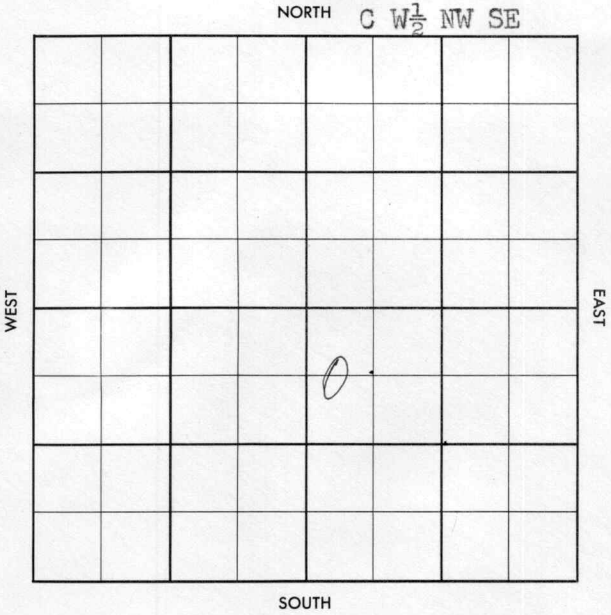

County	Butler		Elev.		Co.	
Sec.	8	Twp.	28	Rge.		4E
Company	Strait Drlg.					
Farm Name	West Haines			No.		3

TOPS	DEPTH	LOG	DATUM	Loc. in Sec.	Lse.
Anh.				C W $\frac{1}{2}$ NW SE	
TP.					
H.					
Tr.					
Dg.					
Bl.					
L.				Geol.	
K.C.				Contr.	
B.K.C.				Co. tools	
Ce.				Pool	
C.				A ugusta	
M.					
M.					
K.					
Mz.					
Me.					
V.					
S.					
S.					
A.					
R.					
Pe.					
G.					
T.D.					

Date Comm. 1-19-57
 13" @ 700 drlg. 880

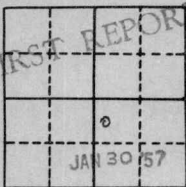

29

Co.

Lse.

No.

Sec.

T.

R.

County Butler Elev. 1284Sec. 8 Twp. 28 Rge. 4ECompany Strait Drlg.Farm Name West Haines No. 3

TOPS	DEPTH	LOG	DATUM	Loc. in Sec.
Anh.				
Tp.				C W $\frac{1}{2}$ NW SE
H.				
Tr.				
Dg.				
BL.				
L.	1715			
K.C.	2006			Geol.
B.K.C.				Cantr.
Ce.				Co. tools
C.				Pool
M.				A ugusta
M.				COMPLETE
K.				
Mz.				
Mq.				
V.				
S.				
S.				
A.	2428			
R.				
PE.				
G.				
T.D.	2431			FEB 27 '57

Date Comm. 1-19-5713" @ 700 drlg. 880 FEB 6 '57 Φ 1500FEB 13 '57 10" 1676 Φ 2340 FEB 20 '57

7" 2430 co 2431 no show

27 '57 $\frac{1}{12}$ P. 25 Bopd +

25 Bwpd.