

LOCATION NOTICE

TULSA, OKLA. 12-26-22, 19

To Mr. Lloyd Snyder,

ADDRESS Arkansas City, Kansas.

Cosden Oil & Gas Company


WILL DRILL A WELL AS

DESCRIBED BELOW, AND THIS NOTICE WILL BE YOUR AUTHORITY FOR COMMENCEMENT OF WORK.

THE LOCATION WILL BE ON J. W. Hout FARM

IN E2 of SW4 OF SECTION 11 TOWNSHIP 24S RANGE 12E

Greenwood COUNTY, STATE OF Kansas.

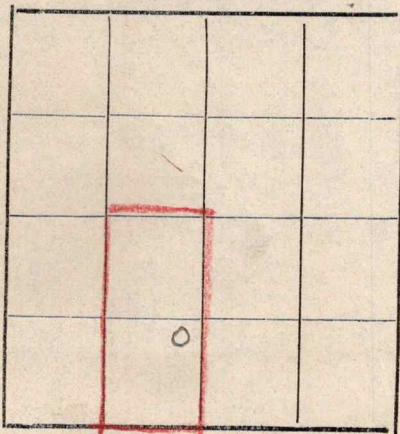

WELL NO. 2

FEET FROM NORTH LINE

FEET FROM EAST LINE

200

FEET FROM SOUTH LINE

1120

FEET FROM WEST LINE

REMARKS: 400 feet South of Well #1.

APE #

(SIGNED)

COPIES TO

ACCOUNTING DEPT.
 ENGINEERING DEPT.
 LEGAL DEPT.
 RENTAL DEPT.
 SCOUTING DEPT. ✓