

Sec. 11 Twp. 24 Range 12E

#2 J.W. Hout

Kansas Geological Society


Cosden Oil & Gas

Skelly Scout Tickets

Well No. J.W. Hunt #2 Farm

W. C. C. Co. Company

LOG

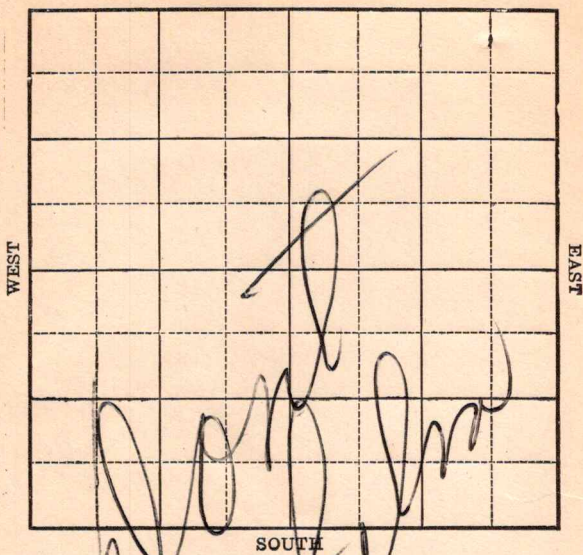

Drilling Remarks:	Drilling Remarks:
-------------------	-------------------

PRODUCTION

Total Depth _____ Abandoned _____

Abandoned _____

Map No. _____ Sec. 11 Twp. 24^S R. 12^EWell No. 2 J. W. Hunt Farm _____
Cosden Oil & Gas Company _____


NORTH

_____ Ft. from N. Line

1120 Ft. from S. Line200 Ft. from E. Line

_____ Ft. from W. Line

WEST

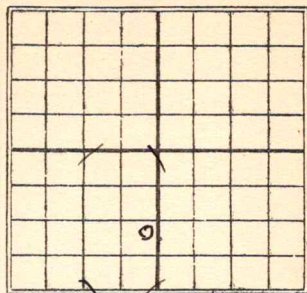

EAST

SOUTH

Date

REPORT

192212/2619233/2Location (N).Sand 1708-27. Shot 70
qts. 20 Bbl.

Map No. **KANSAS 16** Sec. **11** Twp. **24** R. **12**

Well No. **2 Hunt**

Cosden O & G. Company

Contractor

FIRST REPORT

_____ Ft. from N. Line

1120 Ft. from S. Line

200 Ft. from E. Line

_____ Ft. from W. Line

SECTION PLAT

Location _____

Rig up _____

Drilling and Remarks:

Machine

RECORD

Cased _____ in., _____ ft.

Sand _____

Gas _____

Oil _____

Total Depth _____

PRODUCTION

1st 24 hrs. Nat. _____

1st 24 hrs. after shot _____

Gas _____ Cu. Ft.

Dry Hole _____

Abandoned _____

Date

JAN 6 1923 191 _____

M. A. BENEAR

Scout

Map No. **KANSAS 16** Sec. **11** Twp. **24** R. **12**Well No. **2 Hawk**
Gas d.w. O & B. Company

Contractor

COMPLETED SECTION PLAT

	0		

Ft. from N. Line

1120 Ft. from S. Line**200** Ft. from E. Line

Ft. from W. Line

Location

Rig up

Drilling and Remarks:

Tap 1. 1695
Pay 1708-1727
70/20 lbs.

RECORD

Cased _____ in., _____ ft.

Sand _____

Gas _____

Oil _____

Total Depth _____

PRODUCTION

1st 24 hrs. Nat. _____

1st 24 hrs. after shot _____

Gas _____ Cu. Ft.

Dry Hole _____

Abandoned _____

Date

M. A. BENEAR**MAR 2 1923**

191

Scout