


Map No. _____ Sec. 8 Twp. 28 R. 4Well No. 13 Ralston Farm _____
Cont Empire (KGS DRL) Company

NORTH

WEST

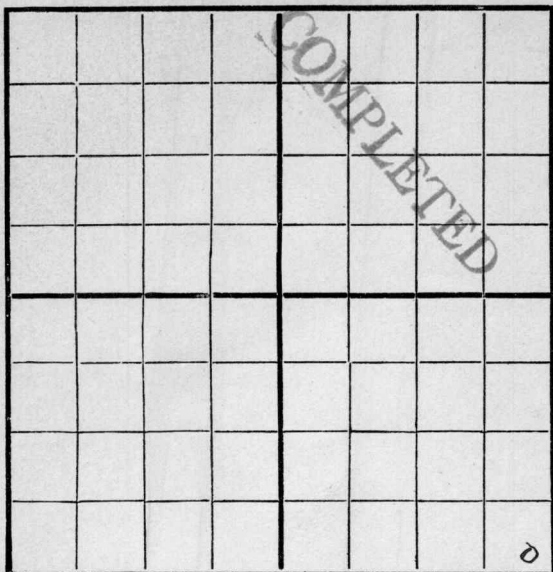

EAST

SOUTH

Location _____

Rig Up _____

Drilling Remarks:

Drilling Remarks:

6/30-13207/26 Completed to top of sand, 2390'10/2- Drilling in10/9- Preparing to Drill in10/17-10/23-11/9-

RECORD

Cased _____ in _____ Ft.

Sand 2385-2407

Gas _____

Oil _____

Total Depth _____

PRODUCTION

1st 24 hrs. Nat. 160

1st 24 hrs. after shot _____

Gas _____ Cu. Ft.

Dry Hole _____


Abandoned _____

Map No. _____ Sec. 8 Twp. 28 R. 4
 Well No. 13 Rolston Farm _____
Court Company _____

NORTH

WEST

EAST

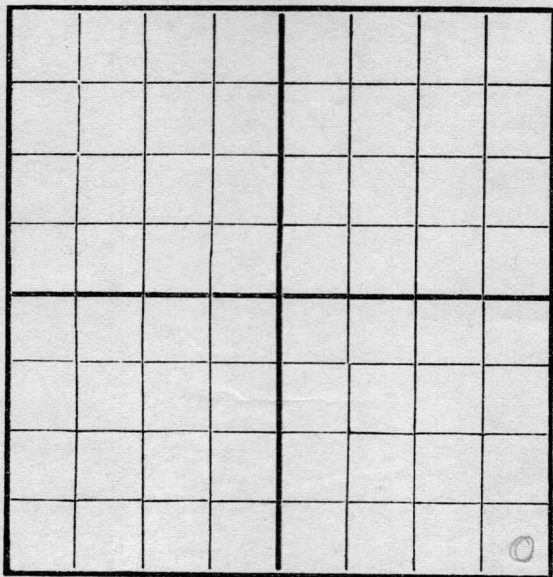

SOUTH

Location _____
 Rig Up _____
 Drilling and remarks _____

1320

RECORD

Cased _____ in. _____ Ft.
 Sand _____
 Gas _____
 Oil _____
 Total Depth _____

PRODUCTION

1st 24 hrs. Nat. _____
 1st 24 hrs. after shot _____
 Gas _____ Cu. Ft.
 Dry Hole _____
 Abandoned _____

Date


6/30, 1916 Rollston Scout

Map No. _____ Sec. 8 Twp. 28 R. 4
 Well No. 13 Palston Farm _____
Amphine Company _____

NORTH

WEST

EAST

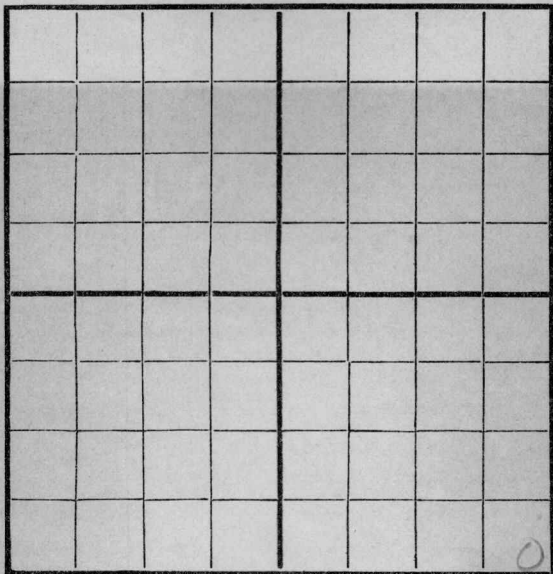

SOUTH

Location _____

Rig Up _____

Drilling and remarks

1320'

RECORD

Cased _____ in. _____ Ft.

Sand _____

Gas _____

Oil _____

Total Depth _____

PRODUCTION

1st 24 hrs. Nat. _____

1st 24 hrs. after shot _____

Gas _____ Cu. Ft.

Dry Hole _____

Abandoned _____

Date

7/3

191

6 Blair

Scout

Map No. _____ Sec. 8 Twp. 28 R. 4
 Well No. 13 R. 13 Farm _____
 _____ Company _____

NORTH

WEST

EAST

SOUTH

Location _____
 Rig Up _____
 Drilling and remarks _____

1800

RECORD

Cased _____ in. _____ Ft.
 Sand _____
 Gas _____
 Oil _____
 Total Depth _____

PRODUCTION

1st 24 hrs. Nat. _____
 1st 24 hrs. after shot _____
 Gas _____ Cu. Ft.
 Dry Hole _____
 Abandoned _____

Date


7/10, 1916 Scout Scout

Map No. _____ Sec. 8 Twp. 28 R. 4
 Well No. 13 Relston Farm _____
Engine Company _____

NORTH

WEST

EAST

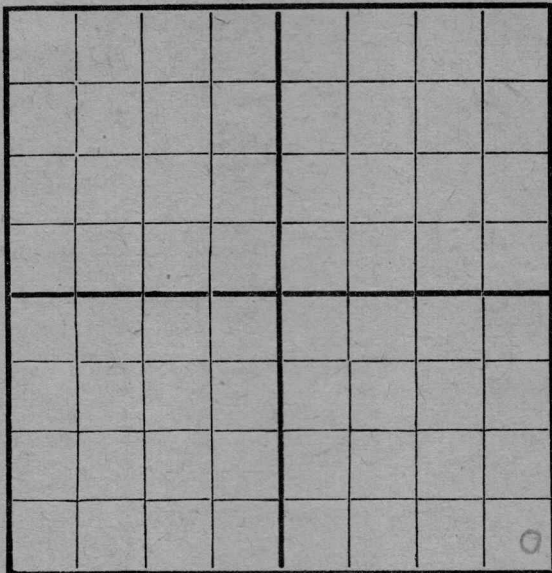

SOUTH

Location _____

Rig Up _____

Drilling and remarks

Top sand
2385.5 ft
will make
a good producer

RECORD

Cased _____ in. _____ Ft.

Sand _____

Gas _____

Oil _____

Total Depth _____

PRODUCTION

1st 24 hrs. Nat. _____

1st 24 hrs. after shot _____

Gas _____ Cu. Ft.

Dry Hole _____

Abandoned _____

Date

7/2/1916 Scout

Map No. _____ Sec. 8 Twp. 28 R. 4
 Well No. 13 Rals. Trm Farm _____
Empire Company _____

NORTH

WEST



EAST

SOUTH

Location _____

Rig Up _____

Drilling and remarks

Shut in

RECORD

Cased _____ in. _____ Ft.

Sand 2385-2390

Gas _____

Oil _____

Total Depth _____

PRODUCTION

1st 24 hrs. Nat. _____

1st 24 hrs. after shot _____

Gas _____ Cu. Ft.

Dry Hole _____

Abandoned _____

Date


7/26, 1916. L. O. O. O. O. Scout

Map No. _____ Sec. 8 Twp. 28 R. 4
 Well No. 13 Palston Farm _____
Empire Company _____

NORTH

WEST

EAST

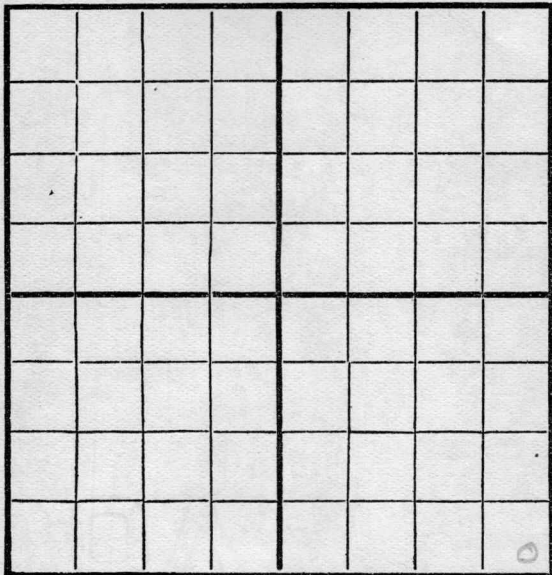

SOUTH

Location _____

Rig Up _____

Drilling and remarks

2385'

One top of
sand

RECORD

Cased _____ in. _____ Ft.

Sand _____

Gas _____

Oil _____

Total Depth _____

PRODUCTION

1st 24 hrs. Nat. _____

1st 24 hrs. after shot _____

Gas _____ Cu. Ft.

Dry Hole _____

Abandoned _____

Date

Aug 30 1916


L. C. C. C.

Scout

Map No. _____ Sec. 8 Twp. 28 R. 4
 Well No. 13 Ralston Farm _____
Engine Company _____

NORTH

WEST

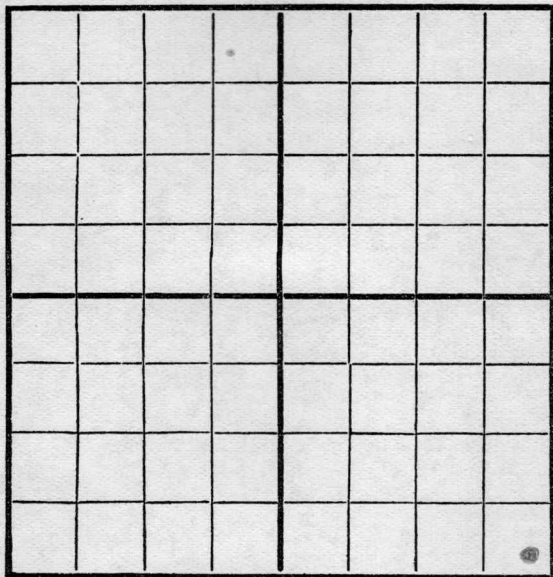

EAST

SOUTH

Location _____

Rig Up _____

Drilling and remarks

Same as reported7/26 1916Top sand

RECORD

Cased _____ in. _____ Ft.

Sand 2385

Gas _____

Oil _____

Total Depth _____

PRODUCTION

1st 24 hrs. Nat. _____

1st 24 hrs. after shot _____

Gas _____ Cu. Ft.

Dry Hole _____

Abandoned _____

Date

9/5, 1916 Scout Scout

Map No. _____ Sec. 8 Twp. 38 R. 4
 Well No. 13 Ralston Farm _____
Empire Company _____

NORTH

WEST

EAST

SOUTH

Location _____

Rig Up _____

Drilling and remarks

*On top
 sand at
 2385*

RECORD

Cased _____ in. _____ Ft.

Sand _____

Gas _____

Oil _____

Total Depth _____

PRODUCTION

1st 24 hrs. Nat. _____

1st 24 hrs. after shot _____

Gas _____ Cu. Ft.

Dry Hole _____

Abandoned _____

Date

9/12, 1916 Looney Scout _____


Map No. Sec. 8 Twp. 6 R.

Well No 13 Palatin Farm

Empire Company

NORTH

WEST

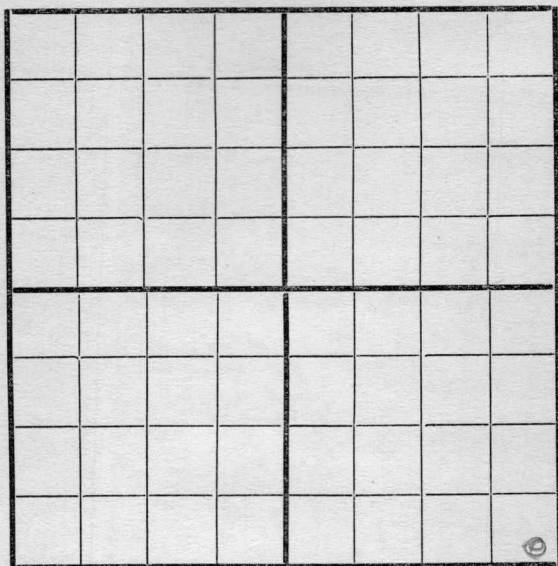

EAST

SOUTH

Location

Rig Up

Drilling and remarks

Top sand

RECORD

Cased in Ft.

Sand 2385

Gas

Oil

Total Depth

PRODUCTION

1st 24 hrs. Nat.

1st 24 hrs. after shot

Gas Cu. Ft.

Dry Hole

Abandoned

Date

9/20, 1916. A. A. R. Scout

Map No. _____ Sec. 8 Twp. 28 R. 4Well No. 13 Palmetto Farm __________Empire Company _____

NORTH

WEST

EAST

SOUTH

Location _____

Rig Up _____

Drilling and remarks

Dry sand
2385

RECORD

Cased _____ in. _____ Ft.

Sand _____

Gas _____

Oil _____

Total Depth _____

PRODUCTION

1st 24 hrs. Nat. _____

First 24 hrs. after shot _____

Gas _____ Cu. Ft.


Dry Hole _____

Abandoned _____

Date

9/27 1916 Scout

Map No. _____ Sec. 8 Twp. 28 R. 4
 Well No. 13 Rolston Farm _____
Empire Company _____
 NORTH

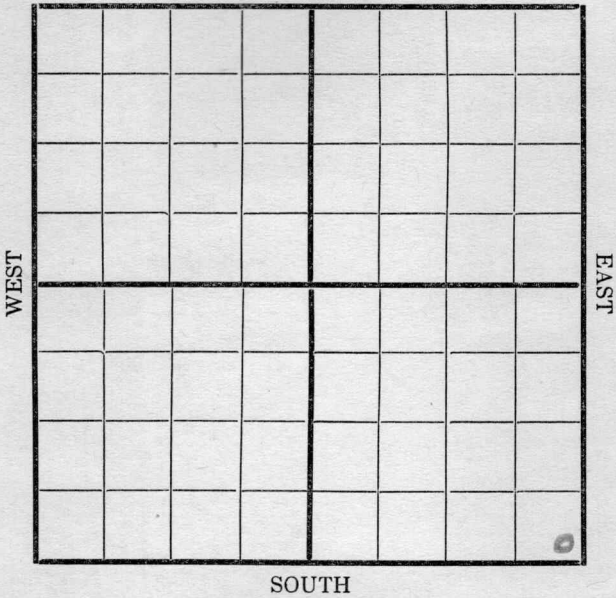


Location _____ Rig Up _____ Drilling and remarks <u>Drilling</u> <u>in</u>	RECORD
	Cased _____ in. _____ Ft.
	Sand _____
	Gas _____
	Oil _____
	Total Depth _____
	PRODUCTION
	1st 24 hrs. Nat. _____
	1st 24 hrs. after shot _____
	Gas _____ Cu. Ft.
	Dry Hole _____
	Abandoned _____

Date 10/2, 1916 W. C. Carr Scout

Map No. _____ Sec. 8 Twp. 28 R. 4
 Well No. 13 Polston Farm
Engine Company

NORTH

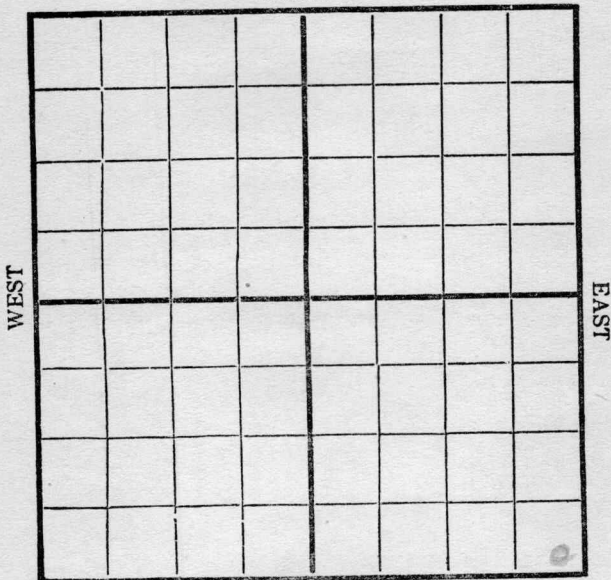

SOUTH

Location _____

Rig Up _____

Drilling and remarks

Top sand
Preparing to
fill in

RECORD

Cased _____ in. _____ Ft.

Sand 2390-

Gas _____

Oil _____

Total Depth _____

PRODUCTION

1st 24 hrs. Nat. _____

First 24 hrs. after shot _____

Gas _____ Cu. Ft.

Dry Hole _____


Abandoned _____

Date

10/9, 191 6 Scout

Map No. _____ Sec. 8 Twp. 28 R. 4
 Well No. 13 Ralston Farm _____
Empire Company _____

NORTH

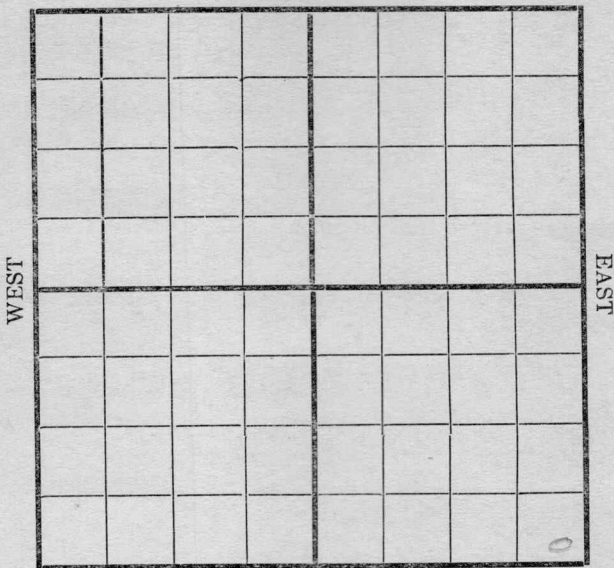

SOUTH

Location _____
 Rig Up _____
 Drilling and remarks _____

Top sand

RECORD

Cased _____ in. _____ Ft.
 Sand _____
 Gas _____
 Oil _____
 Total Depth _____

PRODUCTION

1st 24 hrs. Nat. _____
 1st 24 hrs. after shot _____
 Gas _____ Cu. Ft.
 Dry Hole _____
 Abandoned _____

Date


10/17 1916 Scout

Map No. _____ Sec. 8 Twp. 28 R. 4
 Well No. 13. Pelton Farm _____
Pumpkin Company _____

NORTH

WEST

EAST

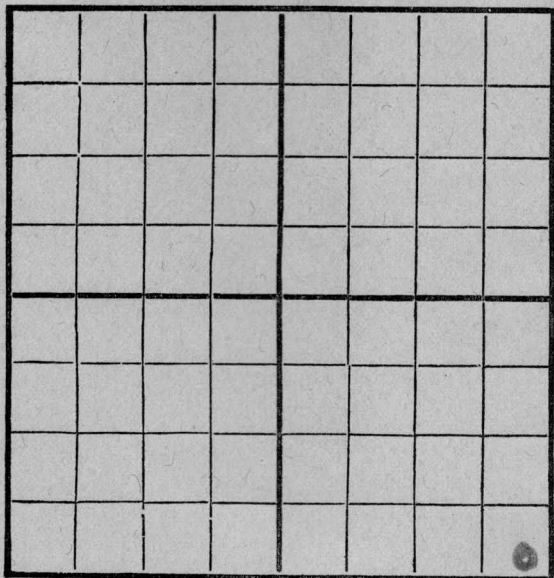

SOUTH

Location _____

Rig Up _____

Drilling and remarks

Tap sand
2385

RECORD

Cased _____ in. _____ Ft.

Sand _____

Gas _____

Oil _____

Total Depth _____

PRODUCTION

1st 24 hrs. Nat. _____

First 24 h. s. after shot _____

Gas _____ Cu. Ft.

Dry Hole _____


Abandoned _____

Date

1892 191 *6* *Scout*

Map No. _____ Sec. 8 Twp. 28 R. 4
 Well No. 13 Palston Farm
Engine Company

NORTH

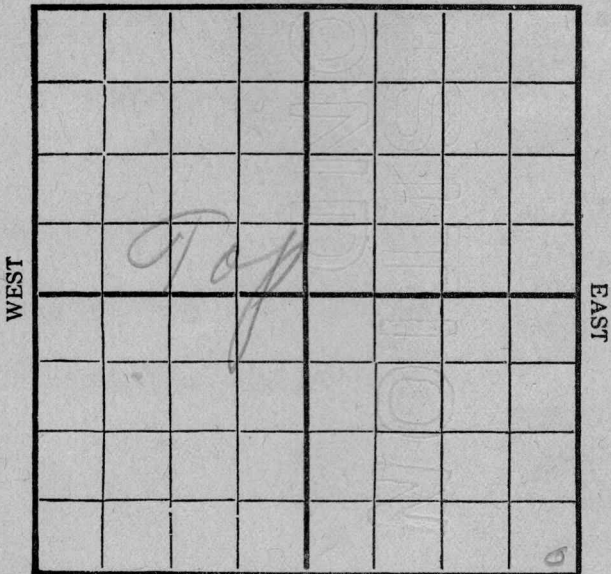

SOUTH

Location _____
 Rig Up _____
 Drilling and remarks

Reamed

RECORD

Cased _____ in. _____ Ft.
 Sand 2390
 Gas _____
 Oil _____
 Total Depth _____

PRODUCTION

1st 24 hrs. Nat. _____
 First 24 h.s. after shot _____
 Gas _____ Cu. Ft.
 Dry Hole _____
 Abandoned _____

Date

10/30, 1916 Alford Scout

Map No. _____ Sec. 8 Twp. 28 R. 4Well No. 13 Ralston Farm _____
Angelo Company _____

NORTH

WEST



EAST

SOUTH

Location _____

Rig up _____

Drilling and remarks

Top sand

RECORD

Cased _____ in. _____ Ft.

Sand 2385

Gas _____

Oil _____

Total Depth _____

PRODUCTION

1st. 24 hrs. Nat. _____

1st 24 hrs. after shot _____

Gas _____ Cu. Ft.

Dry Hole _____


Abandoned _____

Date

_____, 191____, _____ Scout

Map No. _____ Sec. 8 Twp. 28 R. 4Well No. 13 Robinson FarmEmpire Company

NORTH

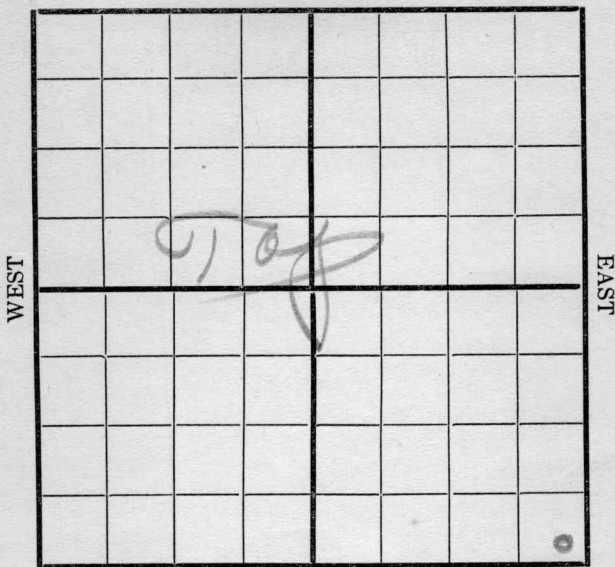

SOUTH

Location _____

Rig Up _____

Drilling and remarks

Shut Down
on top sand
2390'

RECORD

Cased _____ in. _____ Ft.

Sand _____

Gas _____

Oil _____

Total Depth _____

PRODUCTION

1st 24 hrs. Nat. _____

1st 24 hrs. after shot _____

Gas _____ Cu. Ft.

Dry Hole _____

Abandoned _____


Date

11/9, 1916 Robinson Scout

Map No. _____ Sec. 8 Twp. 28 R. 4Well No. 13 Ralsam Farm_____ Empire Company

NORTH

WEST

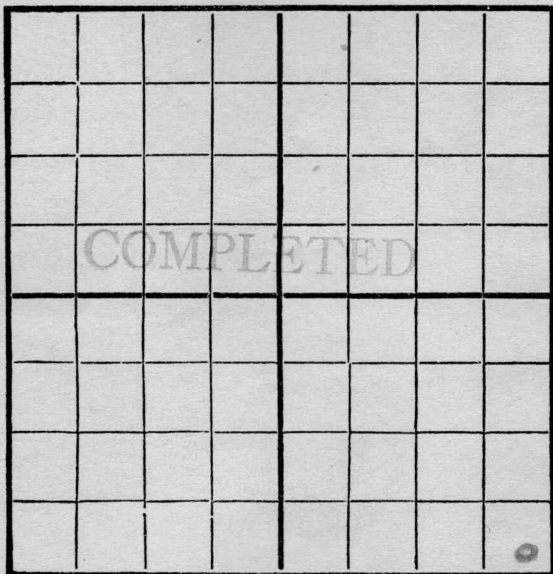

EAST

SOUTH

Location _____

Rig Up _____

Drilling and remarks

*Estimated
good for 60
bbls*

RECORD

Cased _____ in. _____ Ft.

Sand 2385-2407

Gas _____

Oil _____

Total Depth _____

PRODUCTION

1st 24 hrs. Nat. _____

First 24 hrs. after shot _____

Gas _____ Cu. Ft.

Dry Hole _____

Abandoned _____

Date

11/14, 191 6 Carroll Scout